
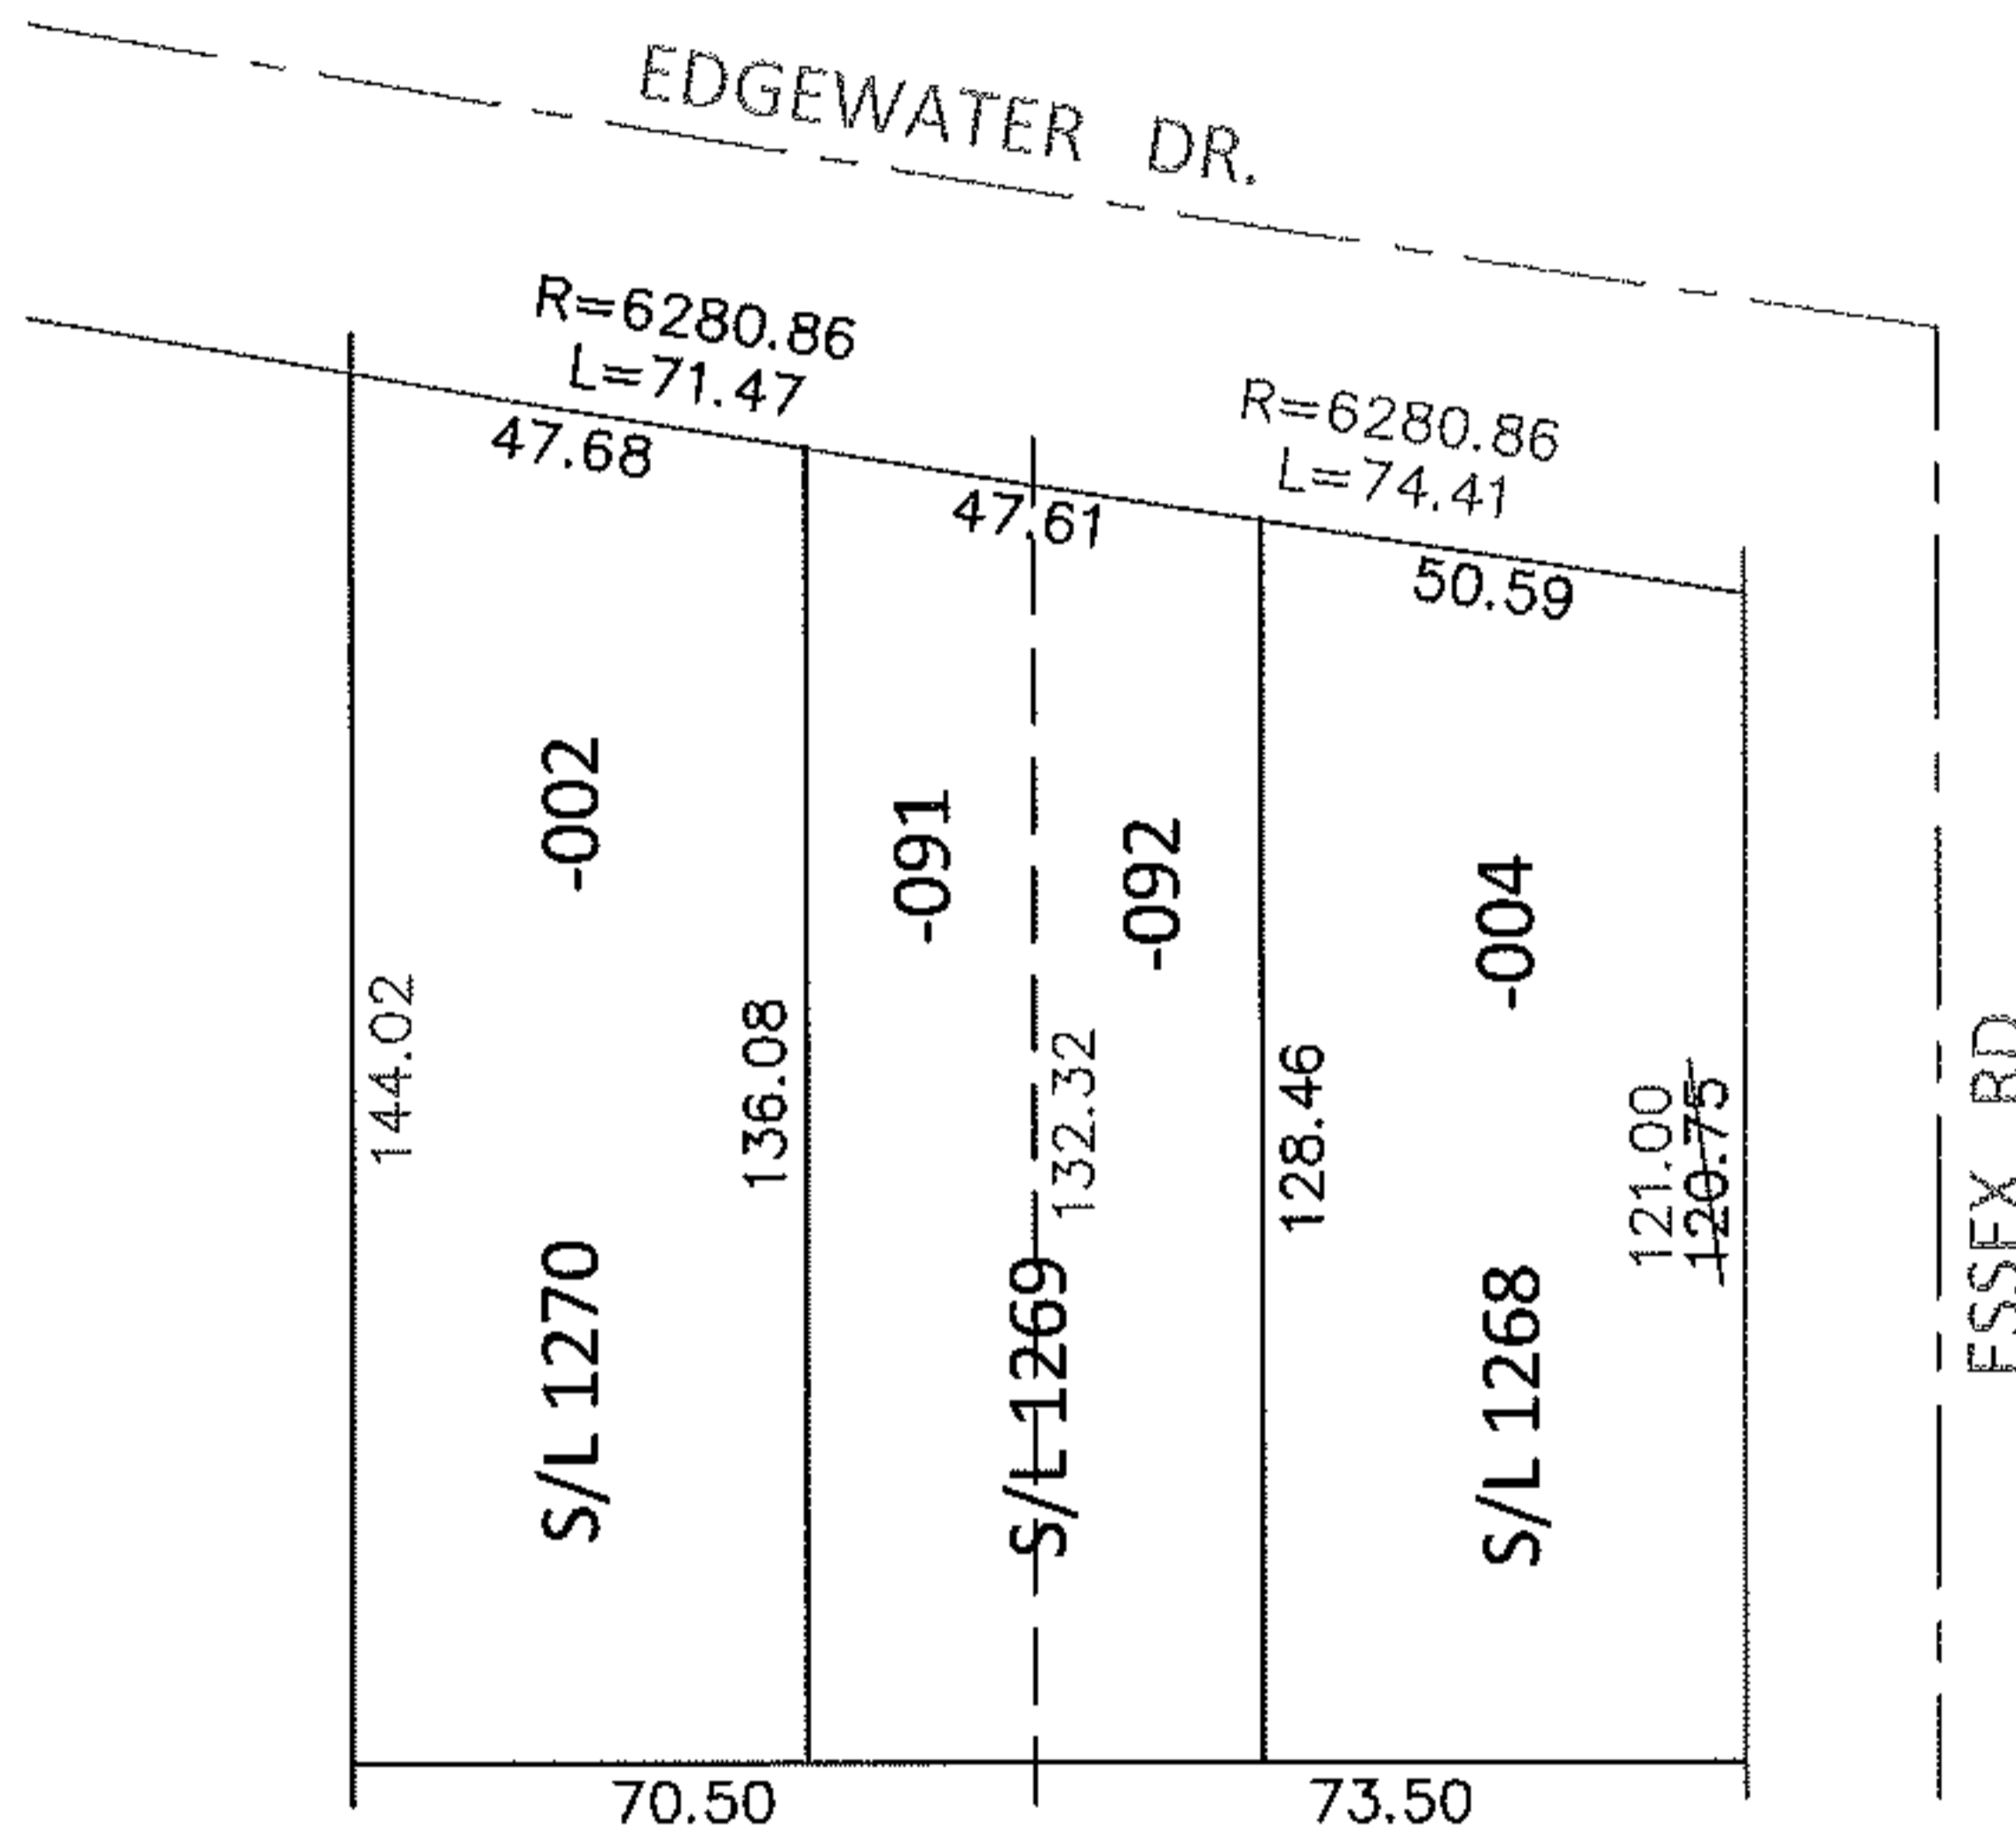


PARENT PARCEL: 01-00-002-108-002, -004, -091, -092

CHILD PARCEL:

13-02817-C


STARTING POINT: NORTHEAST CORNER OF S/L 1268 IN VERMILION ON THE LAKE SUB. NO.1 (VOL. 10 PG. 18)

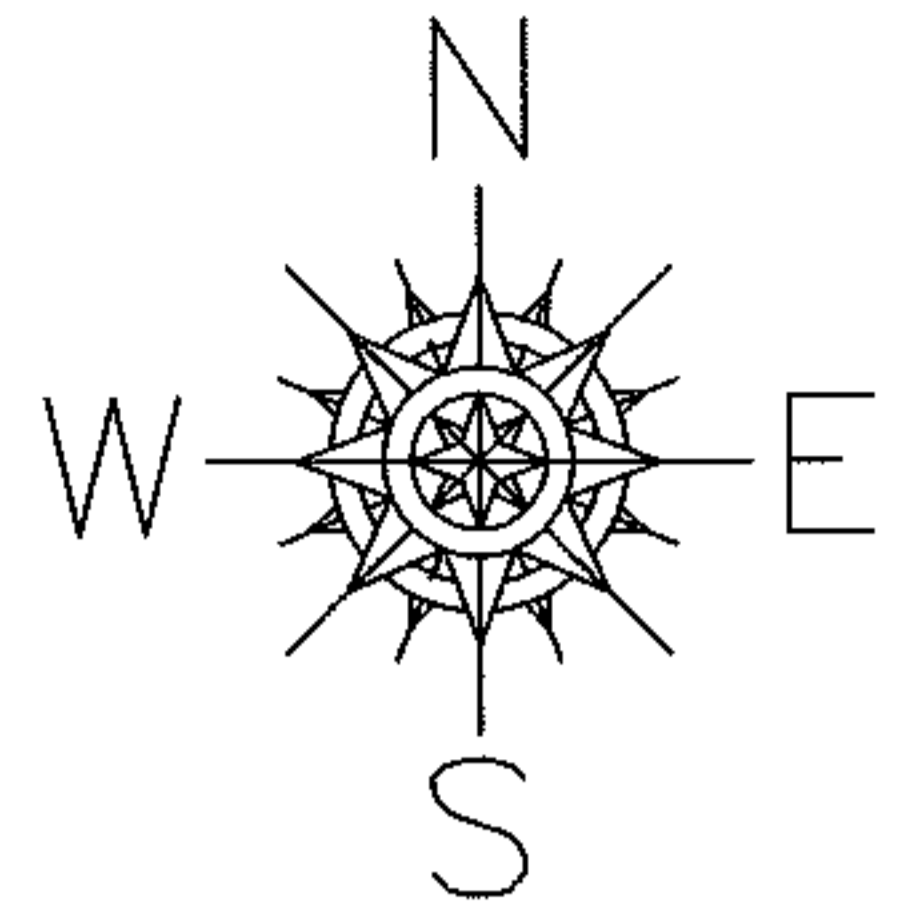

FRONTAGE AND DEPTH CORRECTION

01-00-002-108-002	01-00-002-108-091
144.02	23.79 X 136.08
47.68 X <del>144</del>	<del>23.50 X 132.32</del>
01-00-002-108-004	01-00-002-108-092
50.59 X 128.46	23.82
<del>50.95 X -----</del>	<del>23.50 X 132.32</del>

PER PRIOR DEEDS

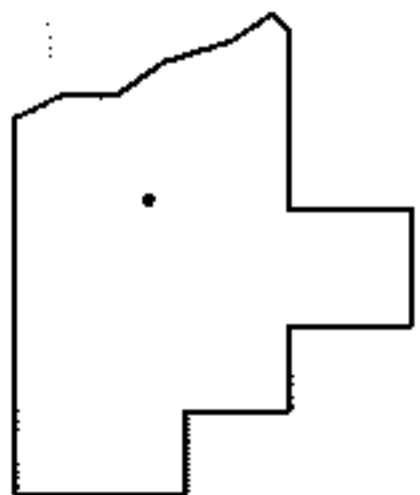

SPLITS/DEEDS PROCESSED

LORAIN COUNTY TAX MAP DEPARTMENT  
226 MIDDLE AVE. ELYRIA, OHIO

SURVEYED BY: N/A  
 CLOSURE: .01:10,000  
 MAP PAGE(S): 1-00-002-B  
 APPROVED BY: RRM DATE: 10-7-13  
 SCALE: 1"= 50' PRIOR INST.: 20020859884