
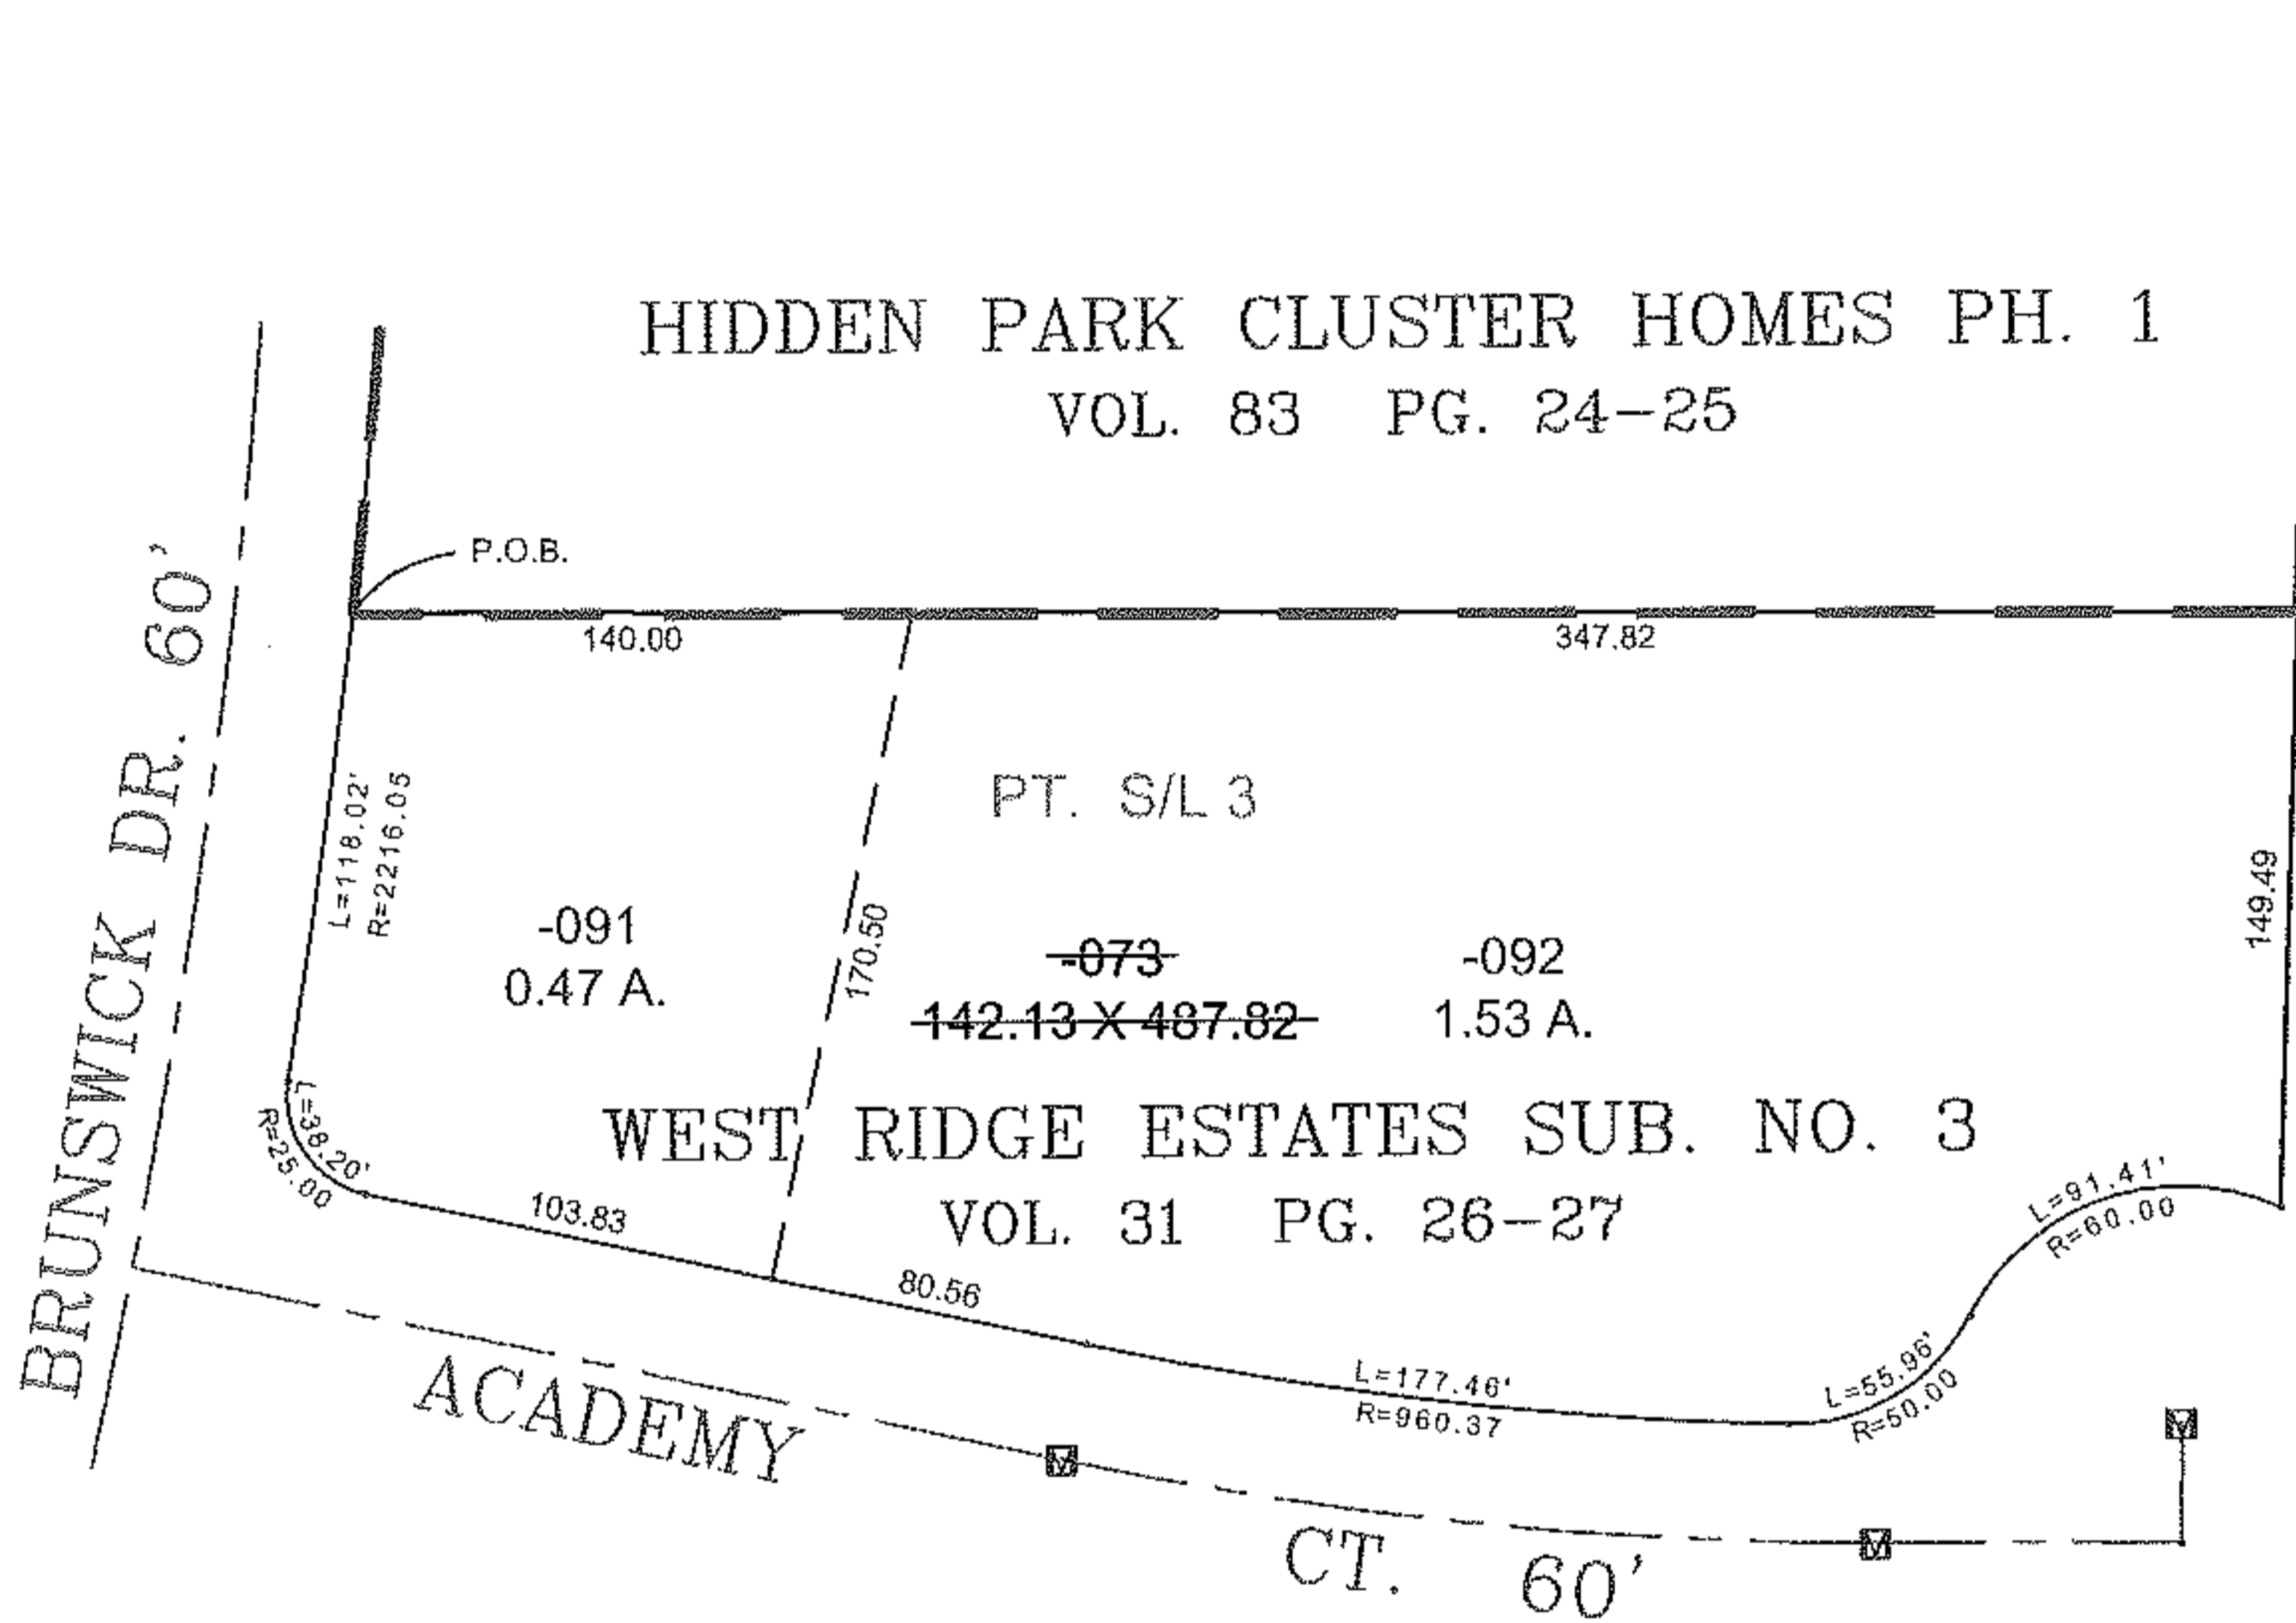


PARENT PARCEL: 06-24-003-104-073

CHILD PARCEL: 06-24-003-104-091 & -092

STARTING POINT: I.P. FD., S.W. CORNER OF HIDDEN PARK CLUSTER HOMES PH. 1

NO. 10-02817

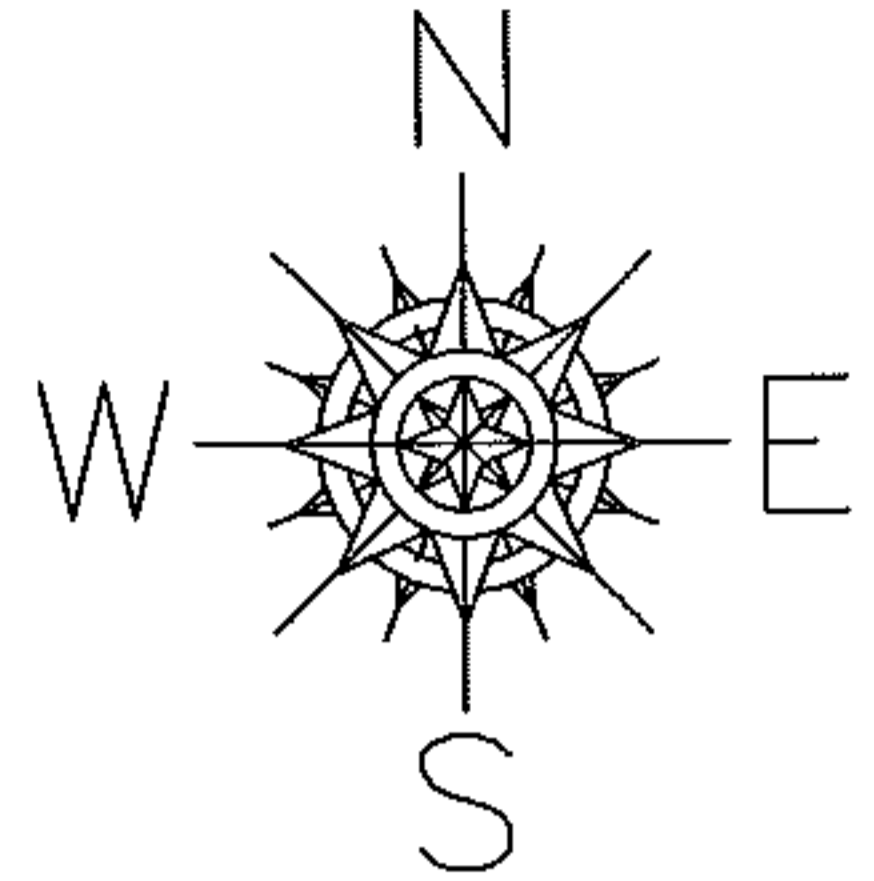

Raster

SPLITS/DEEDS PROCESSED

LORAIN COUNTY TAX MAP DEPARTMENT
226 MIDDLE AVE. ELYRIA, OHIO

SURVEYED BY: DALE R. HAYWOOD

CLOSURE: 0.01 : 10.000

MAP PAGE(S): 6-110

APPROVED BY: TJS DATE: 3/29/10

SCALE: 1" = 100 PRIOR INSTRUMENT: DV 1242/163