
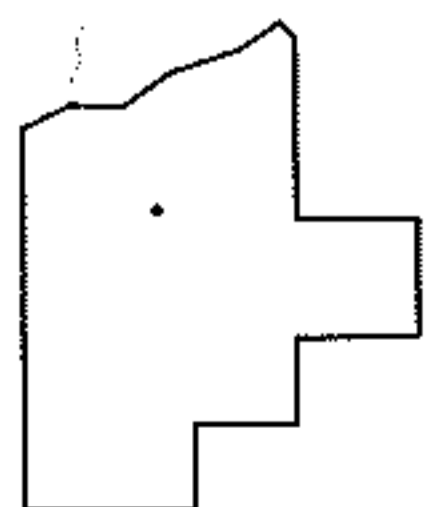
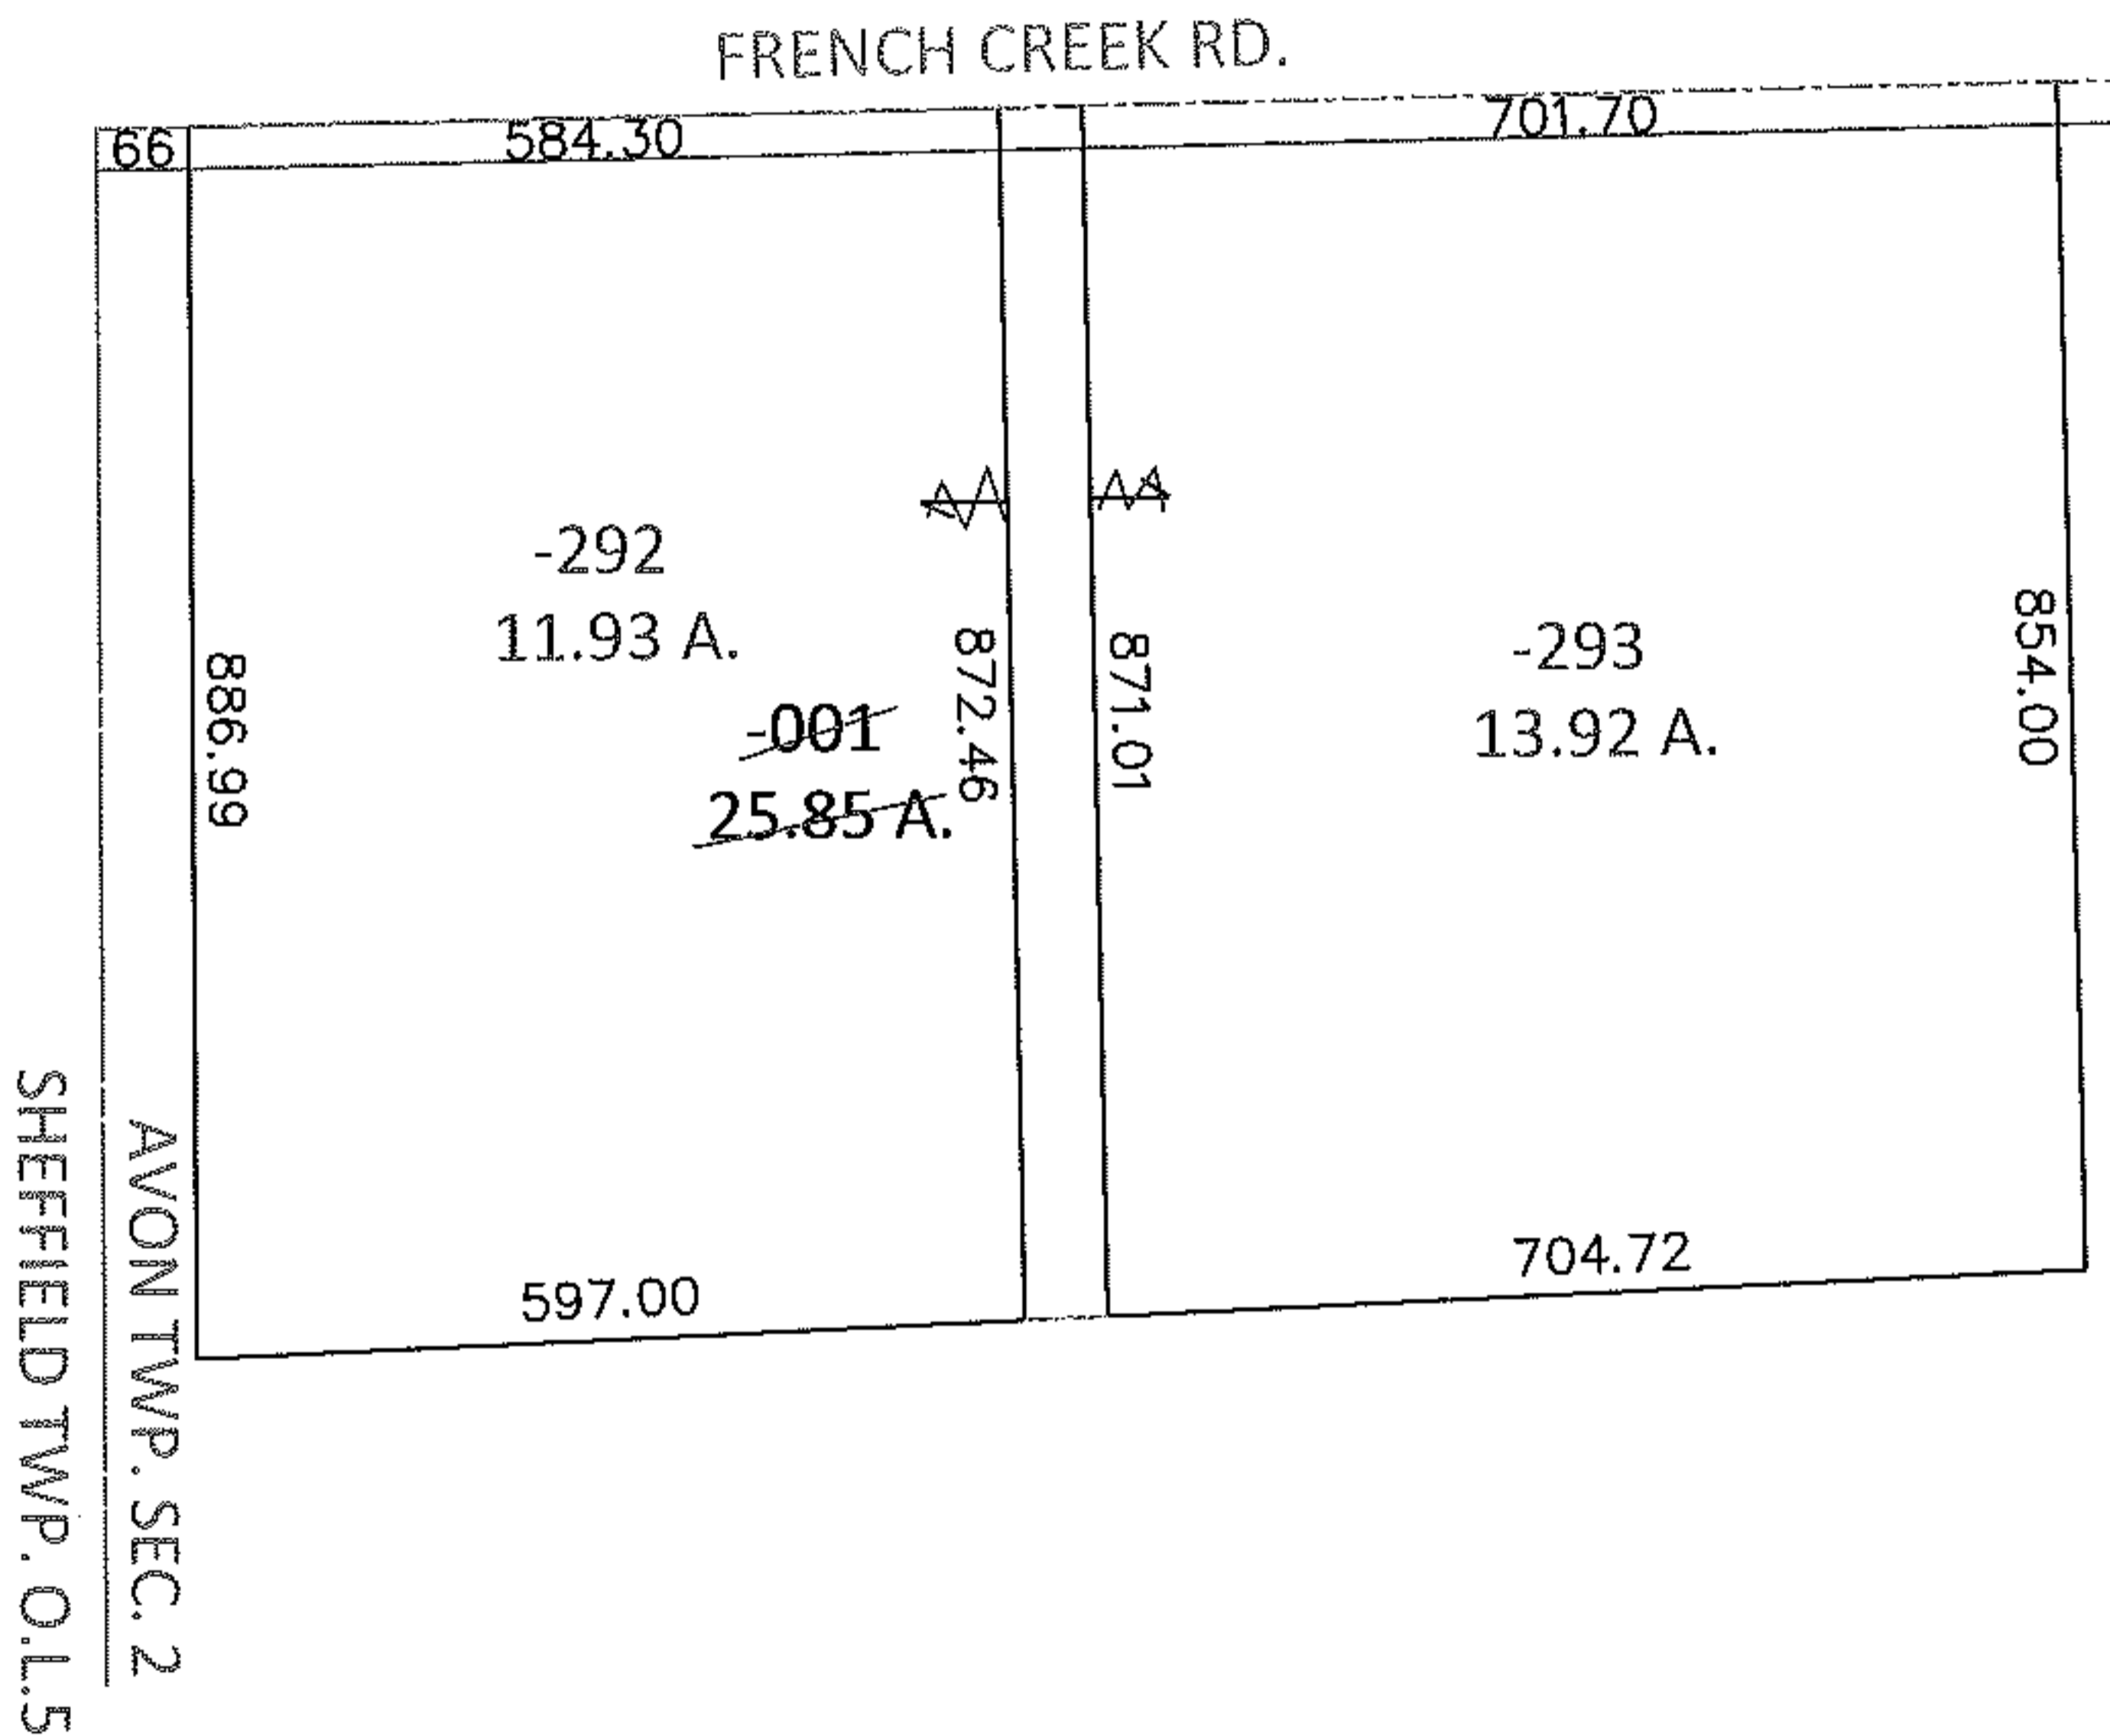


PARENT PARCEL: 04-00-002-101-001

CHILD PARCEL: 04-00-002-101-292, -293

10-02820

STARTING POINT: AT A MON BOX AT THE INTERSECTION OF C/L OF FRENCH CREEK RD.  
AND THE WEST LINE OF SEC. 2

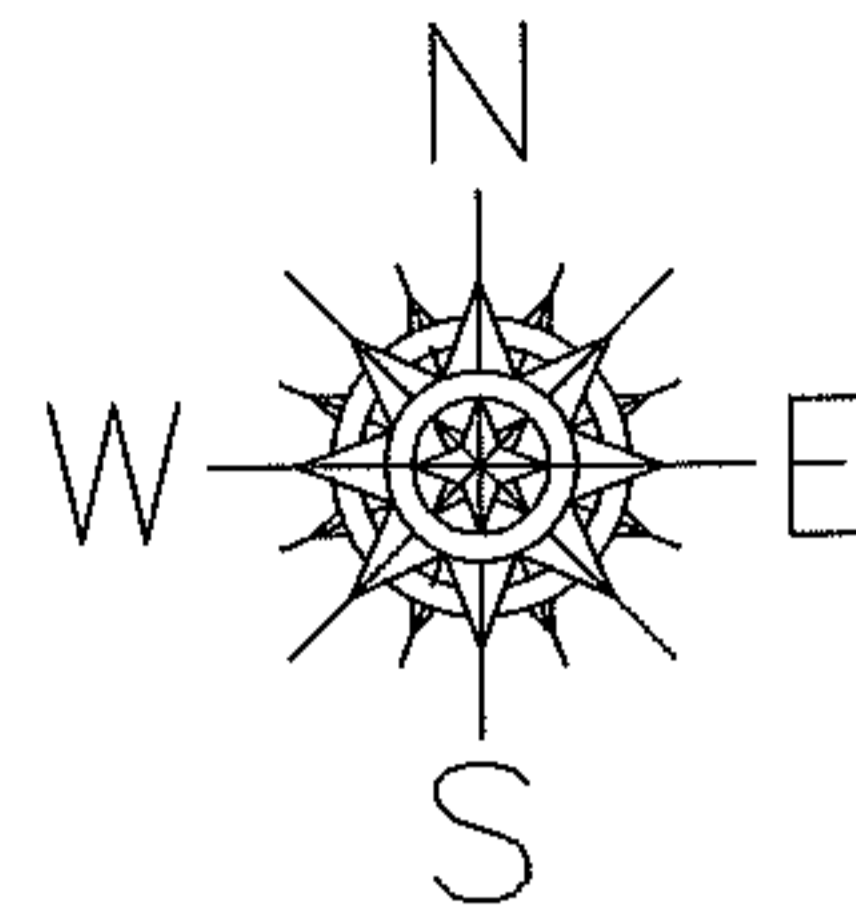

**SPLITS/DEEDS PROCESSED**

LORAIN COUNTY TAX MAP DEPARTMENT  
226 MIDDLE AVE. ELYRIA, OHIO

SURVEYED BY: DANE A. HAPONER

CLOSURE: .01:10,000

MAP PAGE(S): 4-00-002-A

APPROVED BY: RRM      DATE: 4/7/10

SCALE: 1"= 300      PRIOR INST.: 970482485

*RACED*