
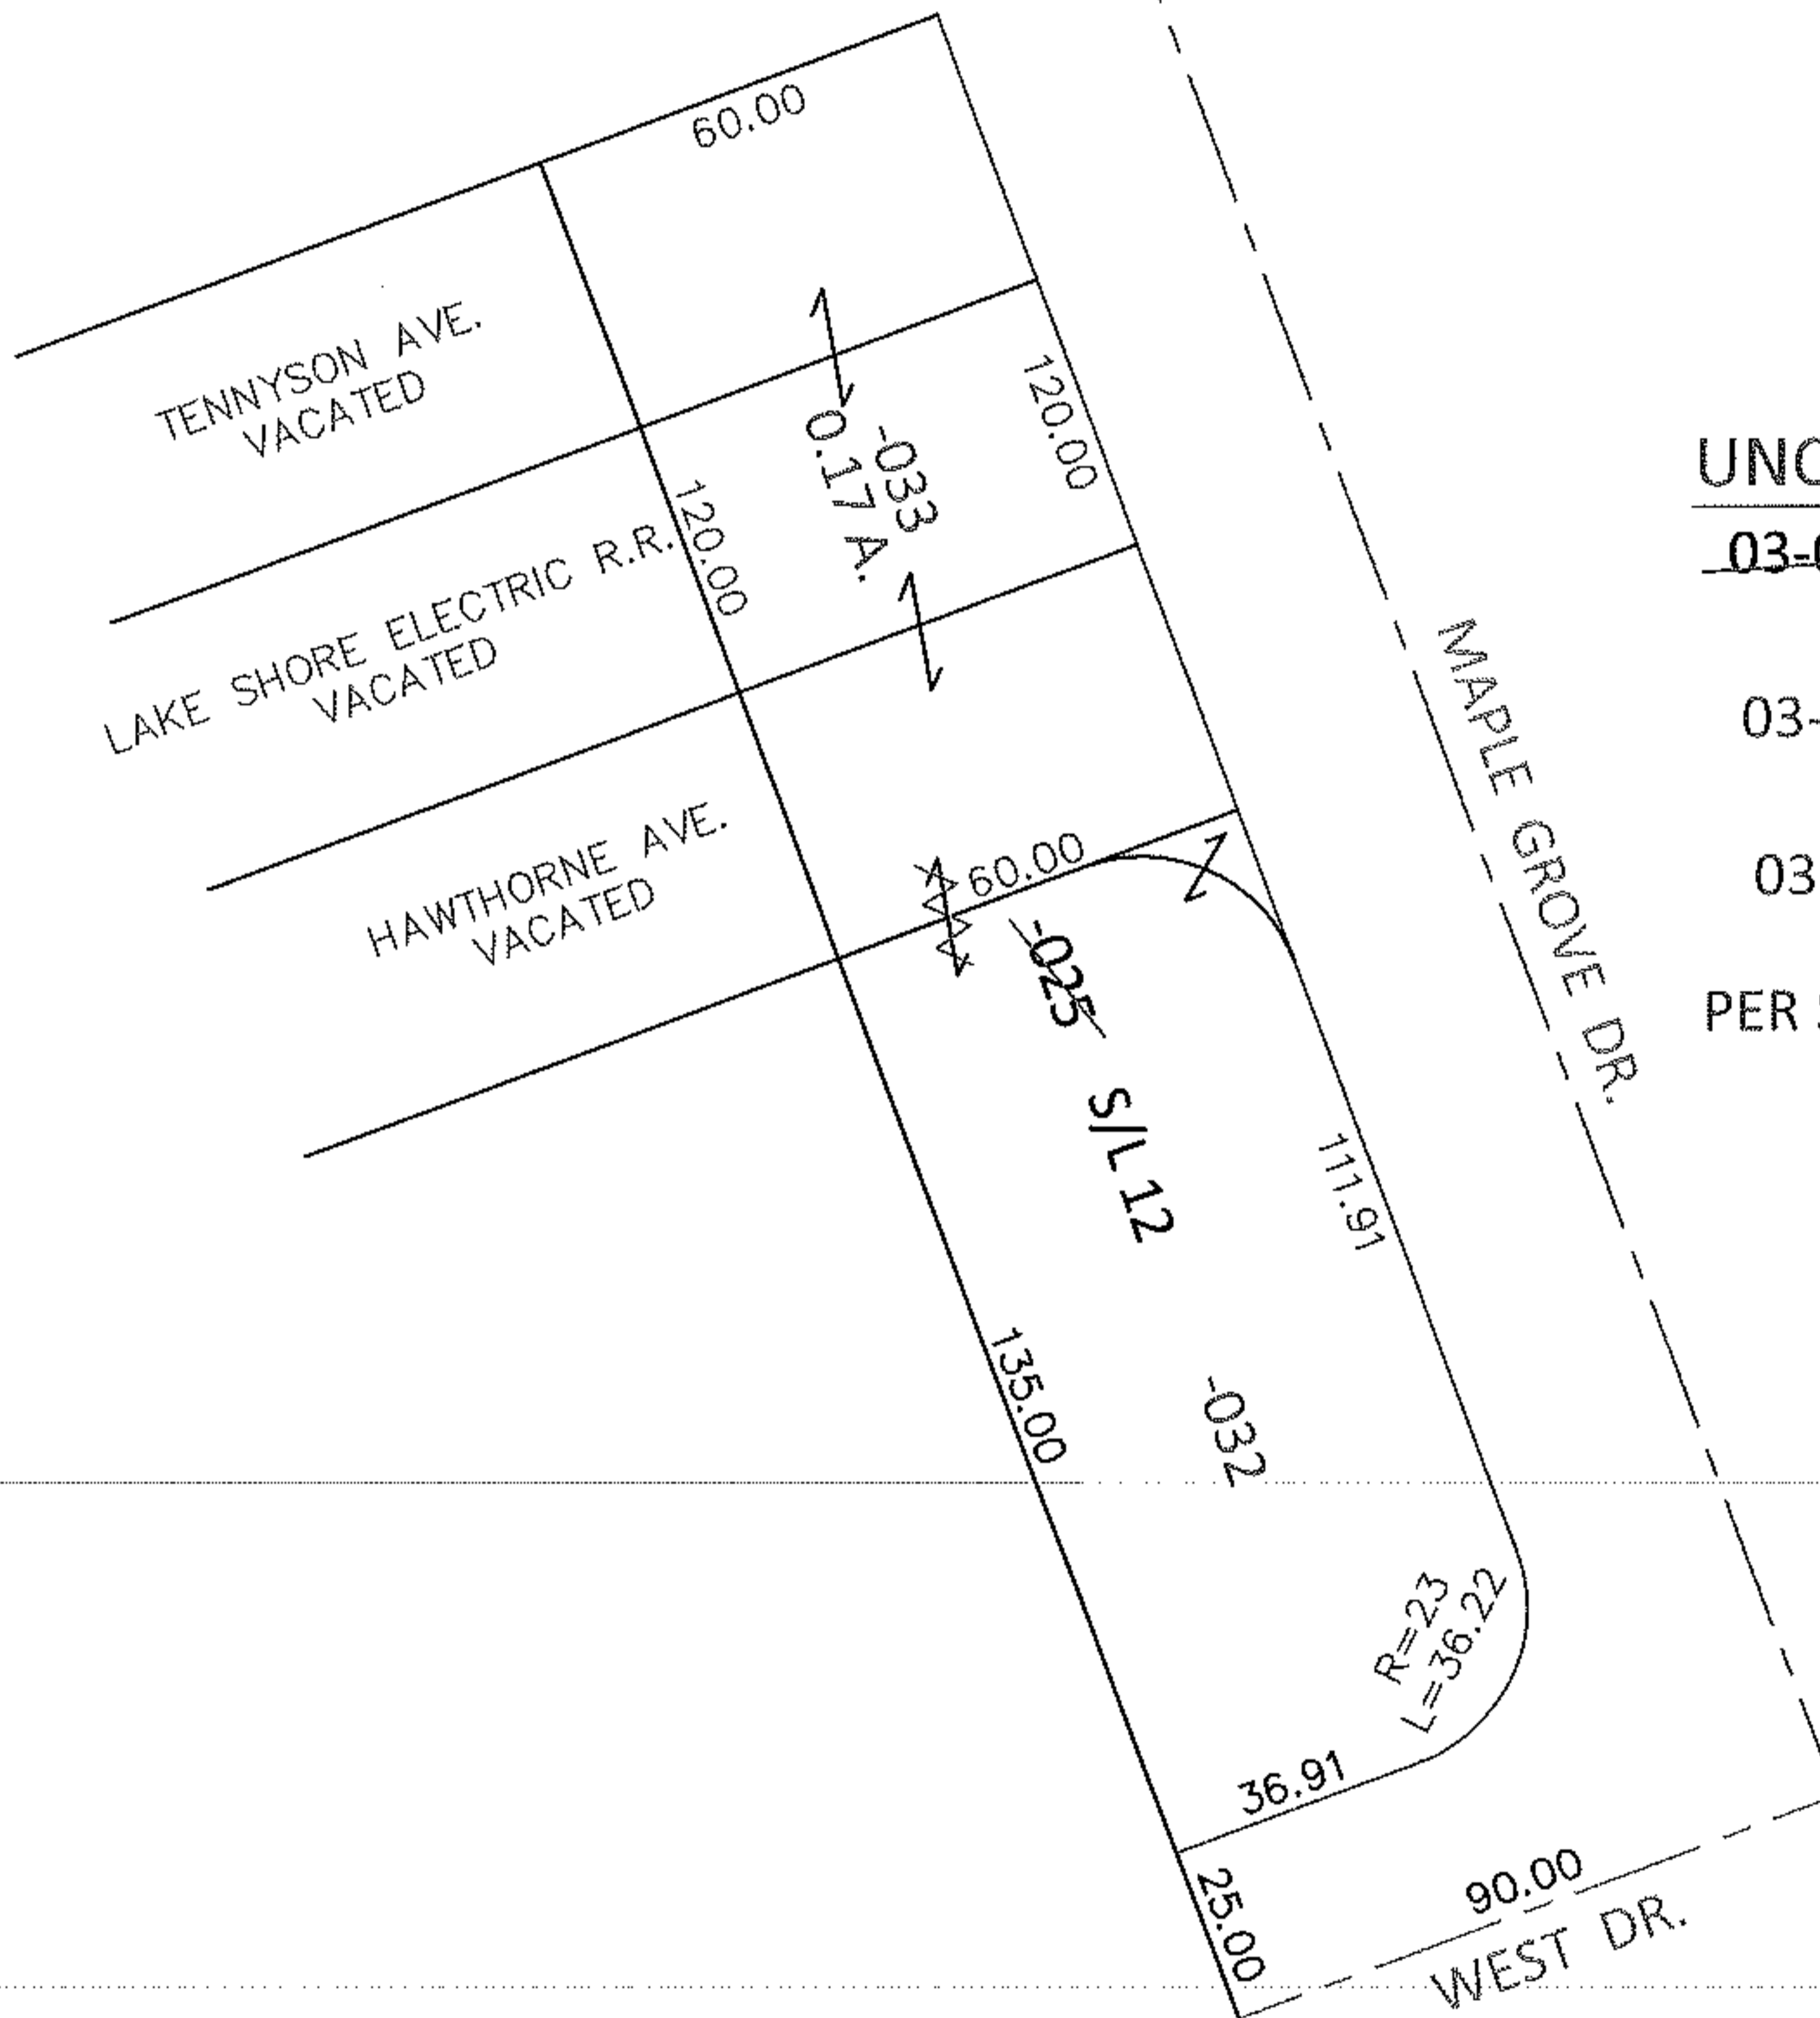


PARENT PARCEL: 03-00-043-105-025

CHILD PARCEL: 03-00-043-105-032, -033

13-02822-X

STARTING POINT: INTERSECTION OF S/L OF MAPLE GROVE DR. AND C/L OF WEST DR.

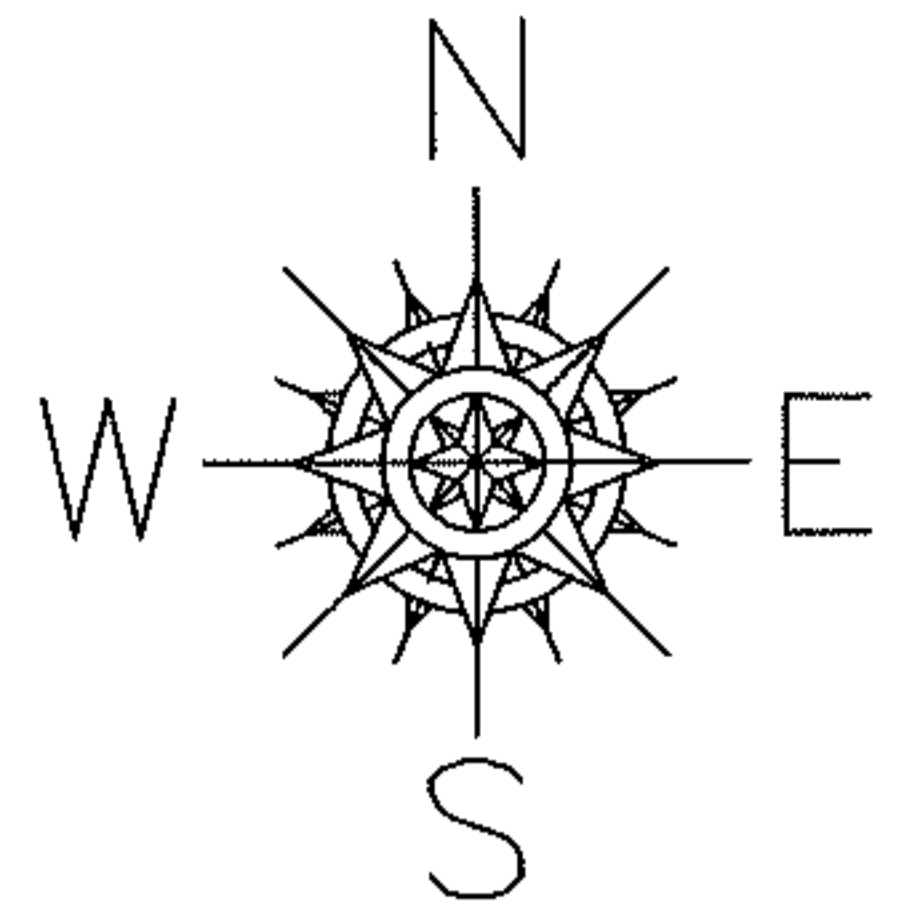


**UNCOMBINATION**

~~03-00-043-105-025~~  
~~120 X 135~~

03-00-043-105-032  
60 X 135

03-00-043-105-033  
0.17 A.

PER SURV. W. BARBOSA

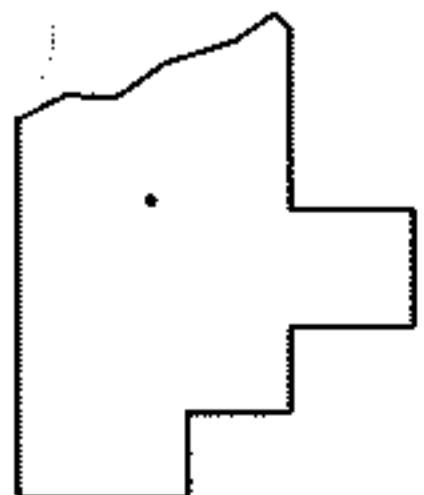

**SPLITS/DEEDS PROCESSED**

LORAIN COUNTY TAX MAP DEPARTMENT  
226 MIDDLE AVE. ELYRIA, OHIO

SURVEYED BY: WILFREDO BARBOSA

CLOSURE: .01:10,000

MAP PAGE(S): 3-00-043

APPROVED BY: RRM DATE: 10-18-13

SCALE: 1" = 50' PRIOR INST.: 20120412842