
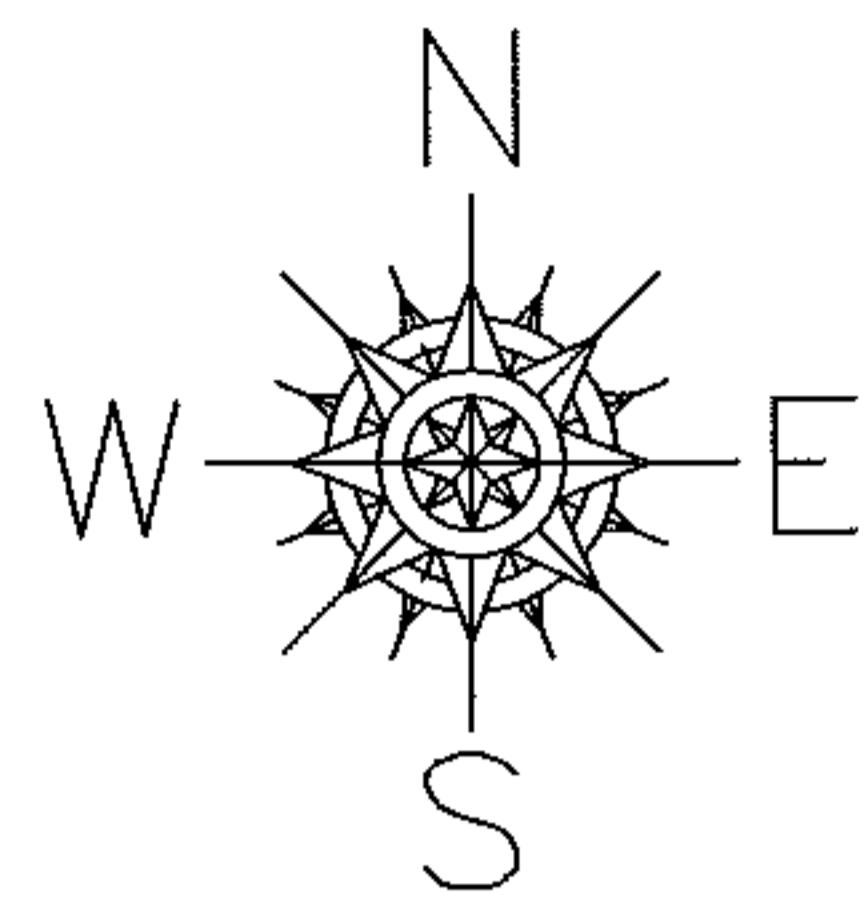


PARENT PARCEL: 18-00-018-000-004, -005, -006, 18-00-017-000-001
 CHILD PARCEL: 18-00-018-000-024 THRU -026, 18-00-016-000-068 18-00-017-000-012
 STARTING POINT: CENTERLINE OF PECK-WADSWORTH RD & HAWLEY RD

10-02824

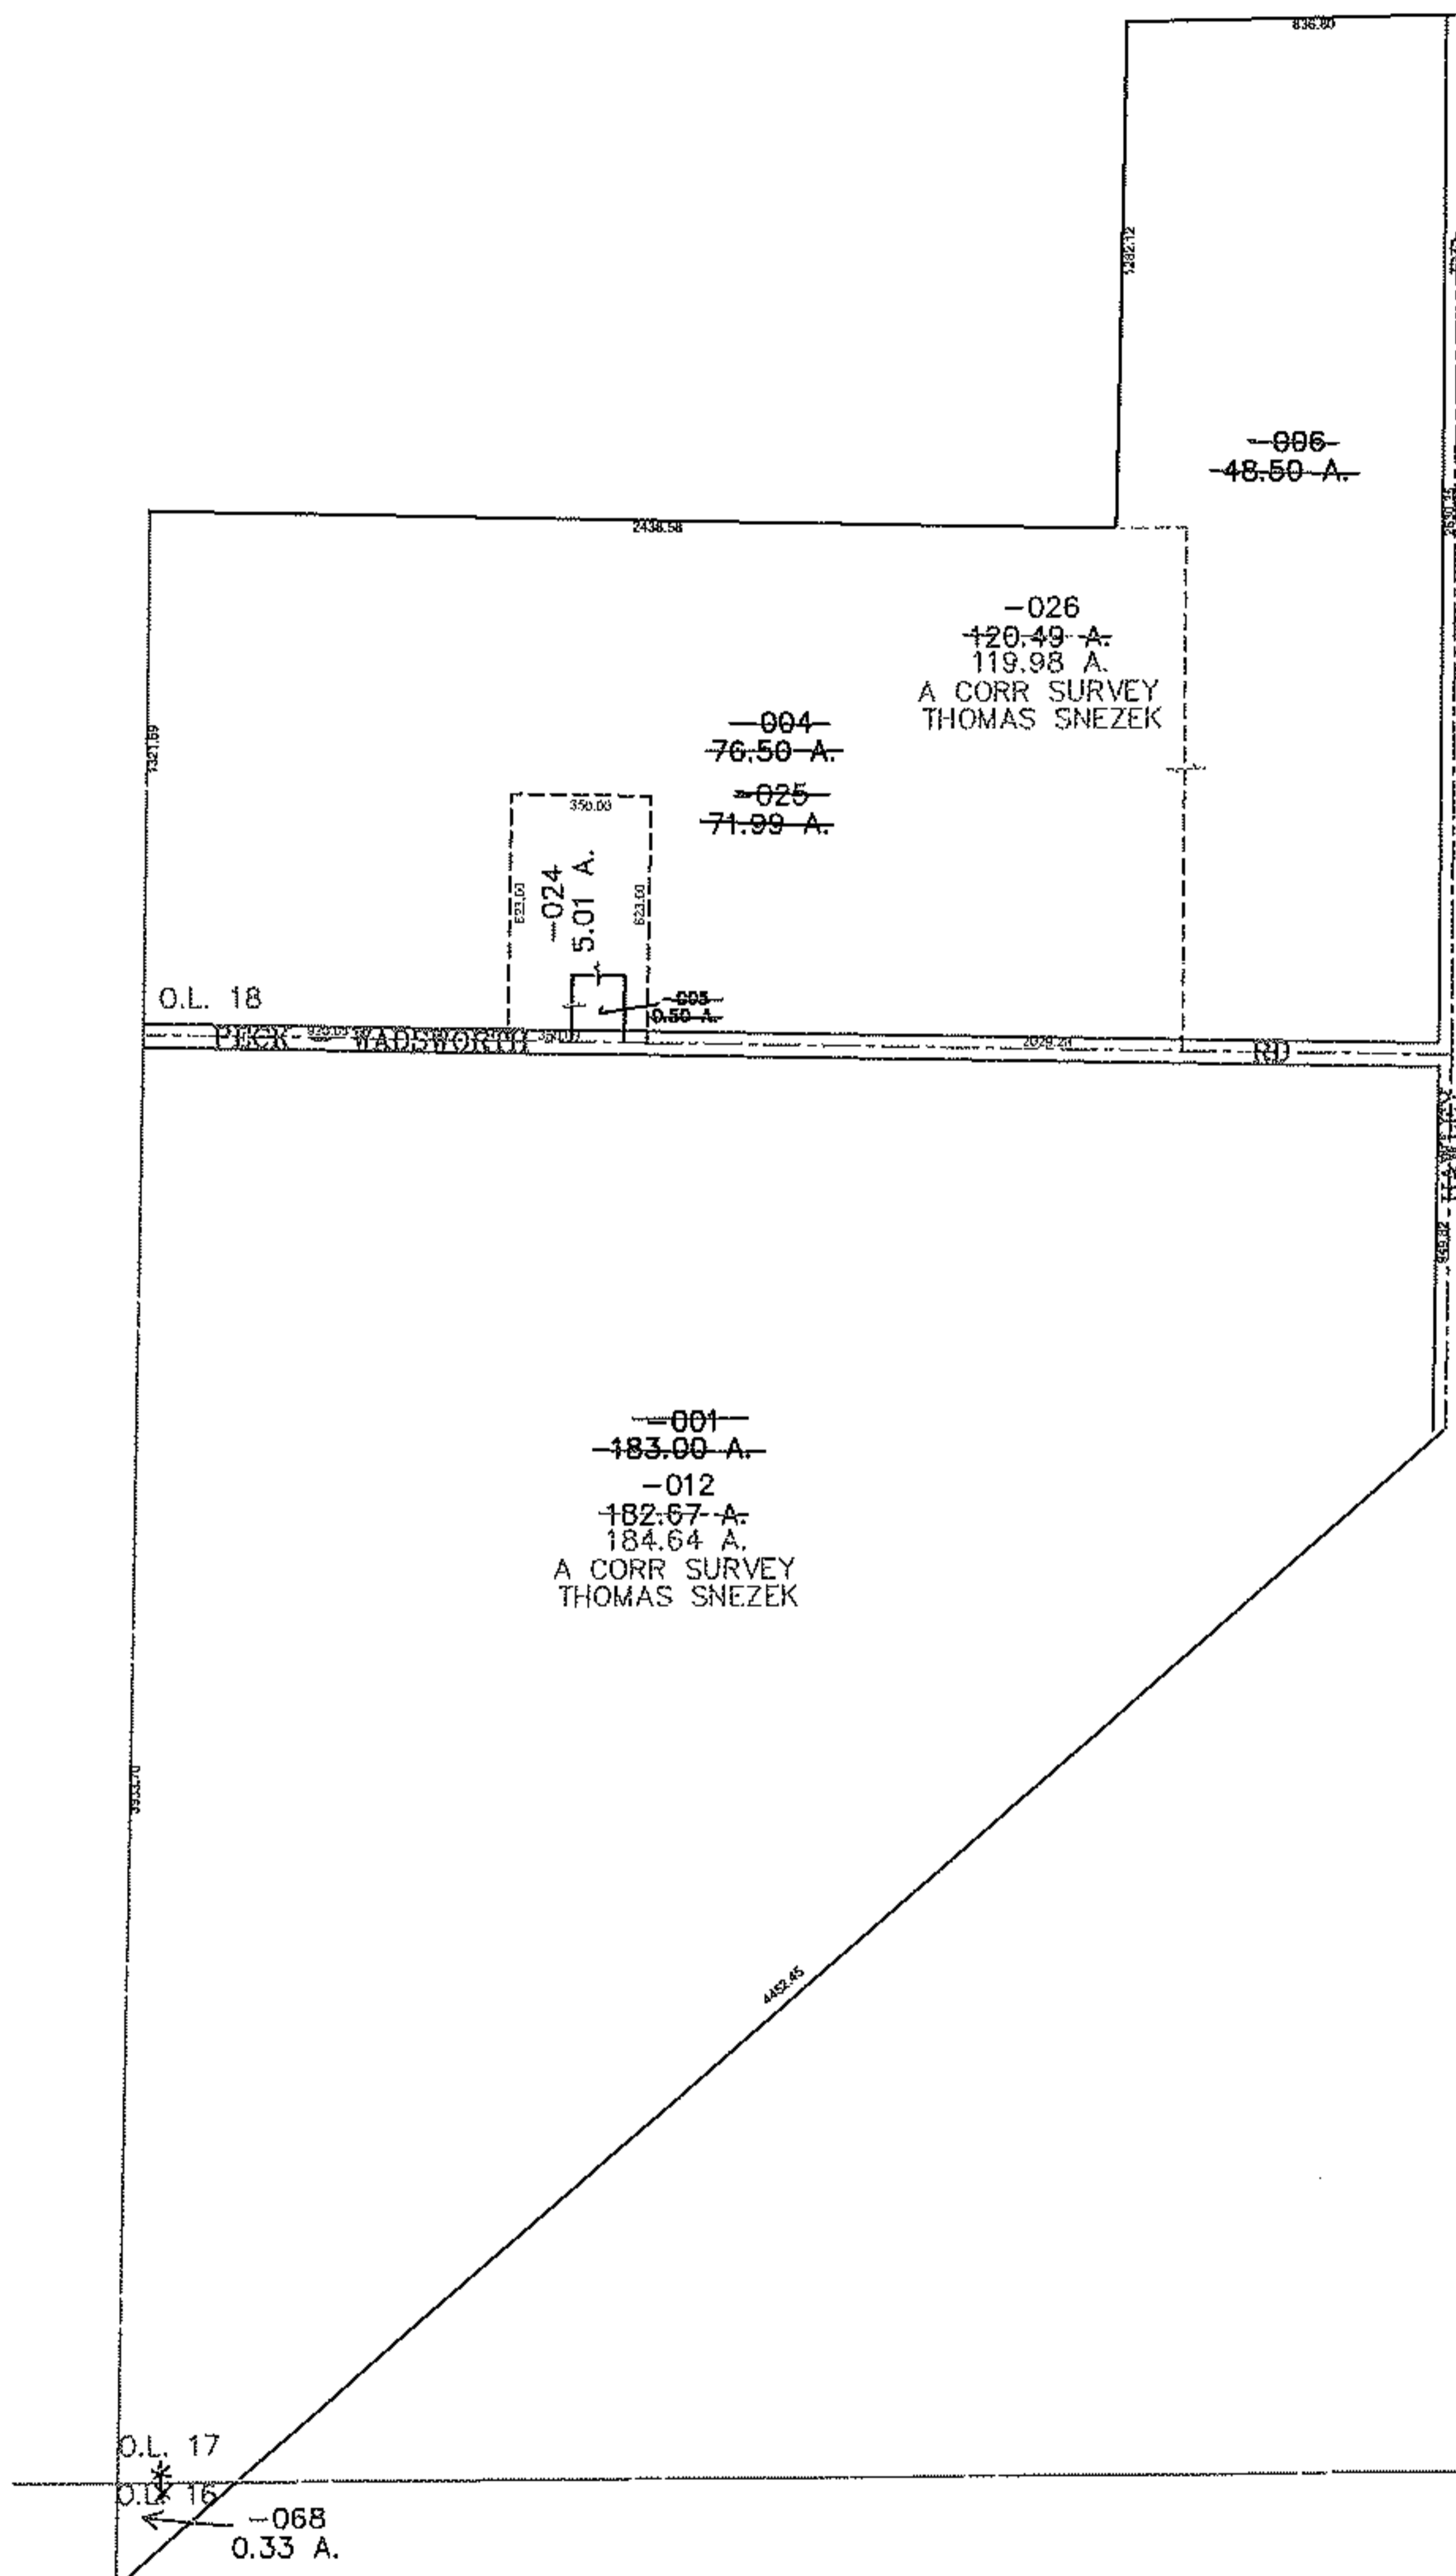

SPLITS/DEEDS PROCESSED
 LORAIN COUNTY TAX MAP DEPARTMENT
 226 MIDDLE AVE. ELYRIA, OHIO

SURVEYED BY: THOMAS SNEZEK
 CLOSURE: 0.00 : 10,000
 MAP PAGE(S): 18-C
 APPROVED BY: JAH DATE: 4-19-2010
 SCALE: 1" = 800 PRIOR INSTRUMENT: 20020857569