


PARENT PARCEL: 16-00-003-101-002, 16-00-004-000-001

CHILD PARCEL: _____



STARTING POINT: NORTHEAST CORNER OF CHESAPEAKE CROSSING SUB.

13-02826-D

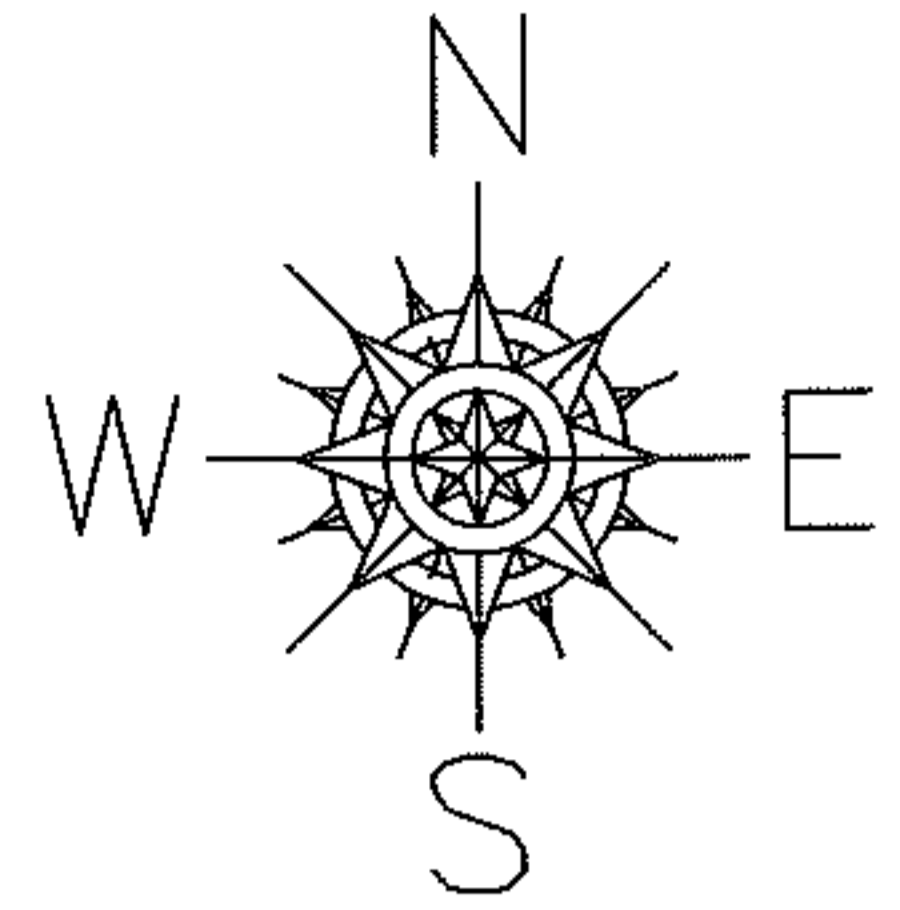

EATON TWP.
GRAFTON TWP. 1667.54

CHESAPEAKE CROSSING SUB.
VOL. 62 PG. 75

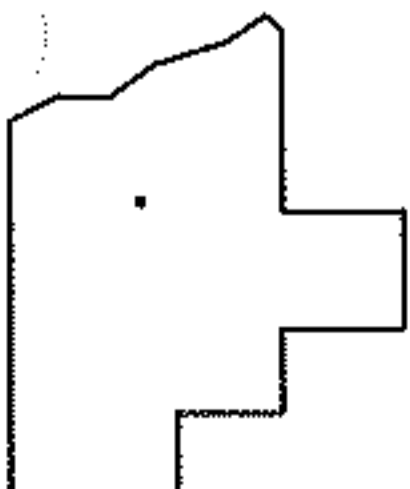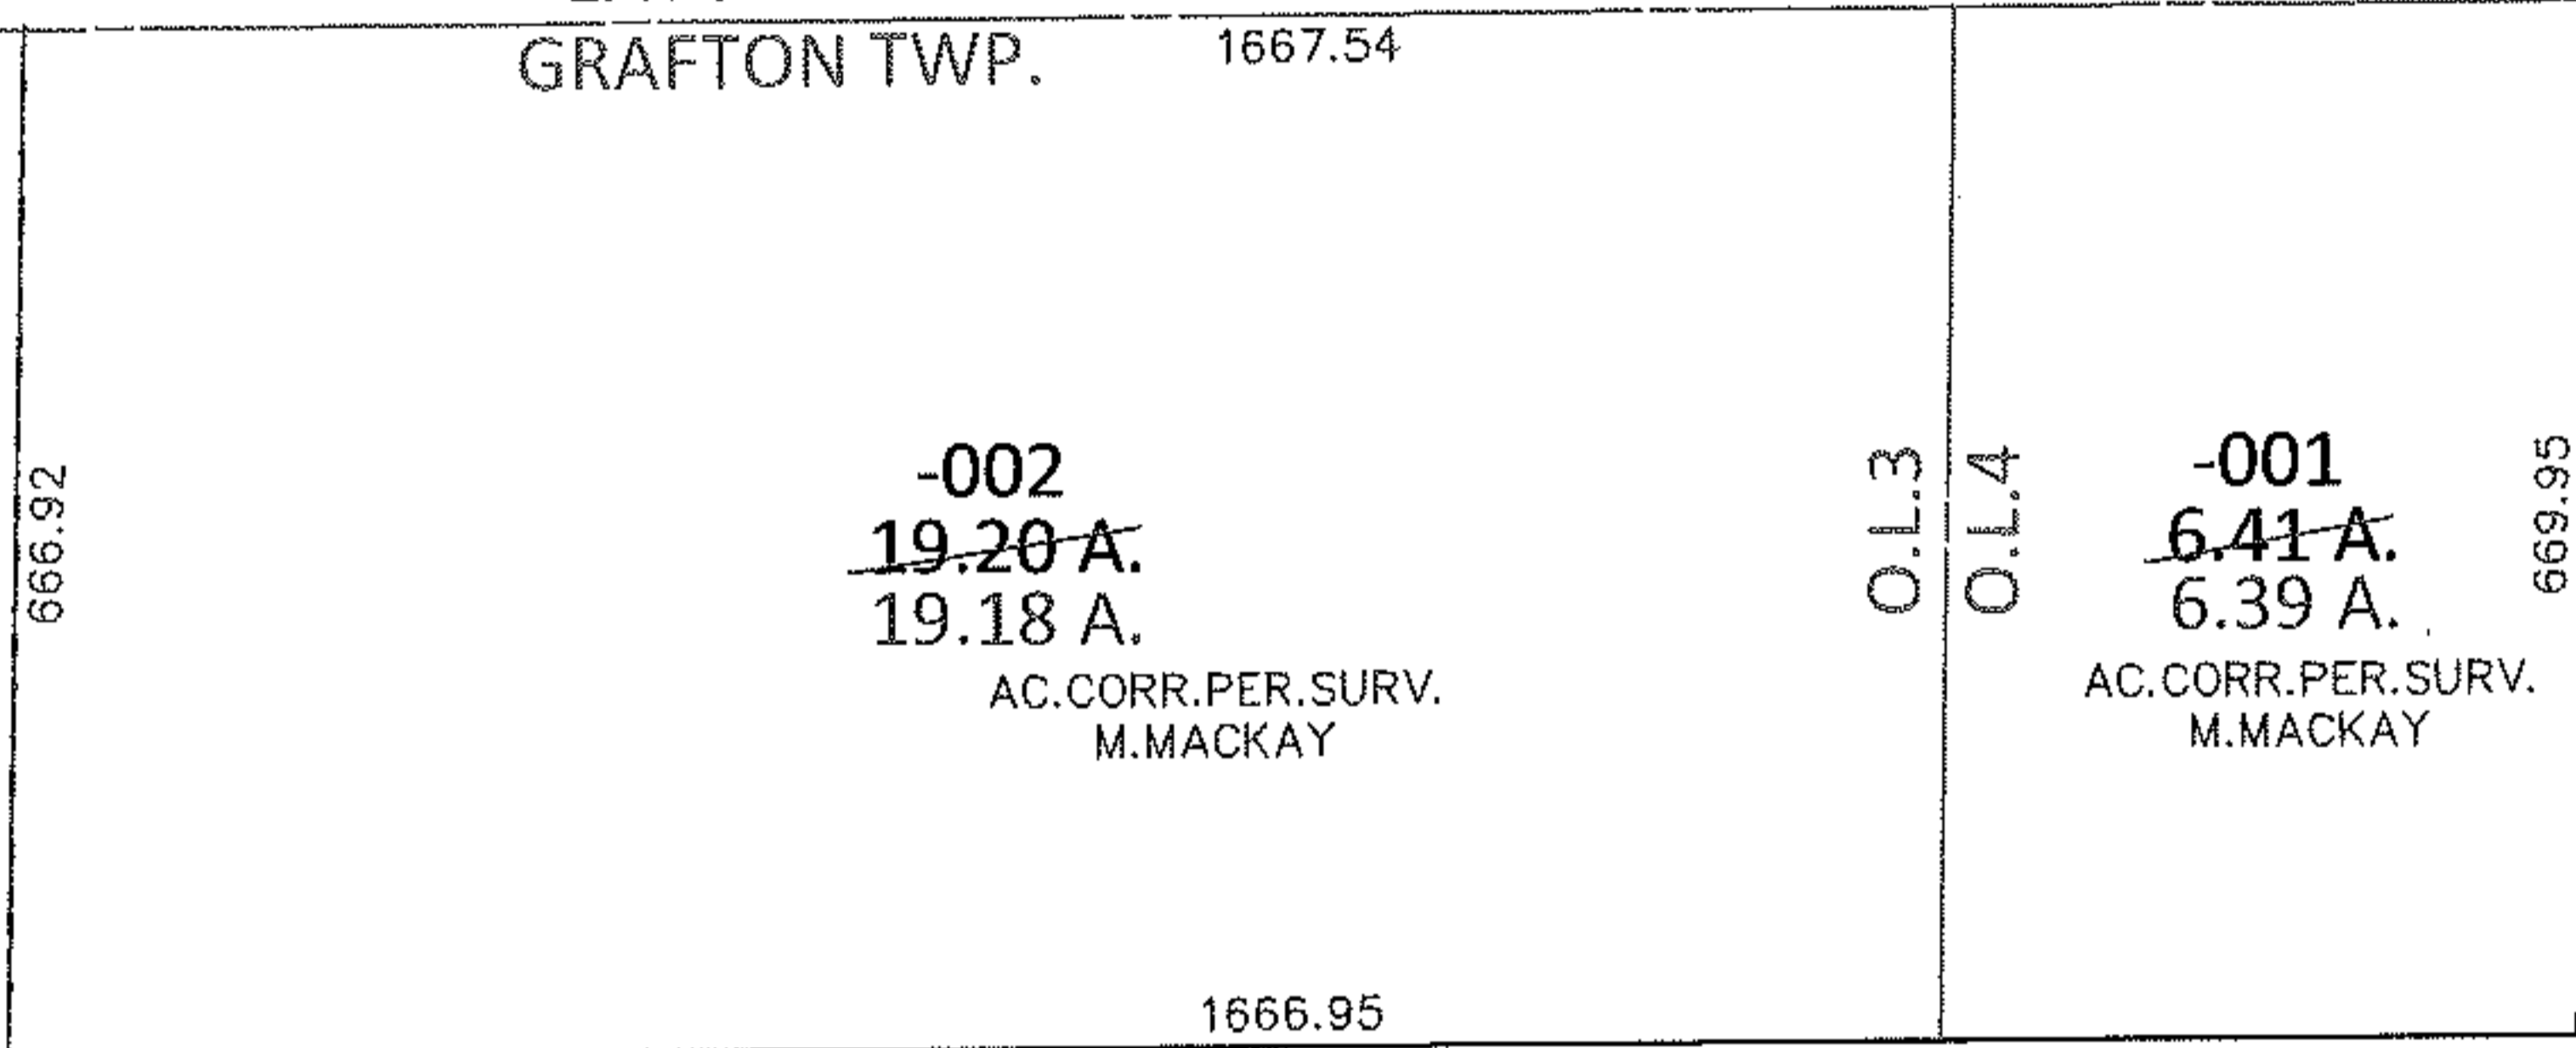

SPLITS/DEEDS PROCESSED

LORAIN COUNTY TAX MAP DEPARTMENT
226 MIDDLE AVE. ELYRIA, OHIO

SURVEYED BY: MICHAEL MACKAY

CLOSURE: .01:10,000

MAP PAGE(S): 16-00-003-B, 16-B

APPROVED BY: RRM DATE: 10-24-13

SCALE: 1" = 300 PRIOR INST.: 20050058520