
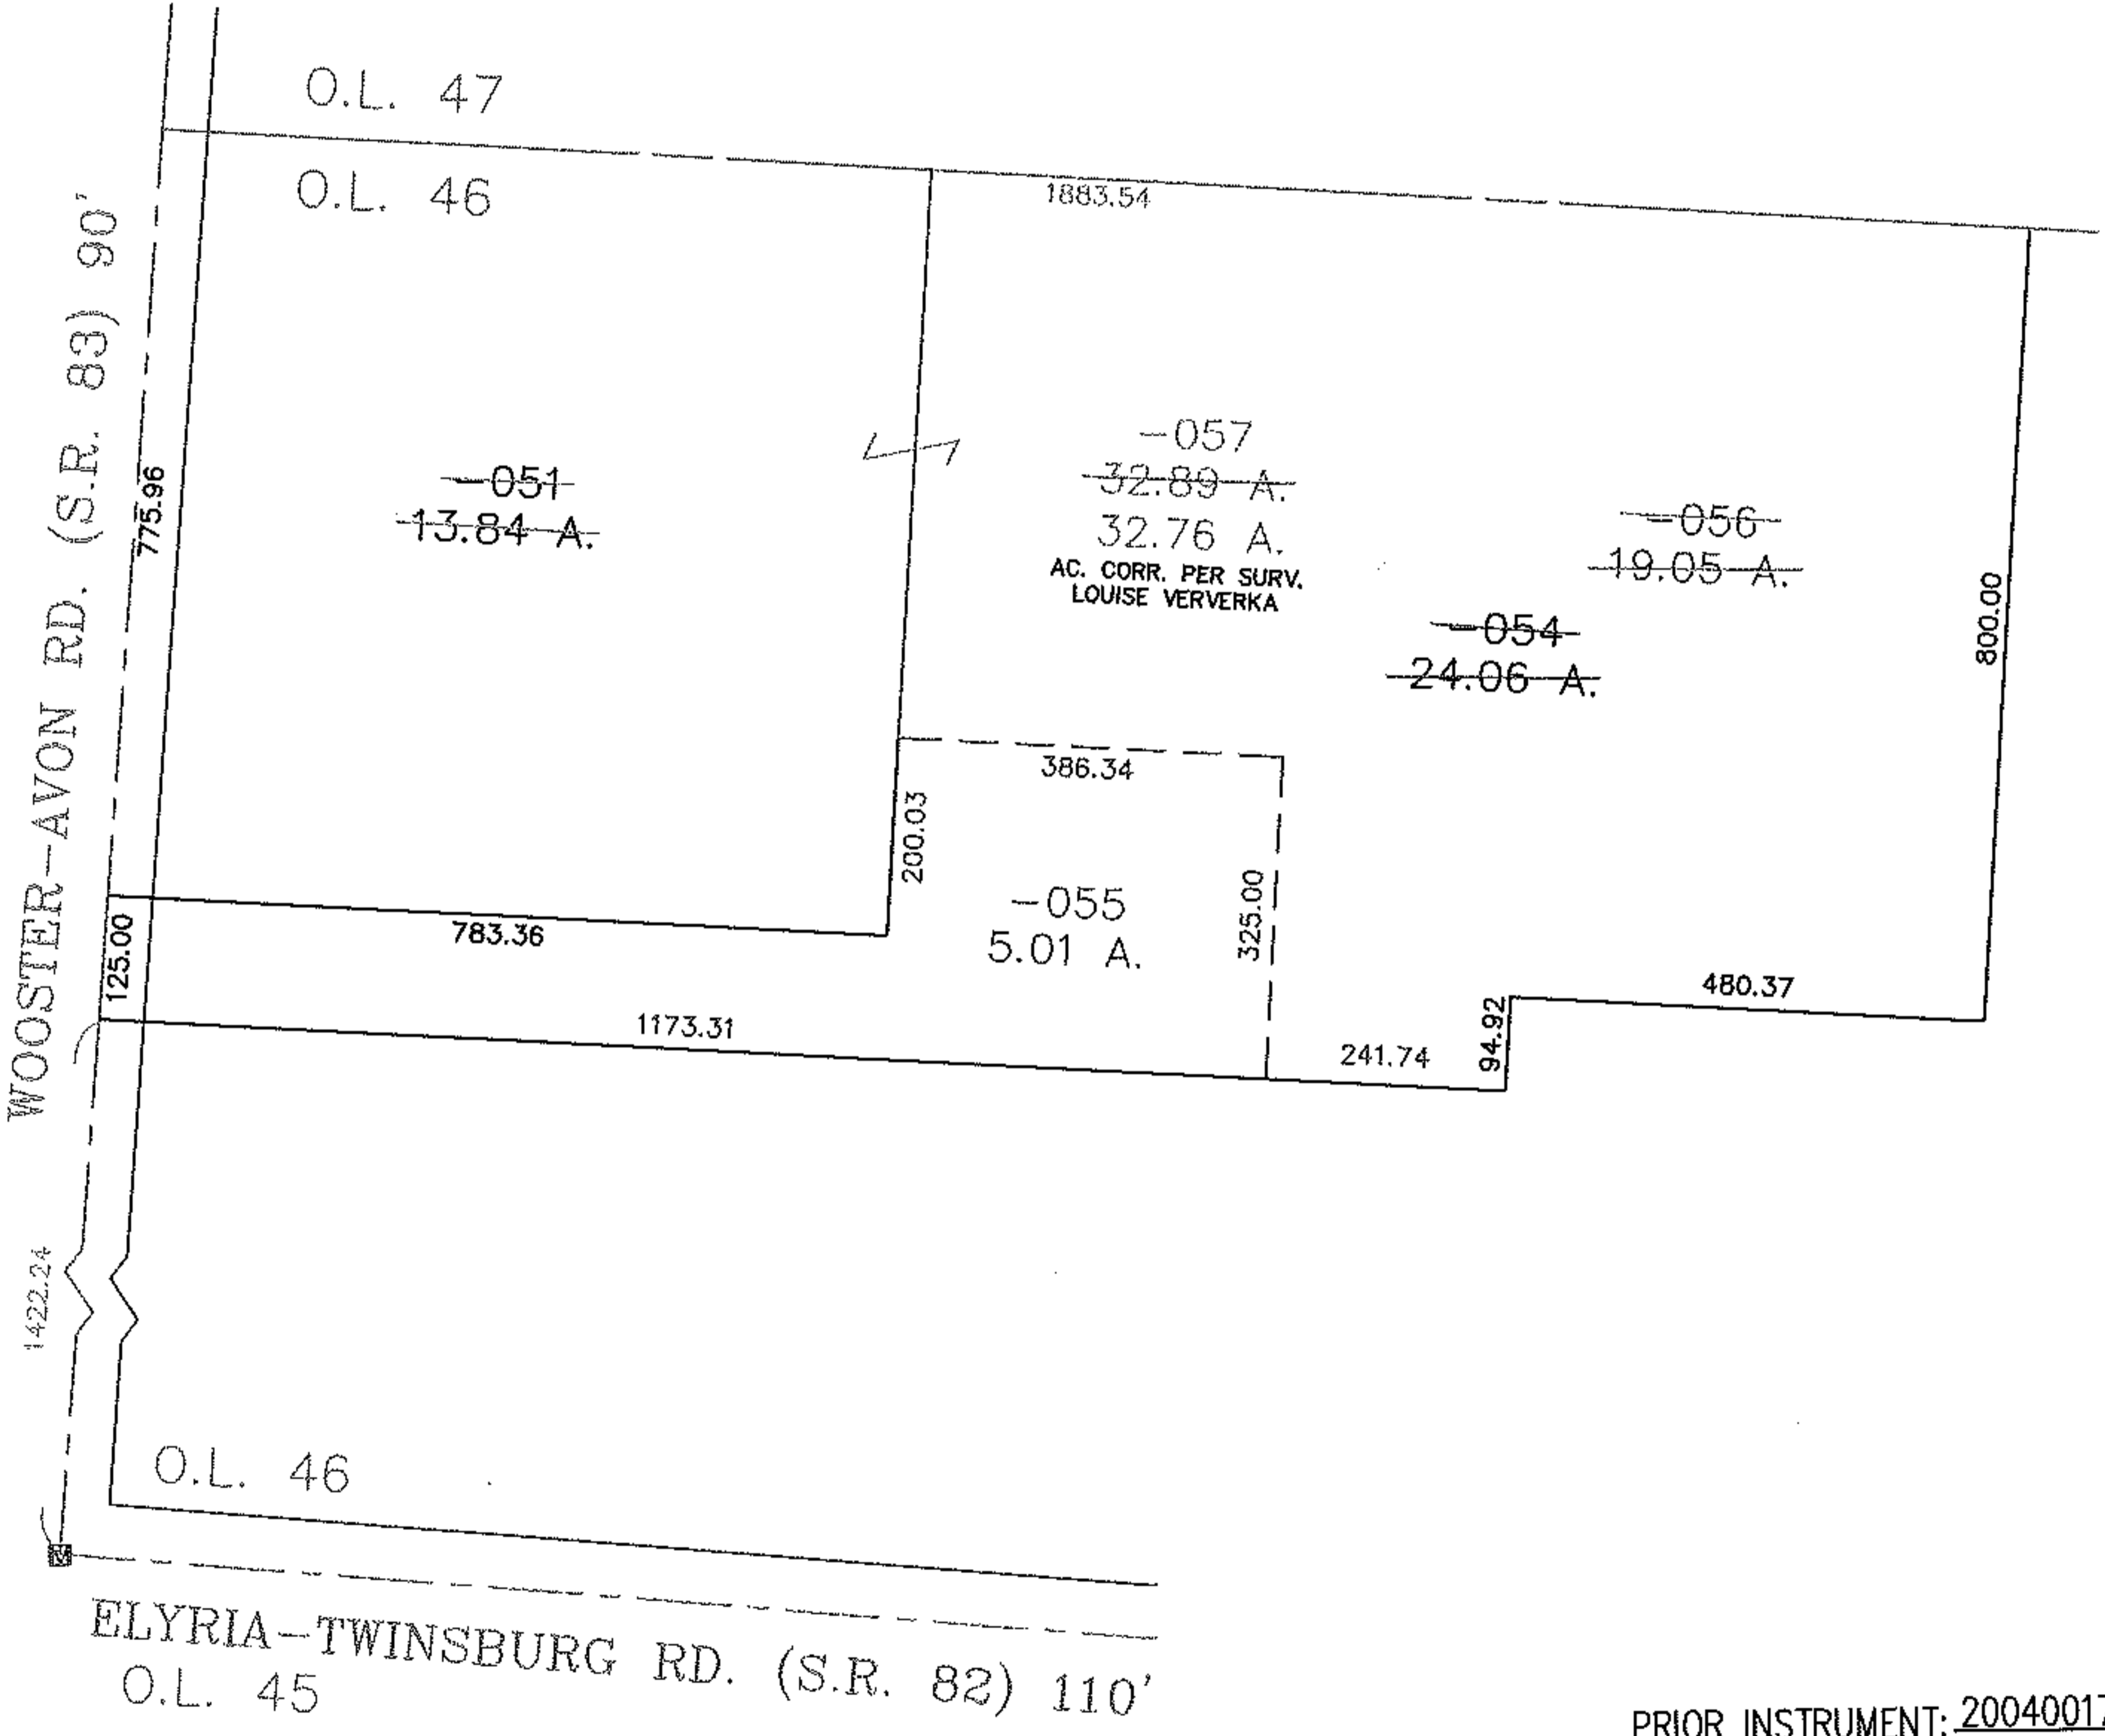


RASTER

PARENT PARCEL: 11-00-046-000-051 & -054
CHILD PARCEL: 11-00-046-000-055 THRU -057
STARTING POINT: I.P. MON. BOX, CL OF WOOSTER-AVON RD. (S.R. 83) &
CL OF ELYRIA-TWINSBURG RD. (S.R. 82)

10-02827

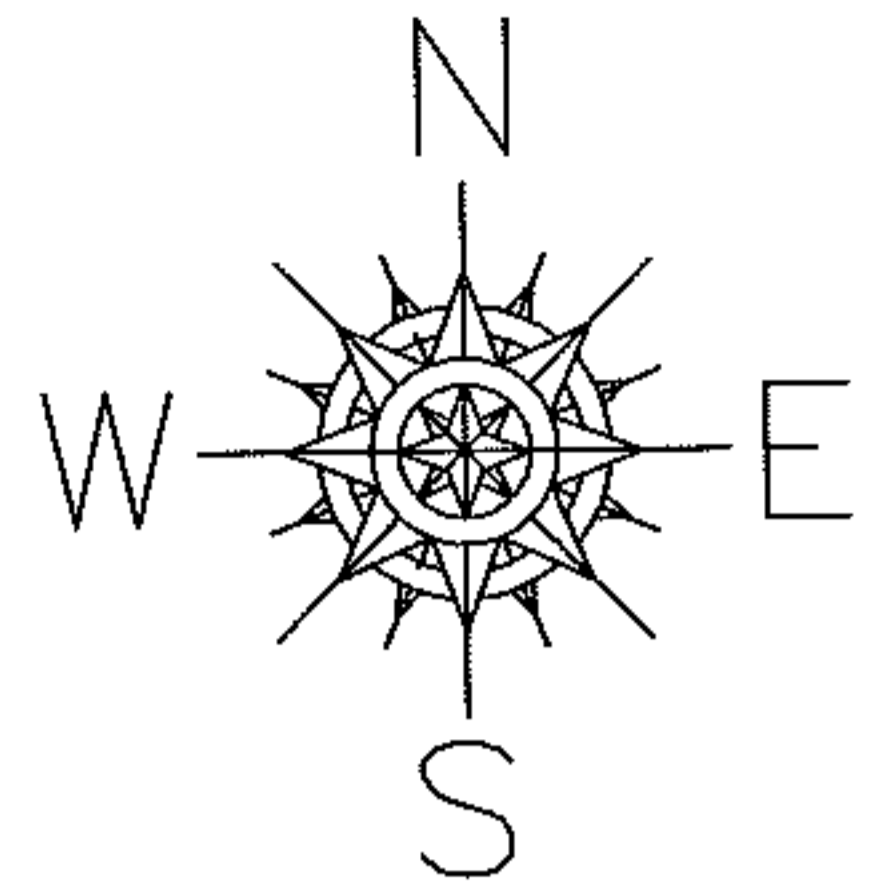

PRIOR INSTRUMENT: 20040017285
PRIOR INSTRUMENT: 20050073769

SURVEYED BY: LOUISE A. VERVERKA
CLOSURE: 0.01 : 10,000
MAP PAGE(S): 11-00-046-A & 11-C
APPROVED BY: TJS DATE: 5/3/10
SCALE: 1" = 300

SPLITS/DEEDS PROCESSED
LORAIN COUNTY TAX MAP DEPARTMENT
226 MIDDLE AVE. ELYRIA, OHIO

