


RASTER

PARENT PARCEL: 17-08-035-000-016

CHILD PARCEL: 17-08-035-000-021, -022


STARTING POINT: CENTERLINE OF PECK-WADSWORTH RD & O.L. 35.

10-02828

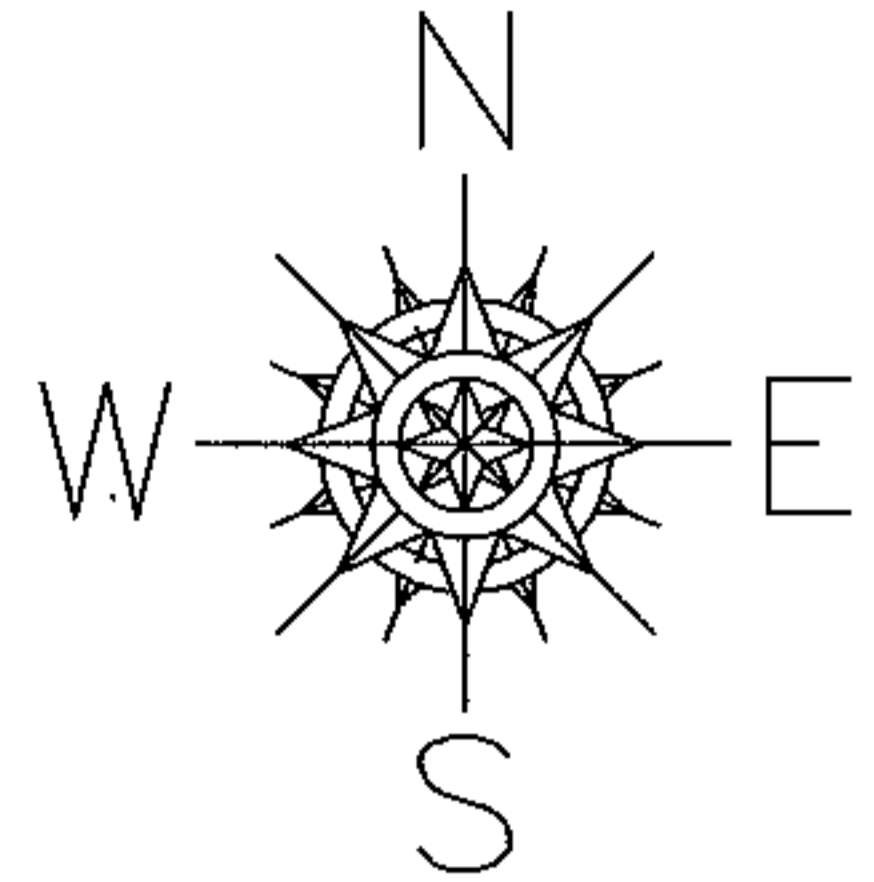

~~-016~~
~~38.41 A.~~
-022
37.04 A.

O.L. 36
O.L. 35

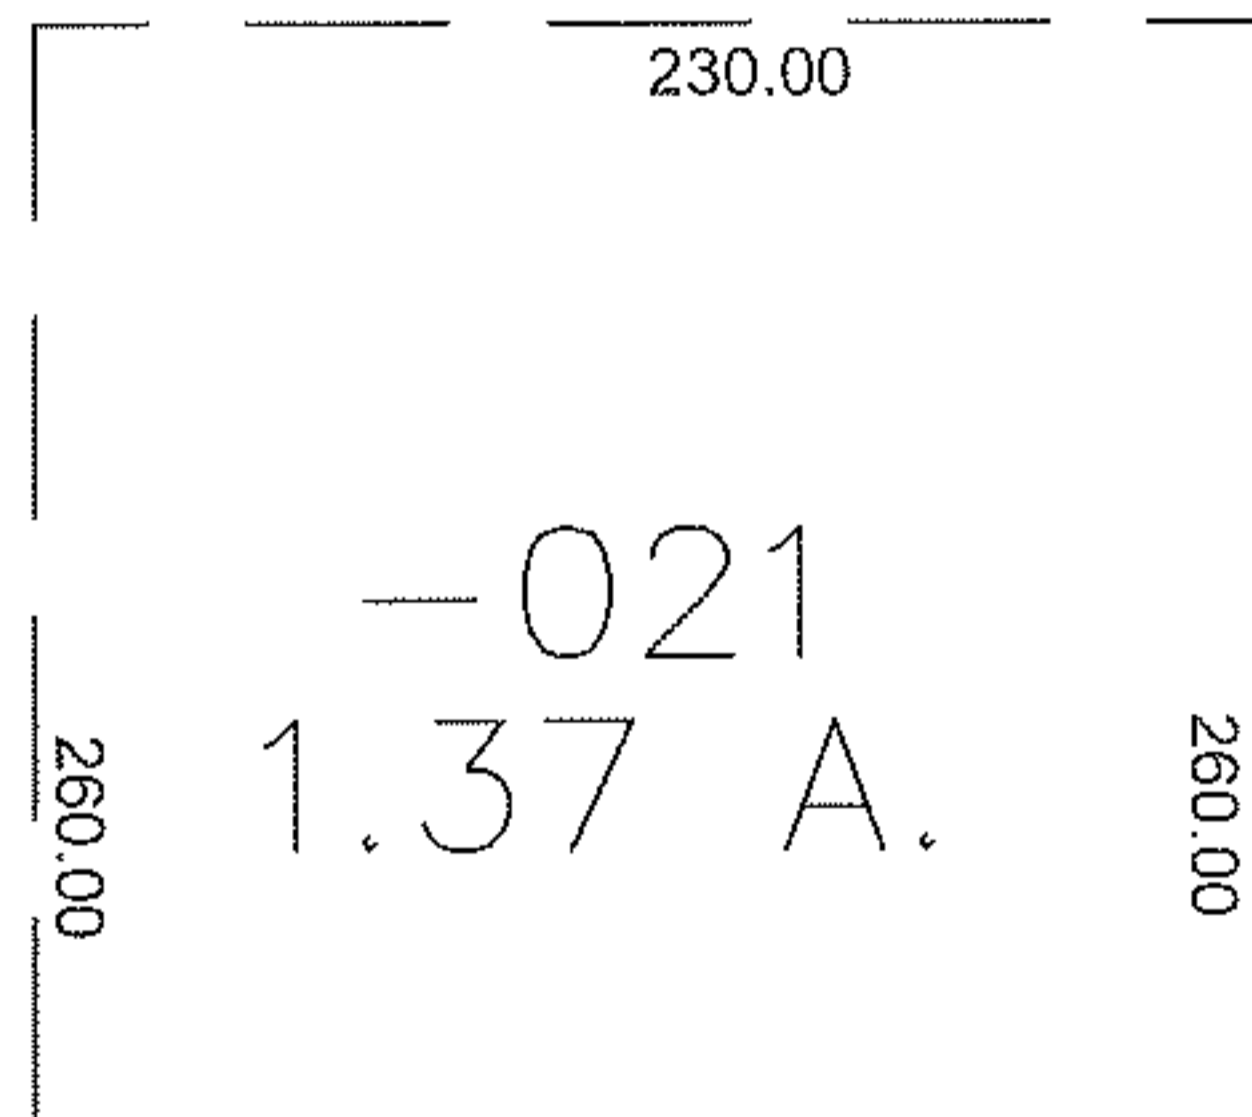

PECK-WADSWORTH RD
847.51 230.00

SPLITS/DEEDS PROCESSED

LORAIN COUNTY TAX MAP DEPARTMENT
226 MIDDLE AVE. ELYRIA, OHIO

SURVEYED BY: THOMAS SNEZEK
CLOSURE: 0.00 : 10,000
MAP PAGE(S): 17-A
APPROVED BY: JAH DATE: 5-3-2010
SCALE: 1" = 100' PRIOR INSTRUMENT: 19970494513