

PARENT PARCEL: 06-25-061-000-006




CHILD PARCEL: \_\_\_\_\_

13-02829-C

STARTING POINT: SOUTHWEST CORNER OF LAND CONVEYED TO KENNETH W. & JULIA GIVENS (DV 366/232)

FRONTAGE & DEPTH TO ACREAGE CORRECTION

06-25-061-000-006  
0.25 A.  
~~52.08 X 185~~  
PER PRIOR DEEDS

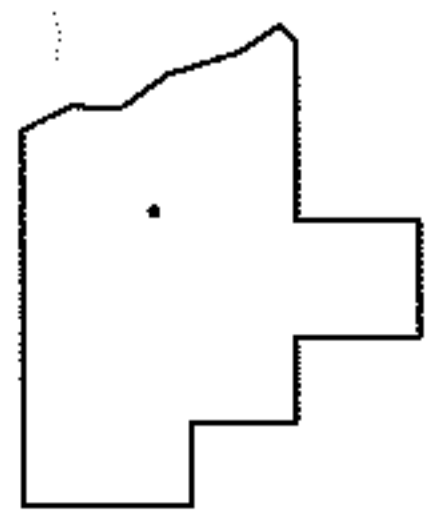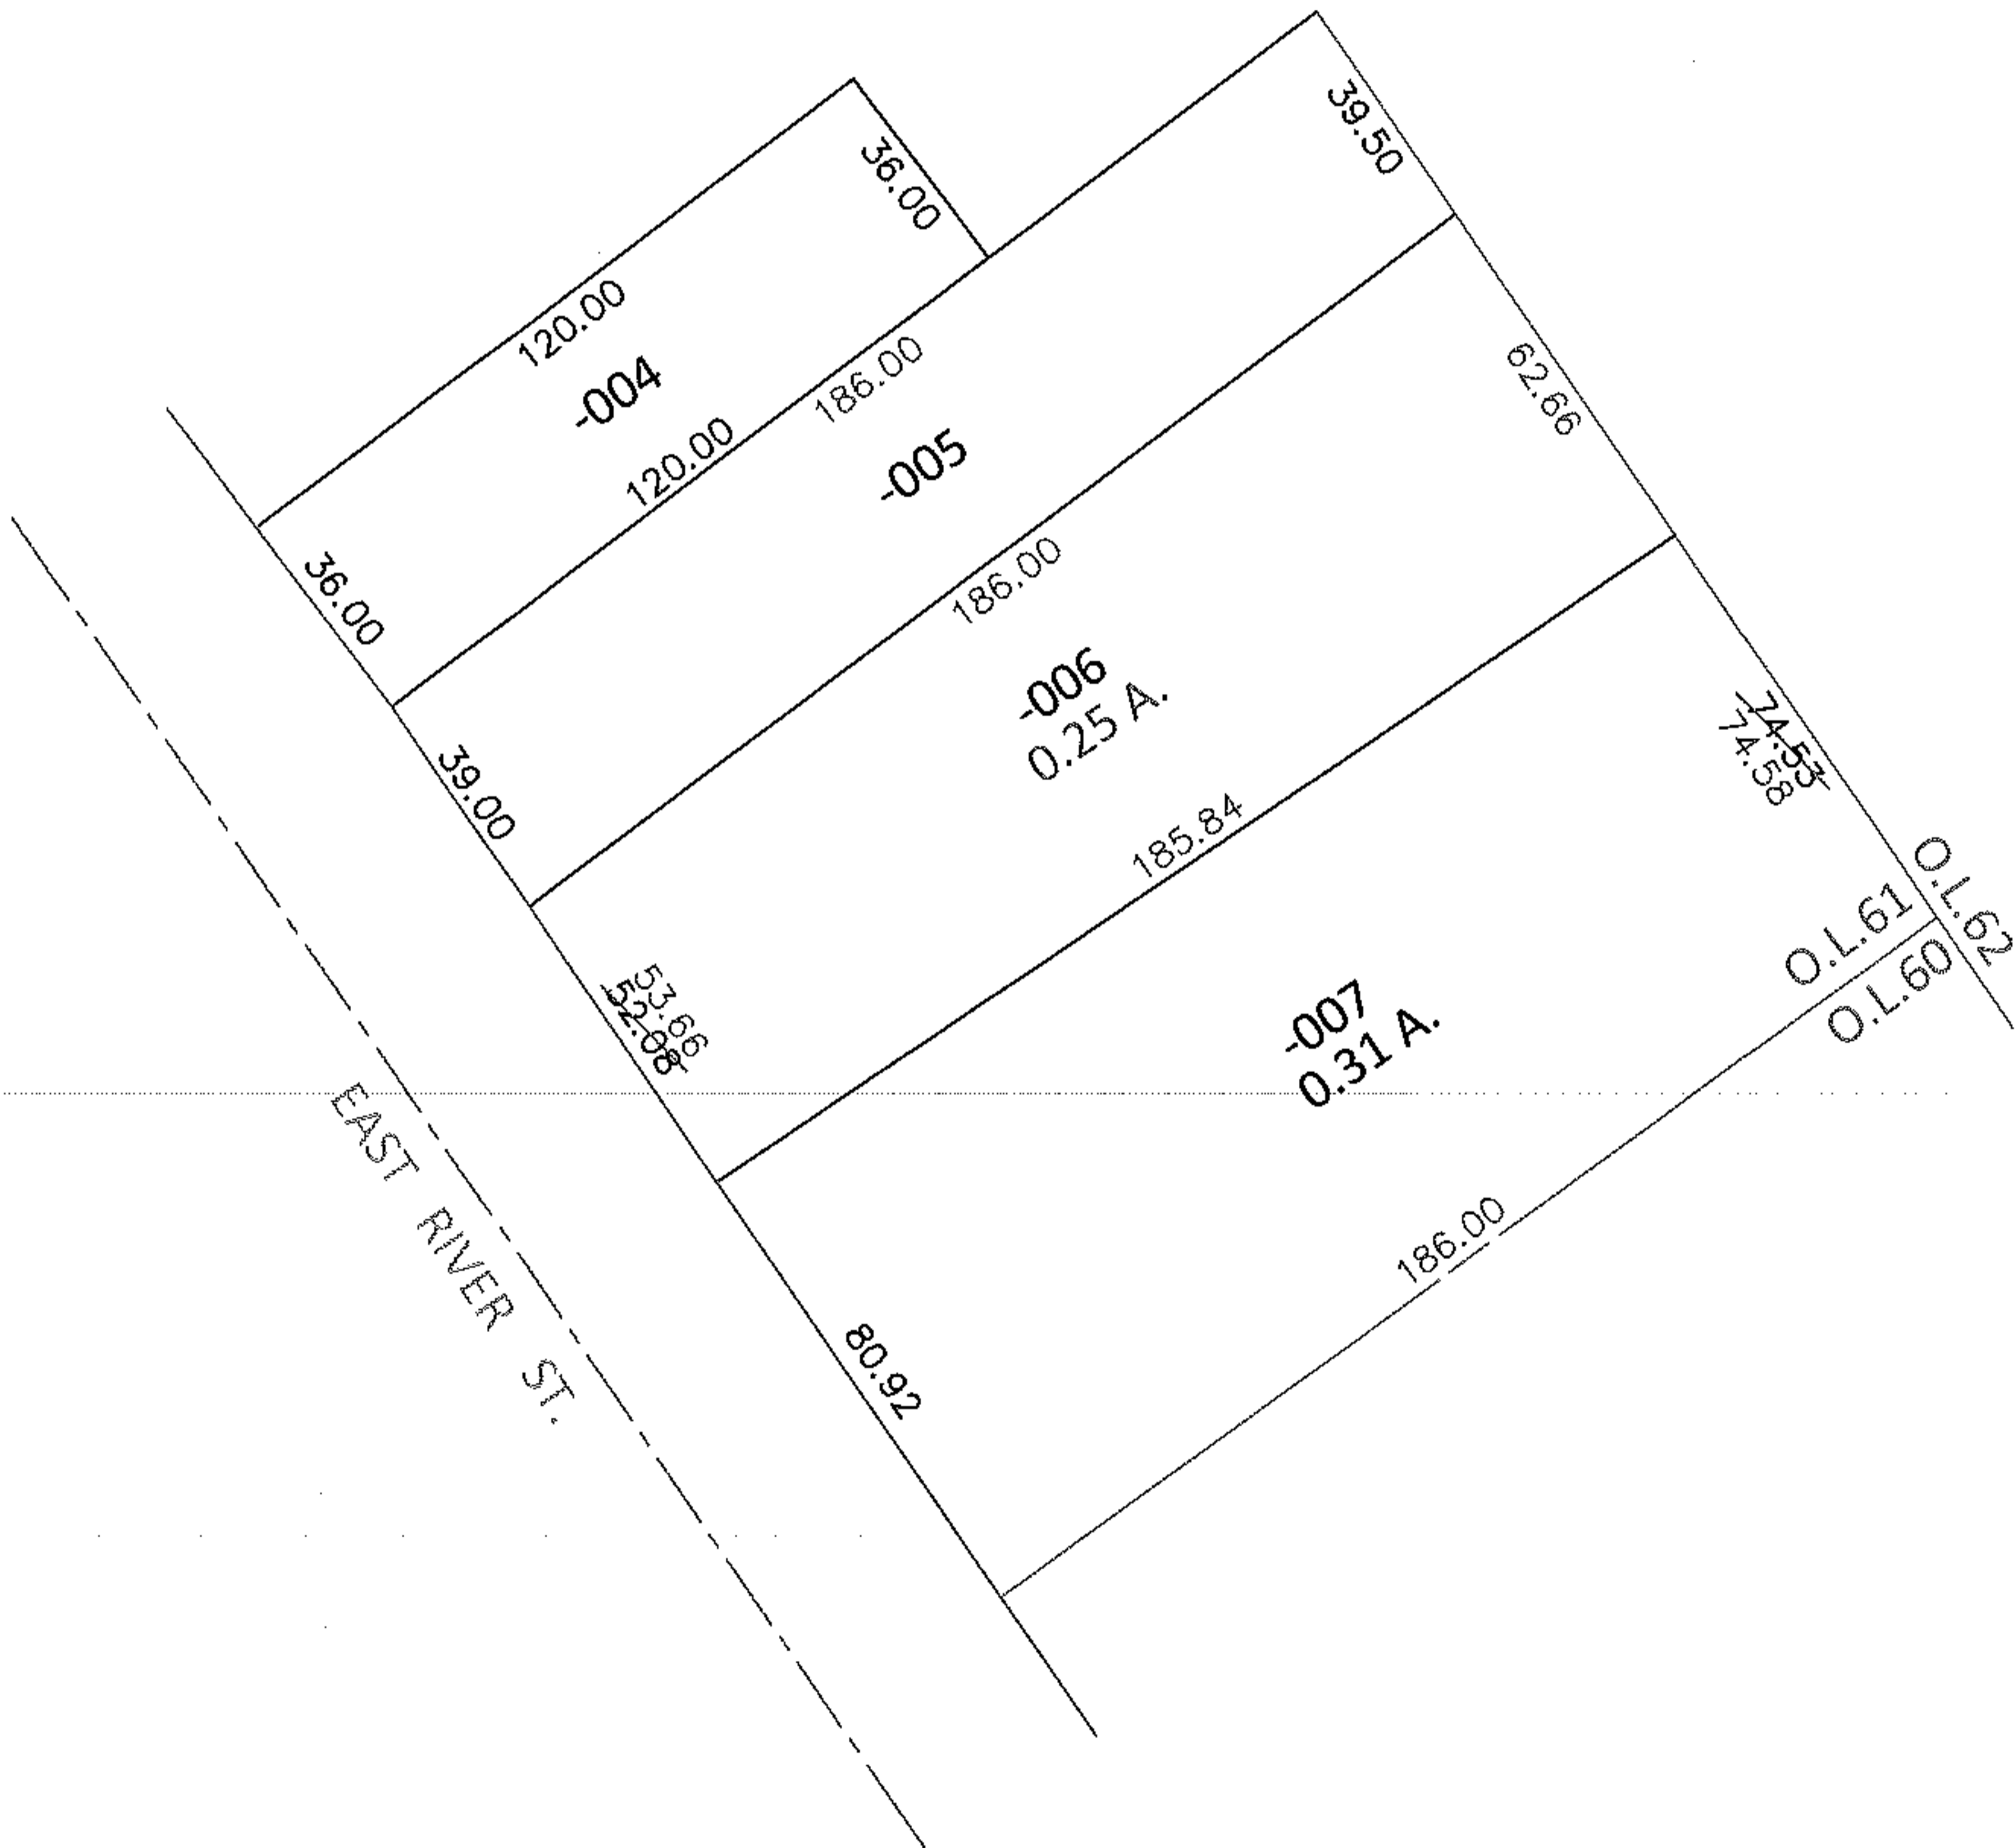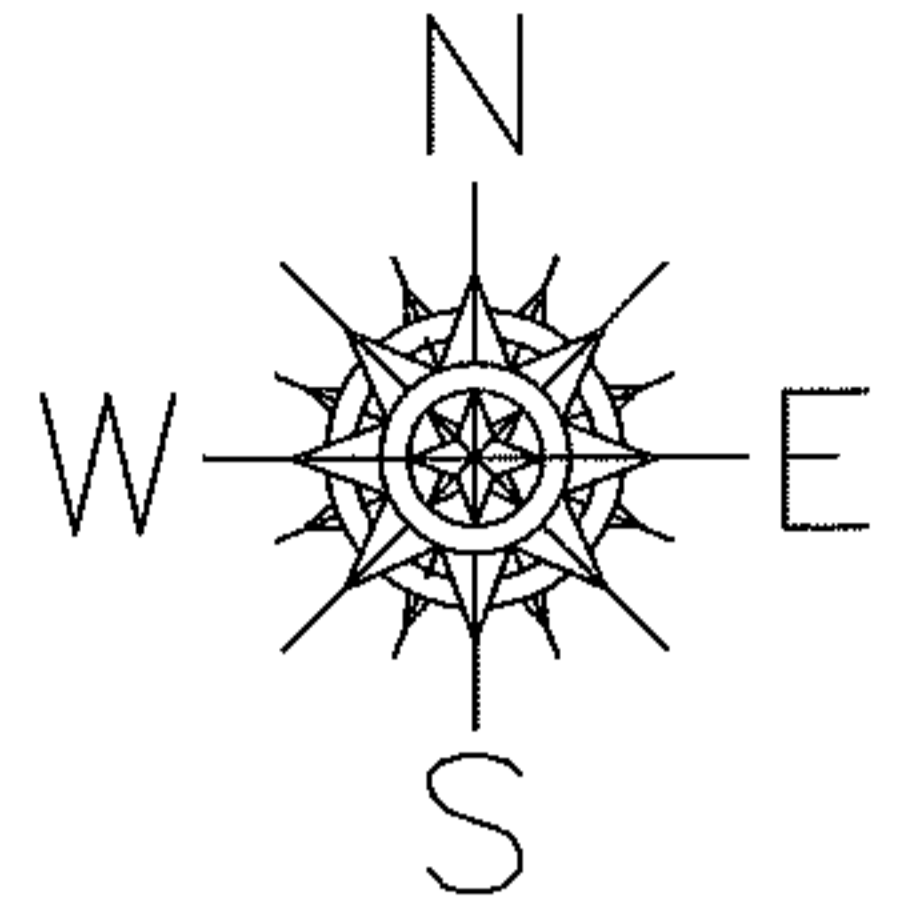

SPLITS/DEEDS PROCESSED

LORAIN COUNTY TAX MAP DEPARTMENT  
226 MIDDLE AVE. ELYRIA, OHIO

SURVEYED BY: N/A

CLOSURE: 1:3755.44

MAP PAGE(S): 6-103

APPROVED BY: RRM DATE: 10-22-13

SCALE: 1" = 50' PRIOR INST.: 20050052546