
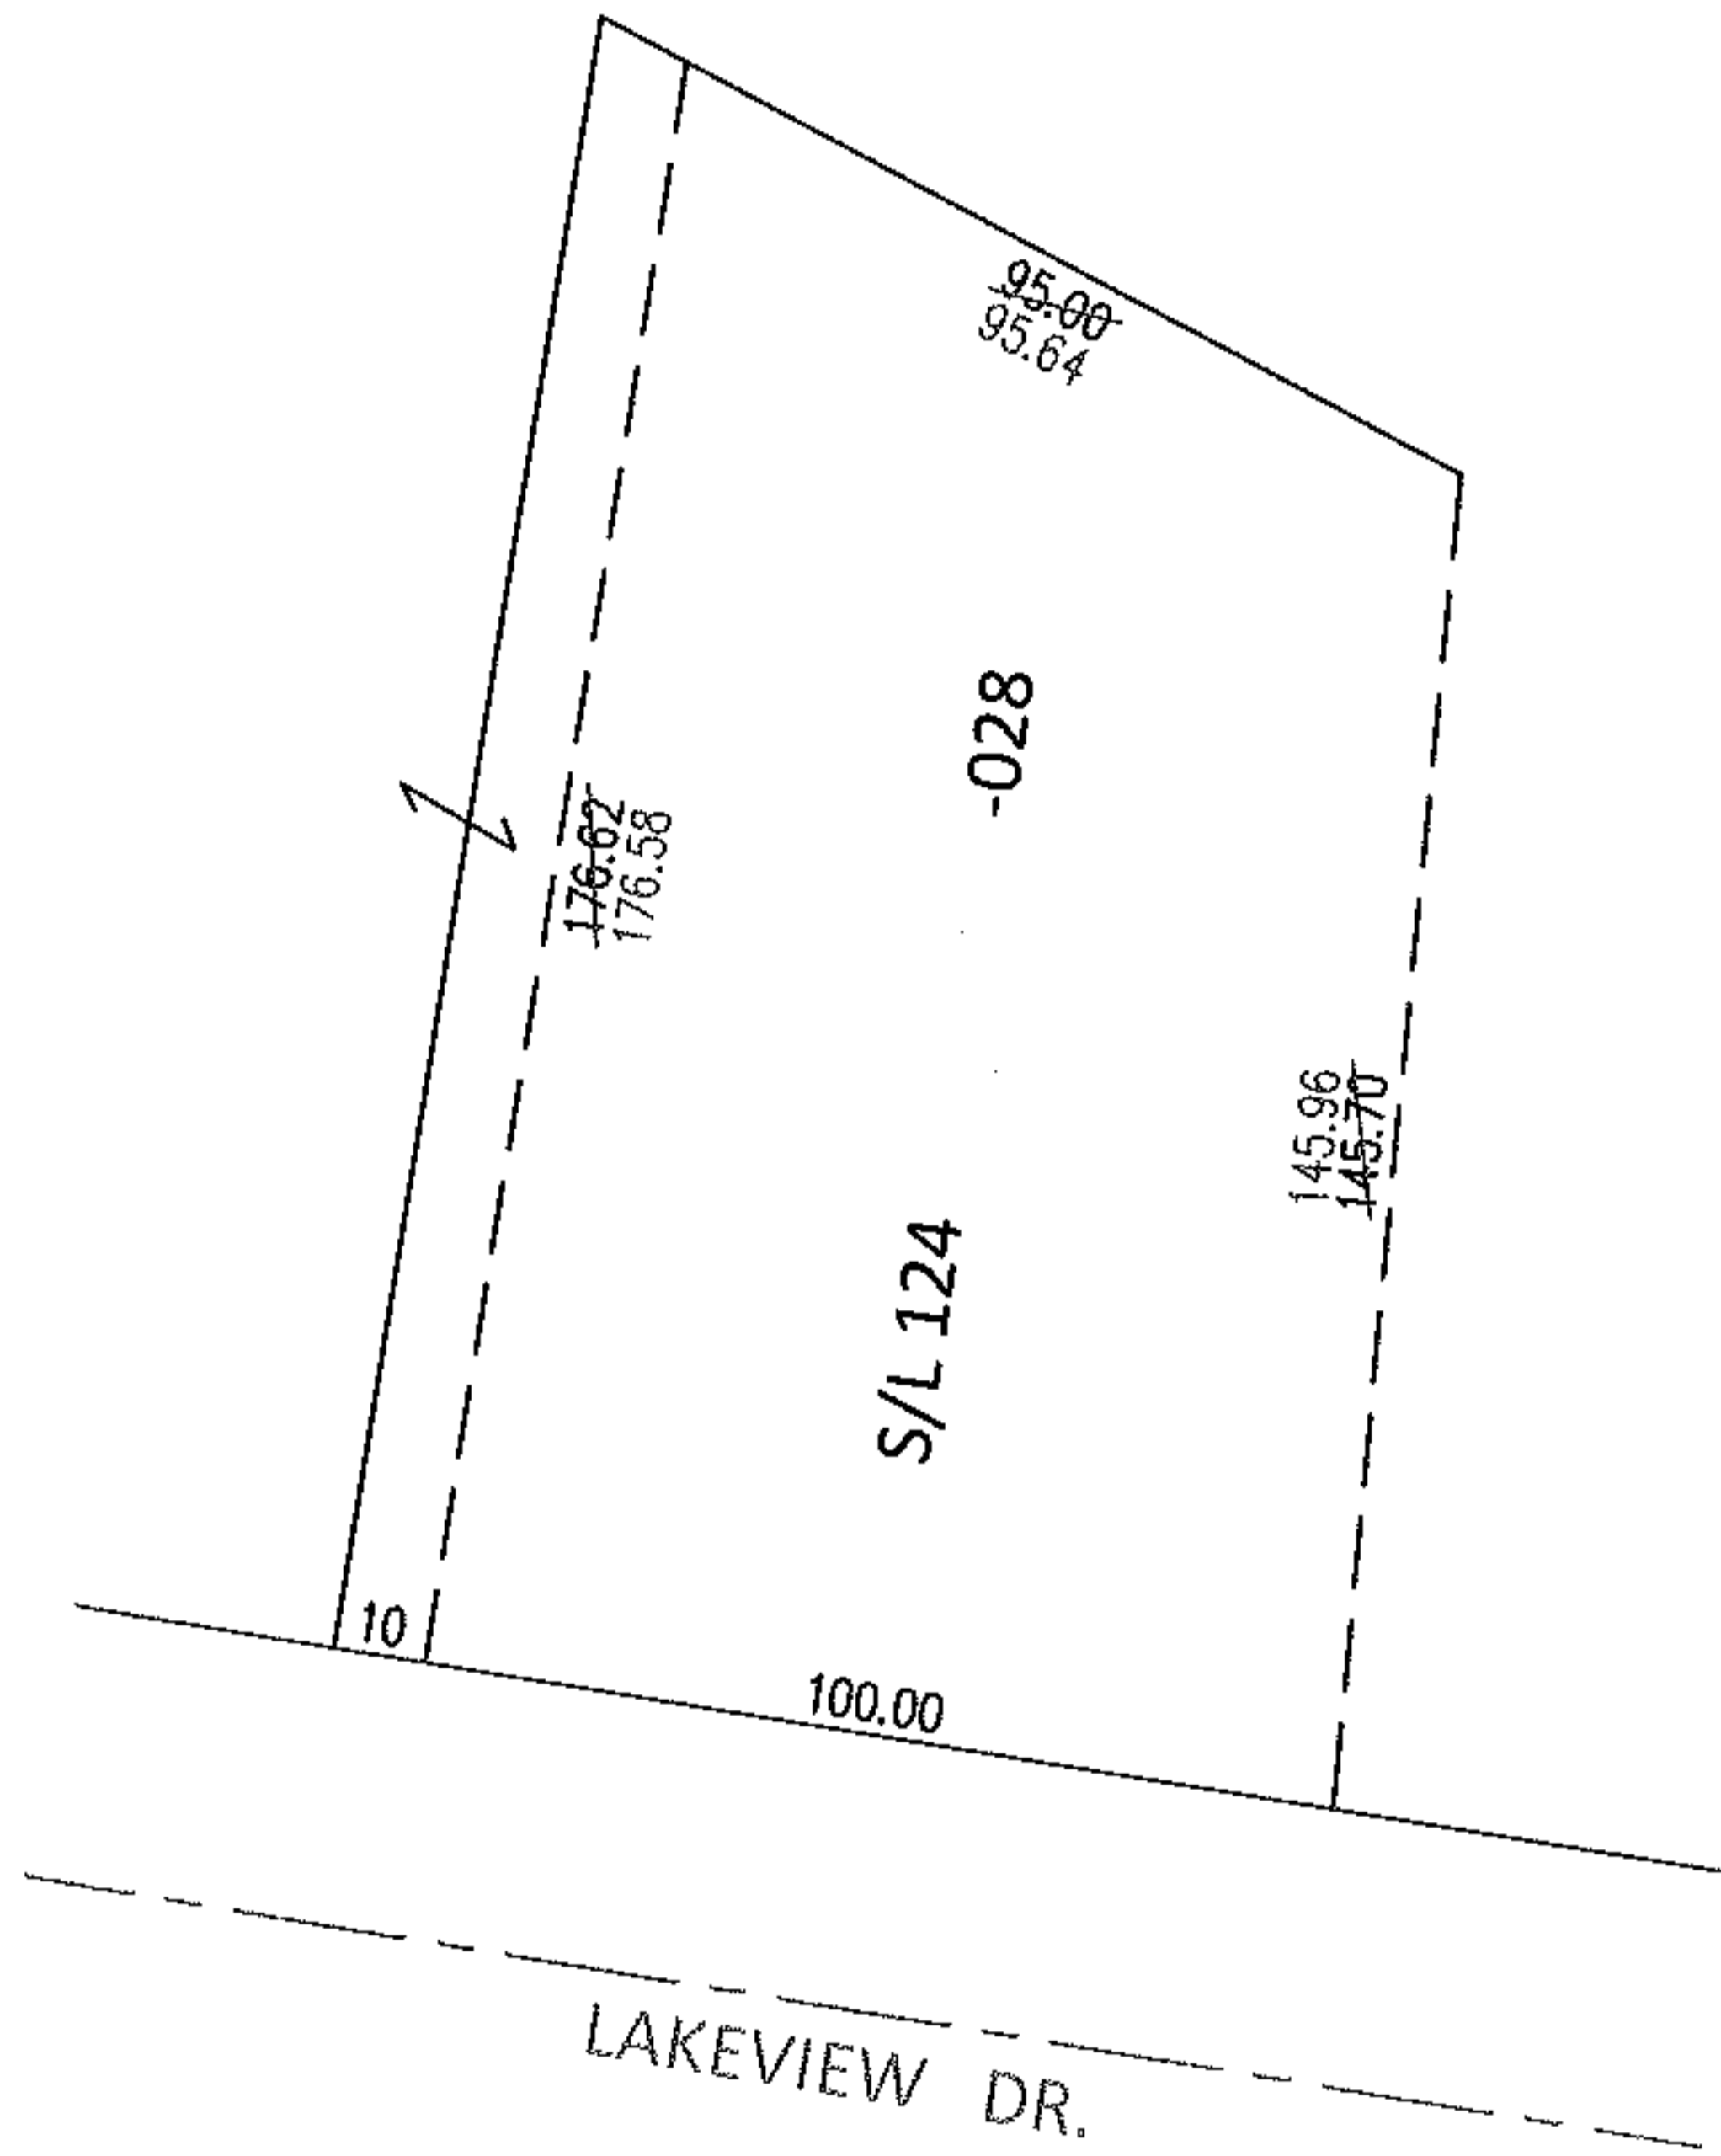


PARENT PARCEL: 10-00-015-108-028

CHILD PARCEL: \_\_\_\_\_

STARTING POINT: SOUTHWEST CORNER OF S/L 124 IN BRENTWOOD ALLOT. NO.2 (VOL. 16 PG.11)

13-02830-D

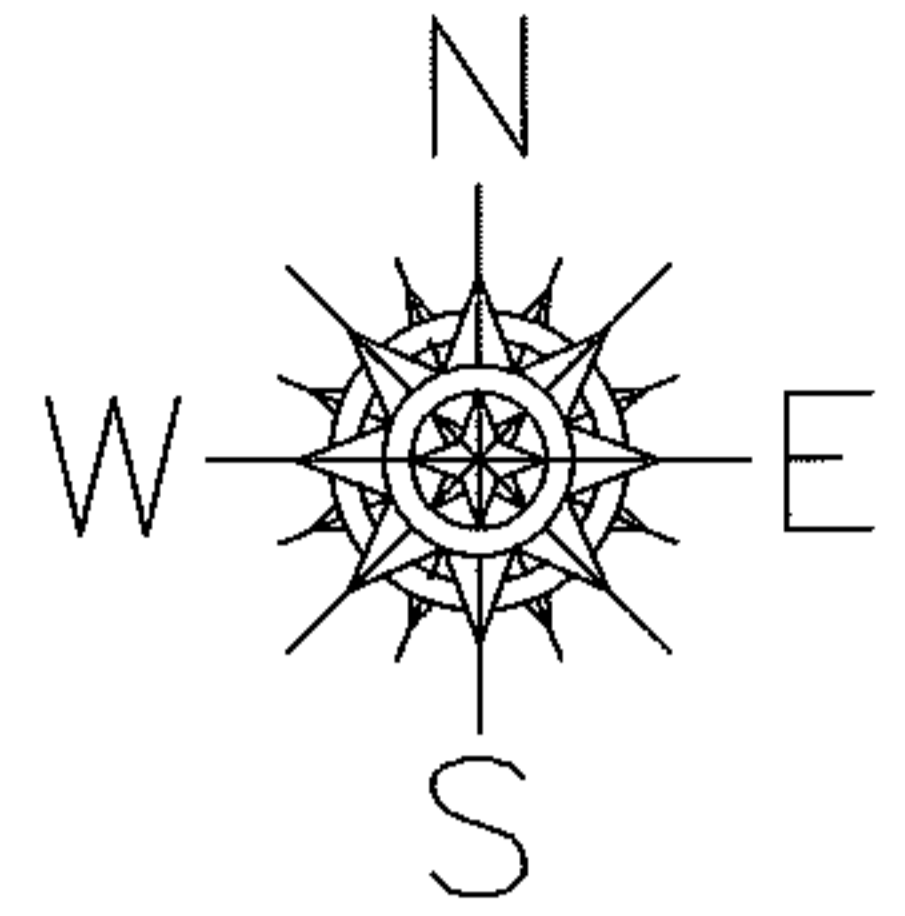


DEPTH CORRECTION

10-00-015-108-028

176.58

100 X ~~176~~

PER SURVEY BY JAMES A. RESAR

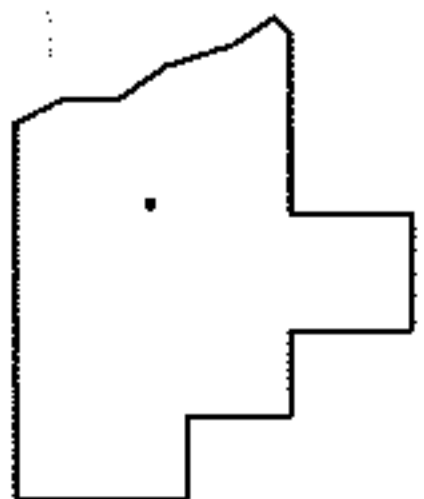

SPLITS/DEEDS PROCESSED

LORAIN COUNTY TAX MAP DEPARTMENT  
226 MIDDLE AVE. ELYRIA, OHIO

SURVEYED BY: JAMES A. RESAR

CLOSURE: .01:10,000

MAP PAGE(S): 10-00-015-D

APPROVED BY: RRM DATE: 10-23-13

SCALE: 1"= 50' PRIOR INST.: OR 431/467