
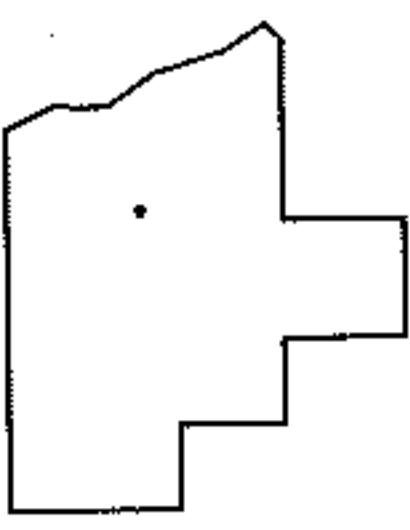
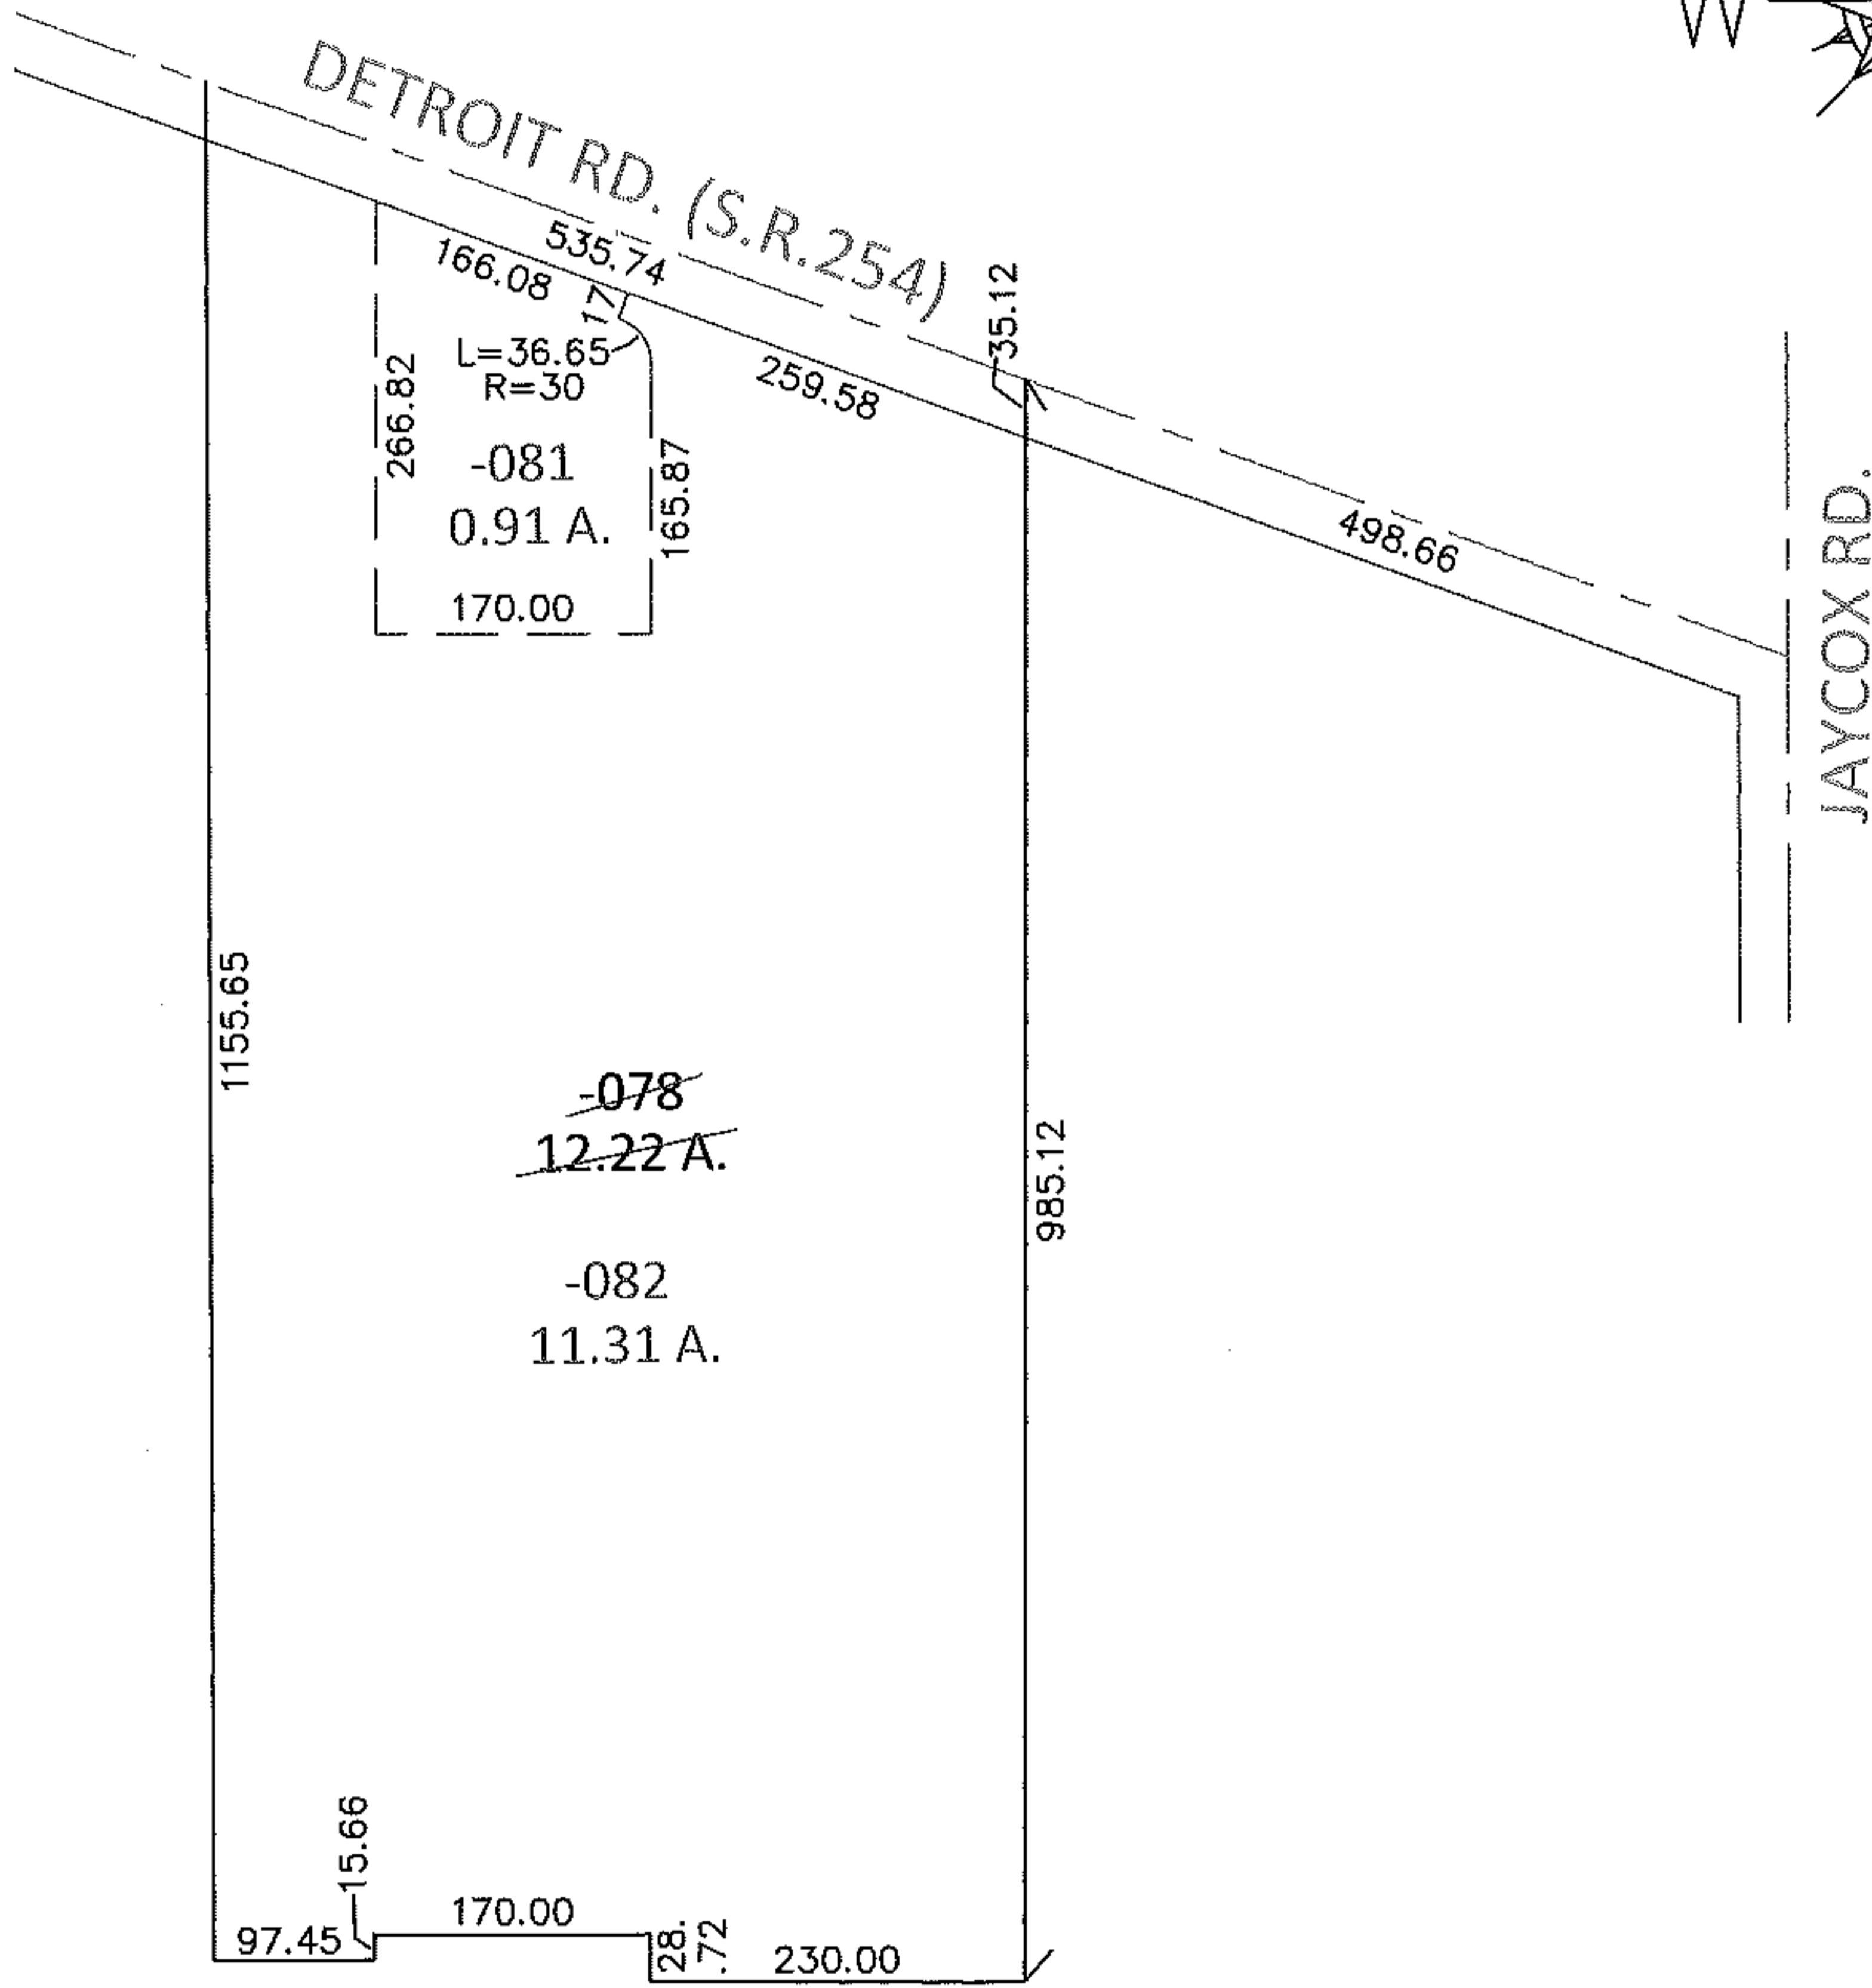


PARENT PARCEL: 04-00-022-103-078

CHILD PARCEL: 04-00-022-103-081, -082

10-02830

STARTING POINT: INTERSECTION OF C/L OF DETROIT RD. AND C/L OF JAYCOX RD.

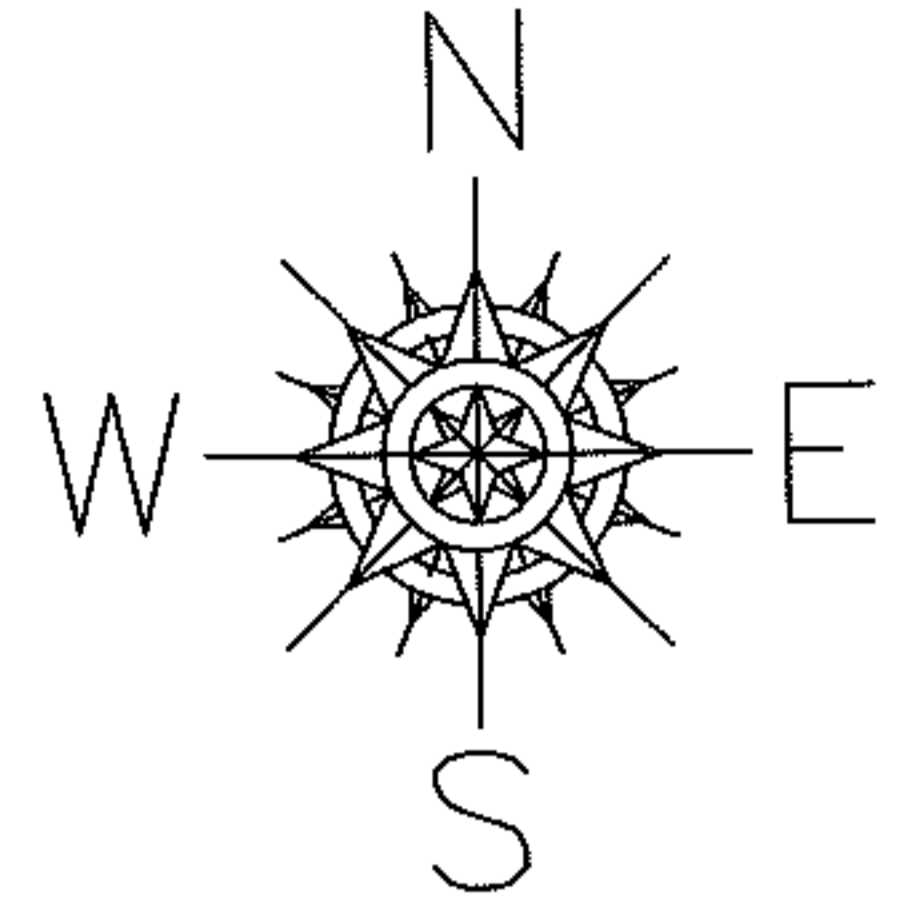

SPLITS/DEEDS PROCESSED

LORAIN COUNTY TAX MAP DEPARTMENT
226 MIDDLE AVE. ELYRIA, OHIO

SURVEYED BY: MICHAEL P. SPELLACY

CLOSURE: .01:10,000

MAP PAGE(S): 4-00-022-F

APPROVED BY: RRM DATE: 6-2-10

SCALE: 1"= 200 PRIOR INST.: 20080277968