
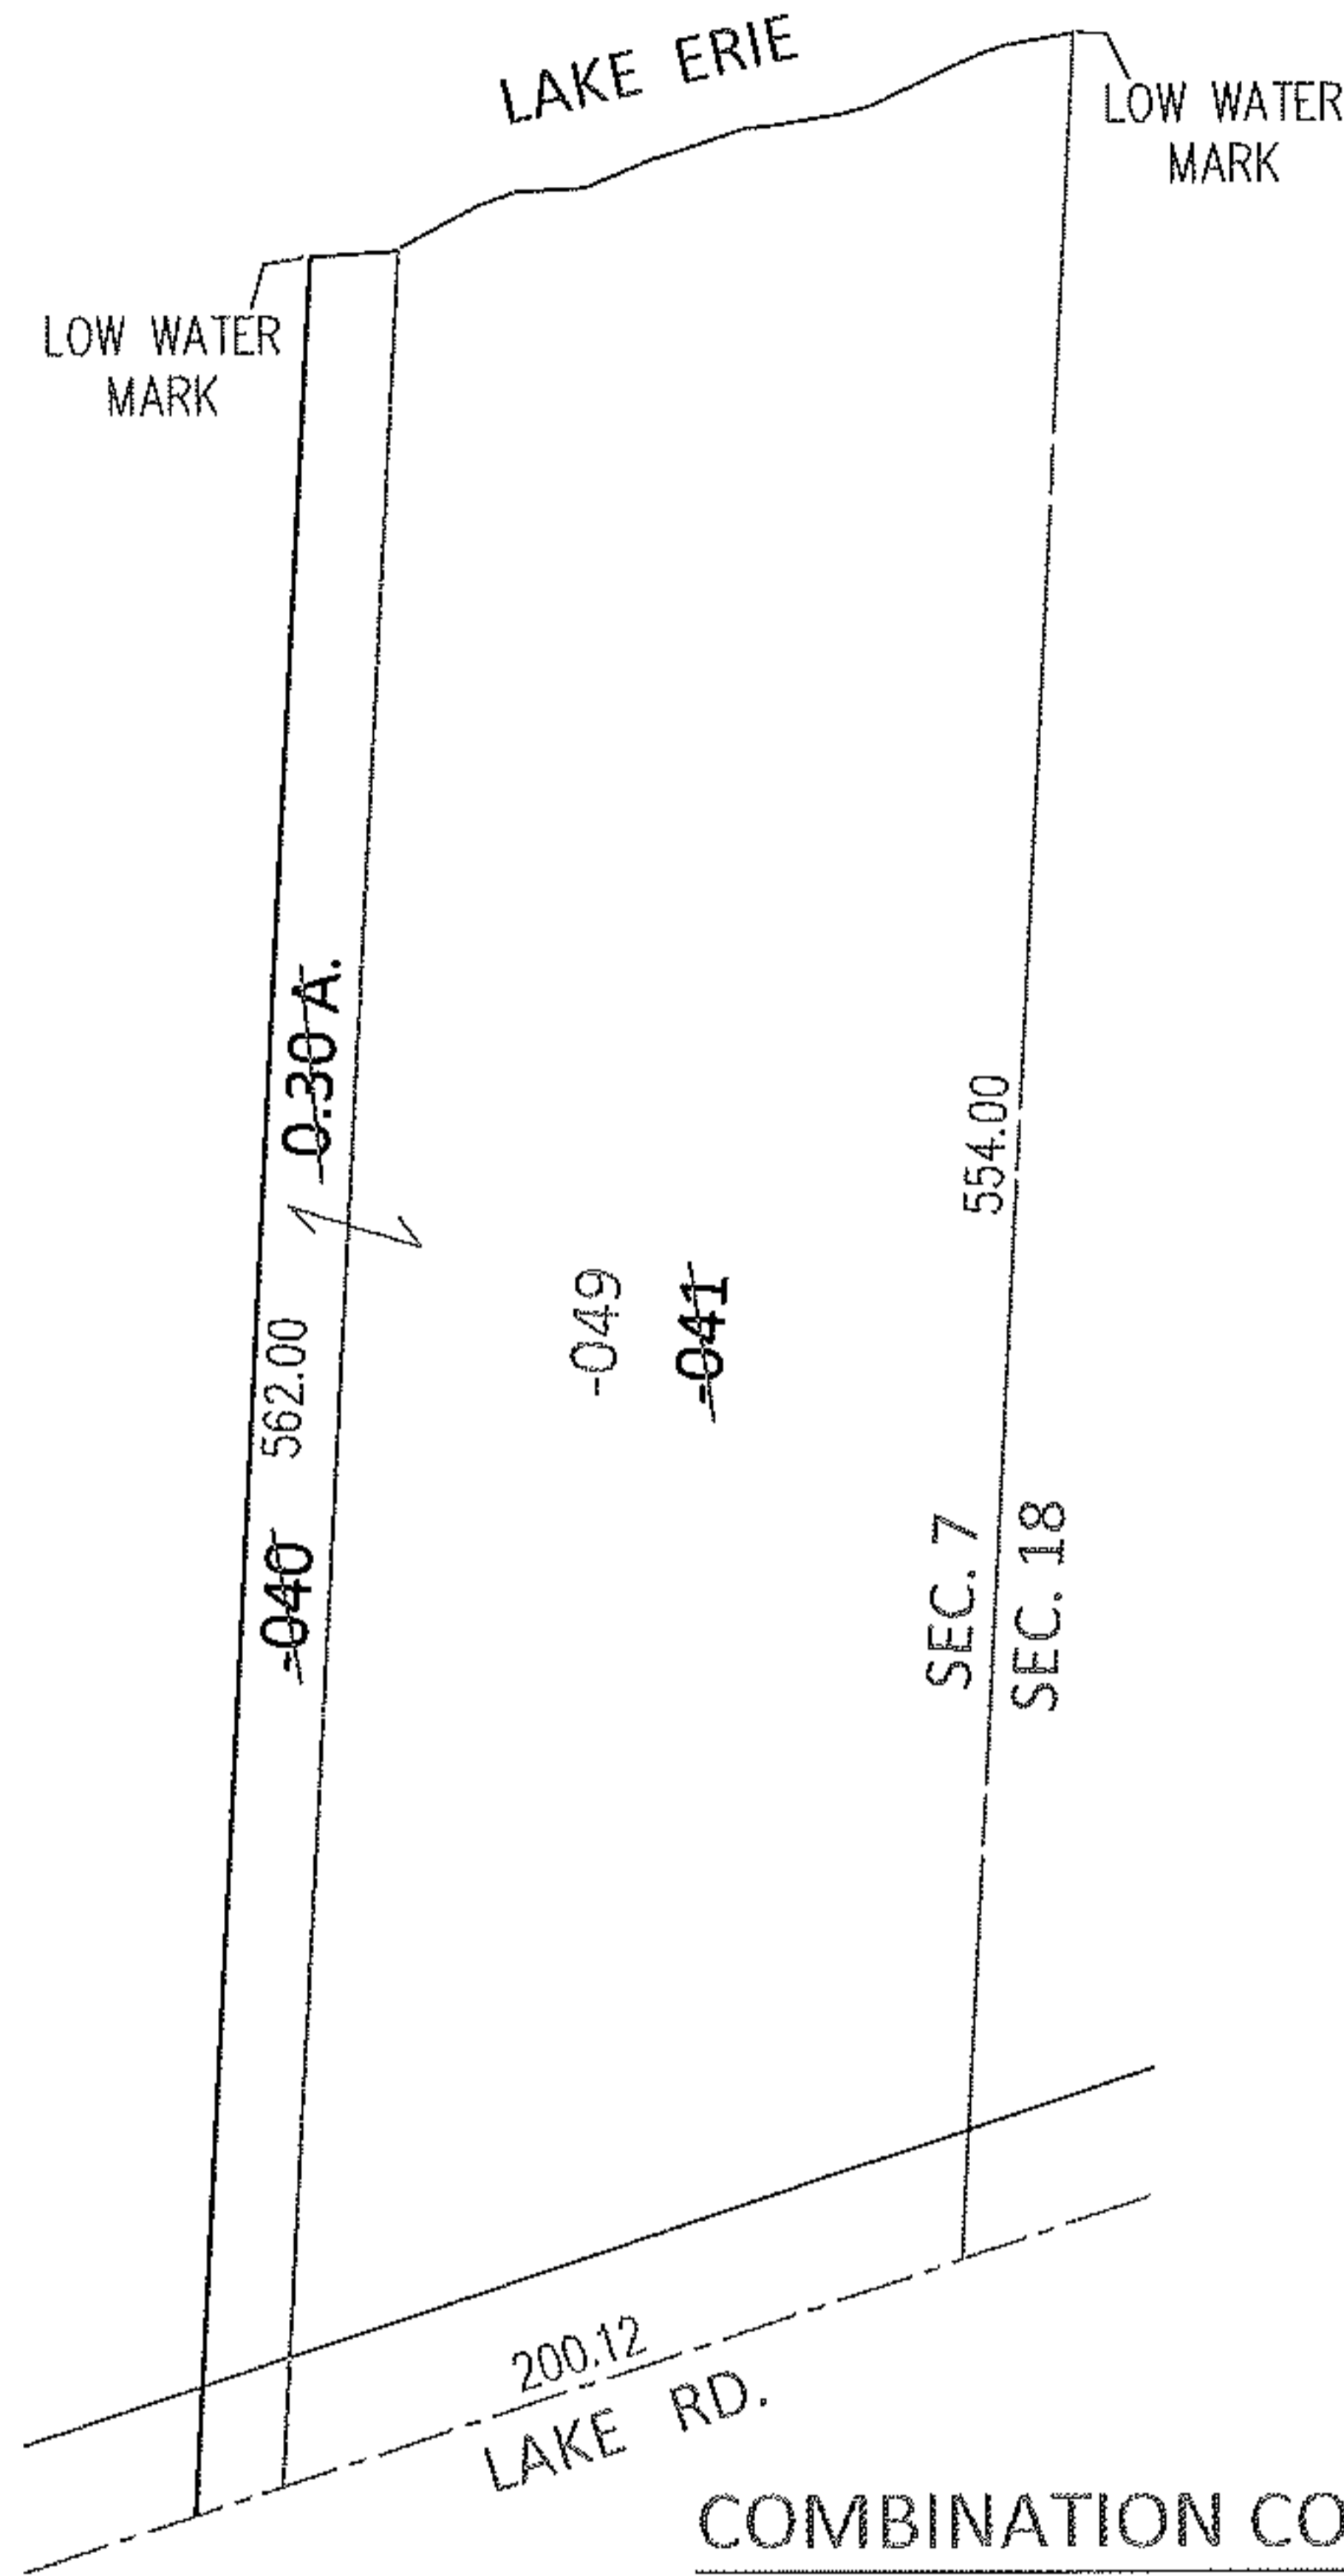


PARENT PARCEL: 04-00-007-104-040, -041

CHILD PARCEL: 04-00-007-104-049

STARTING POINT: INTERSECTION OF C/L OF LAKE RD. AND EAST LINE OF SEC. 7


13-02831-C

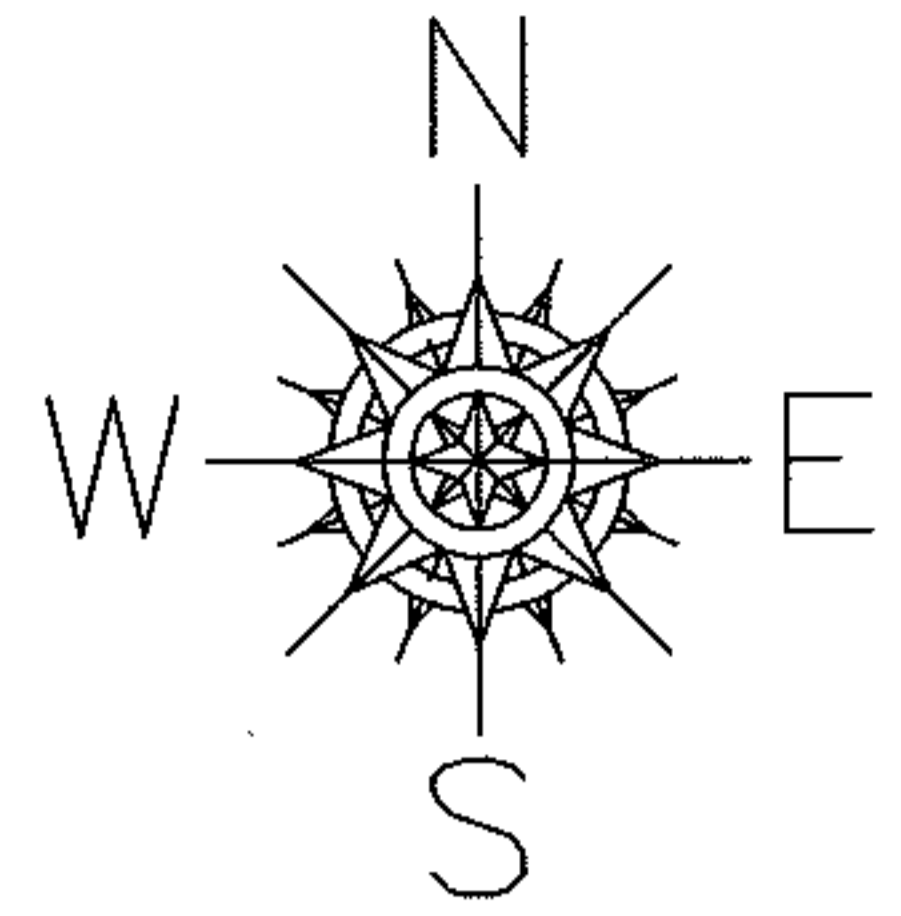

COMBINATION CORRECTION

~~04-00-007-104-040~~ ~~04-00-007-104-041~~
~~0.30 A.~~ ~~177.12 X 554~~

04-00-007-104-049
200.12 X 562
PER PRIOR DEEDS

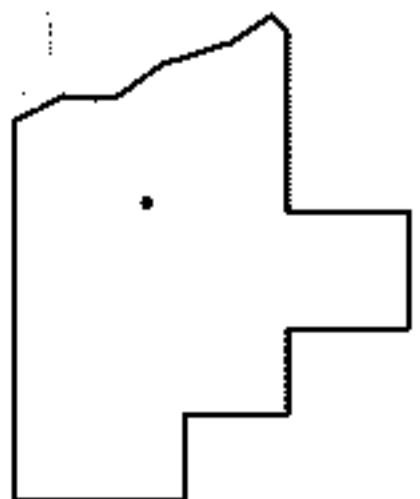

SPLITS/DEEDS PROCESSED

LORAIN COUNTY TAX MAP DEPARTMENT
226 MIDDLE AVE. ELYRIA, OHIO

SURVEYED BY:	N/A
CLOSURE:	N/A
MAP PAGE(S):	4-00-007-D
APPROVED BY:	RRM DATE: 10-23-13
SCALE:	1" = 100 PRIOR INST.: 20120416489