
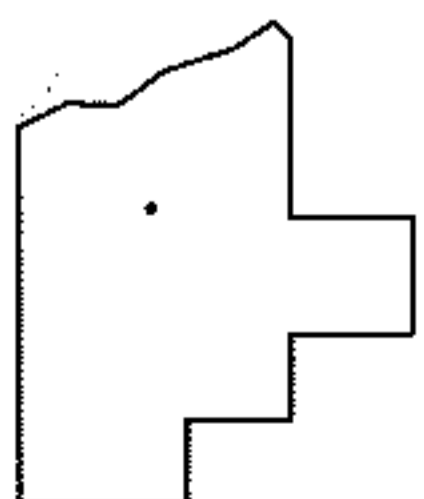
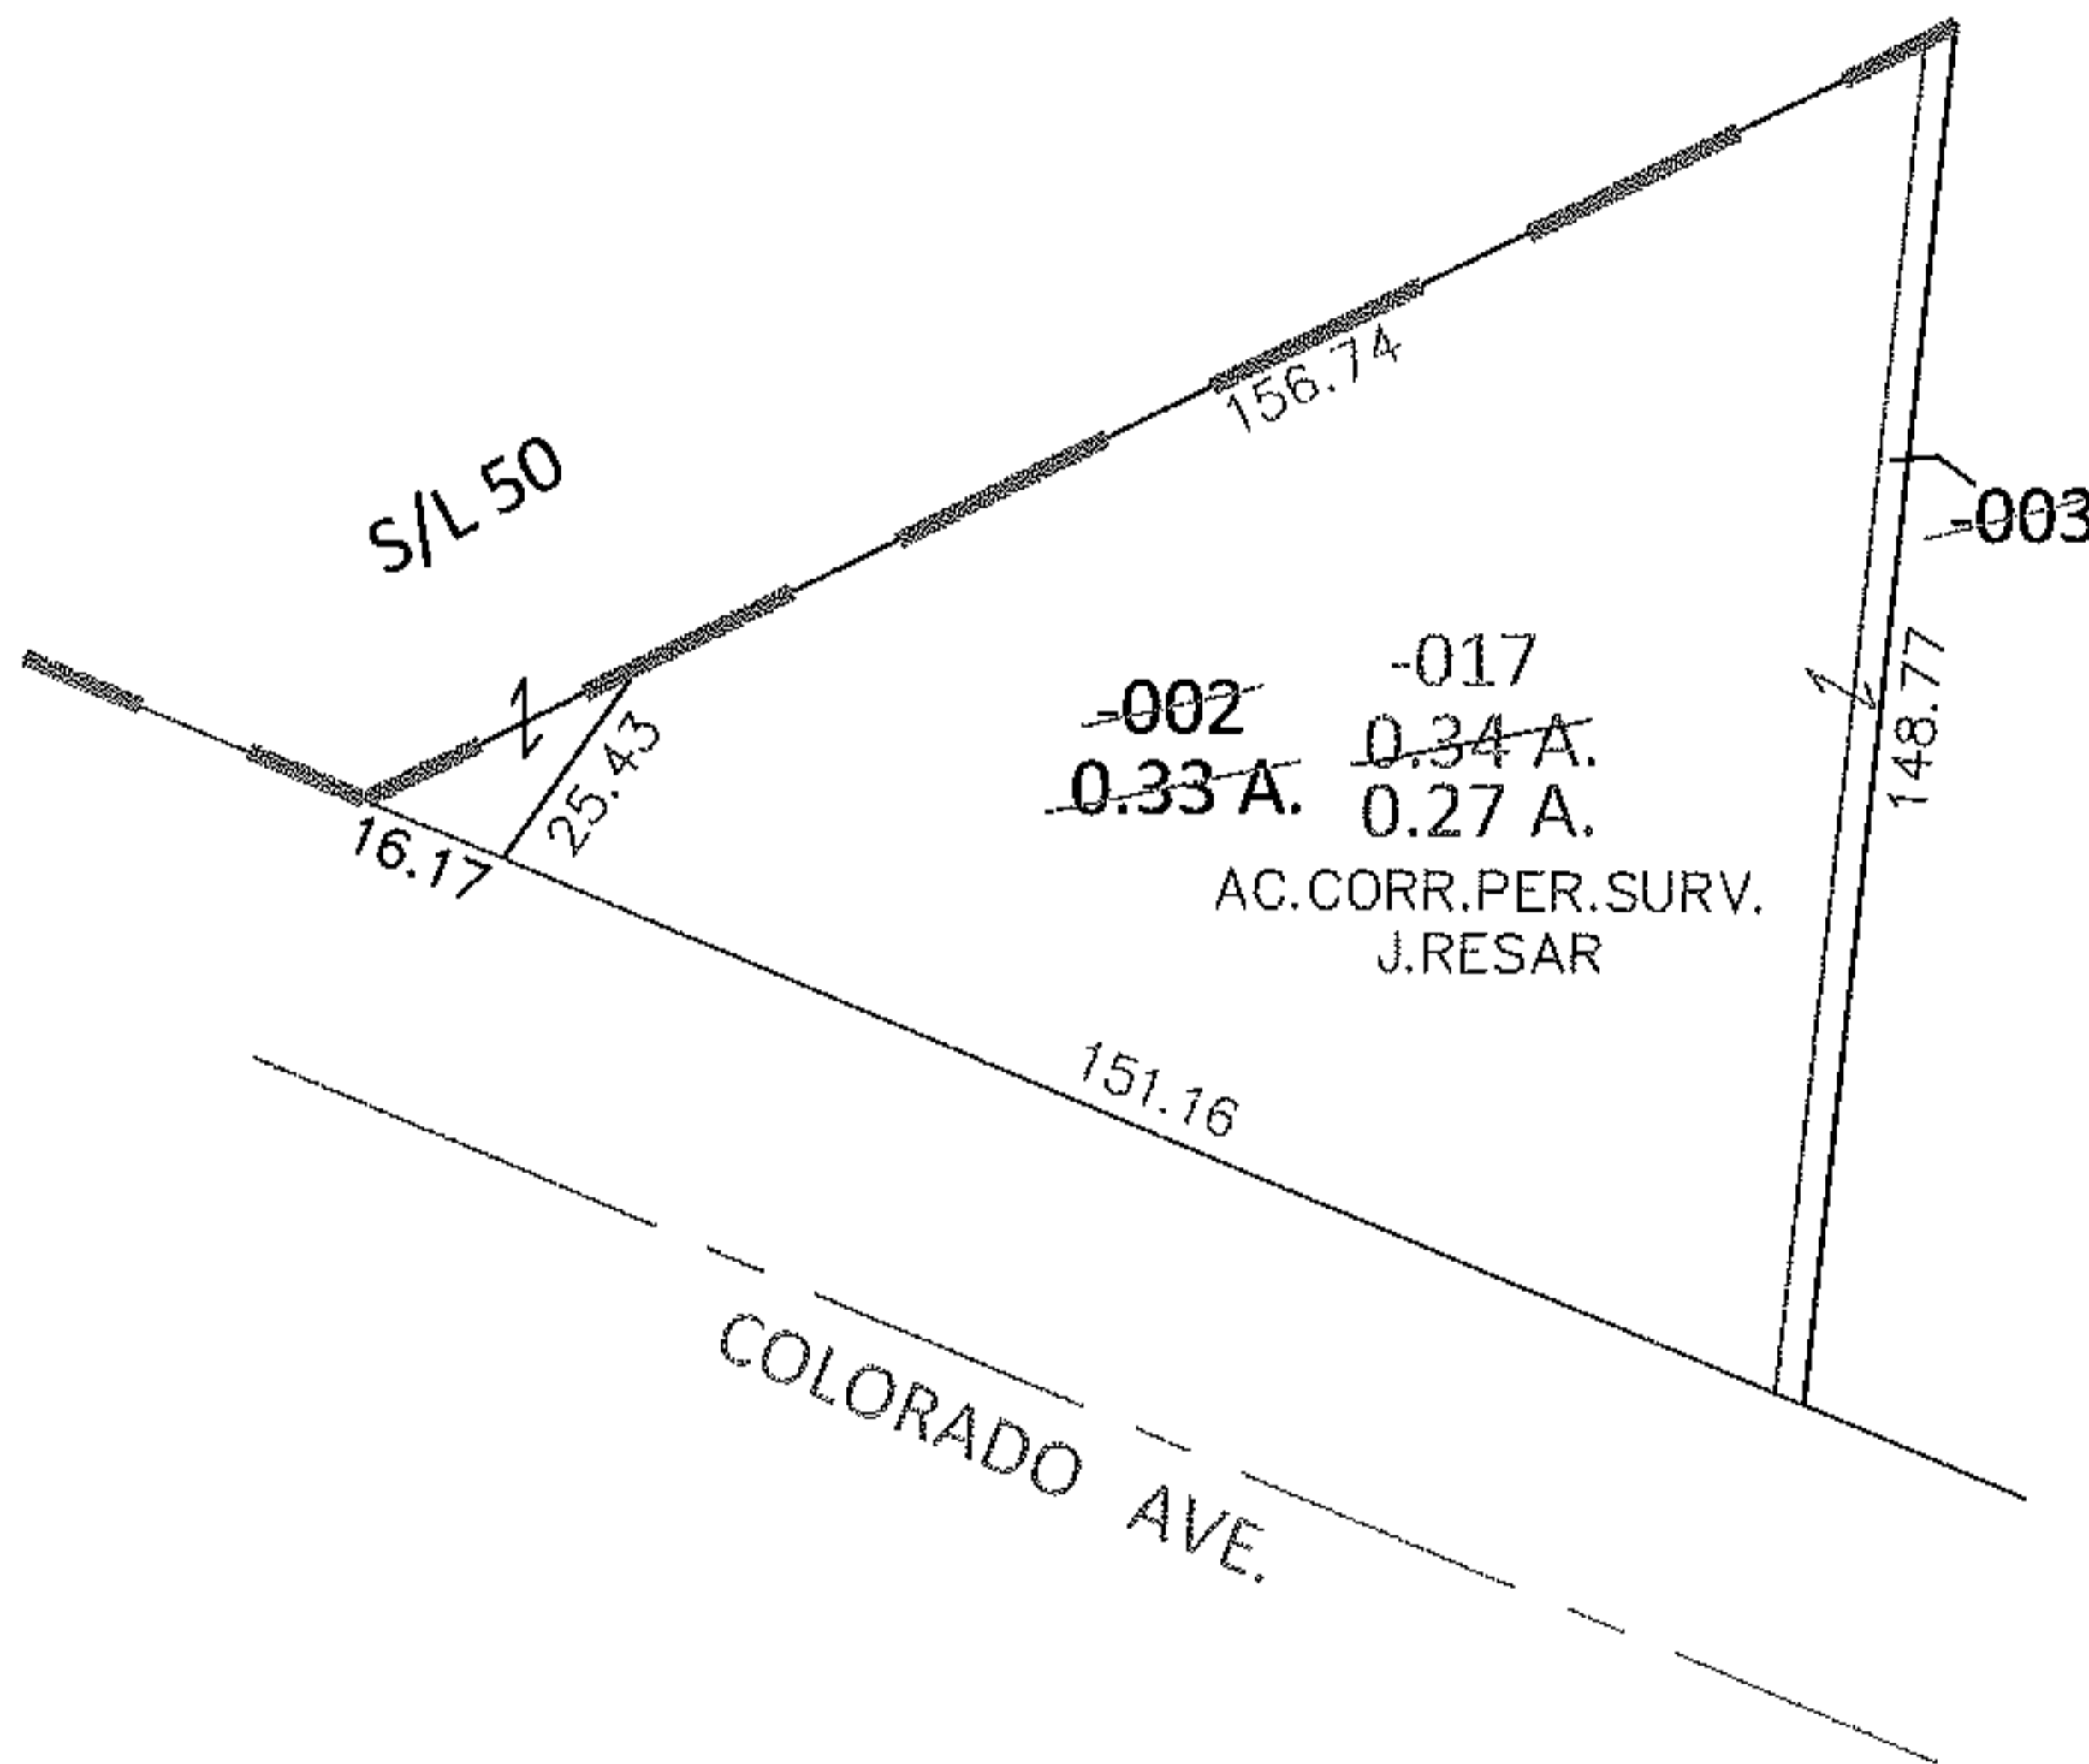


PARENT PARCEL: 02-00-051-135-002, -003

CHILD PARCEL: 02-00-051-135-017

STARTING POINT: SOUTHEAST CORNER OF S/L 50 IN W.B. THOMPSON TRUSTEE'S ADD. (VOL.5 PG.7)

13-02832-D

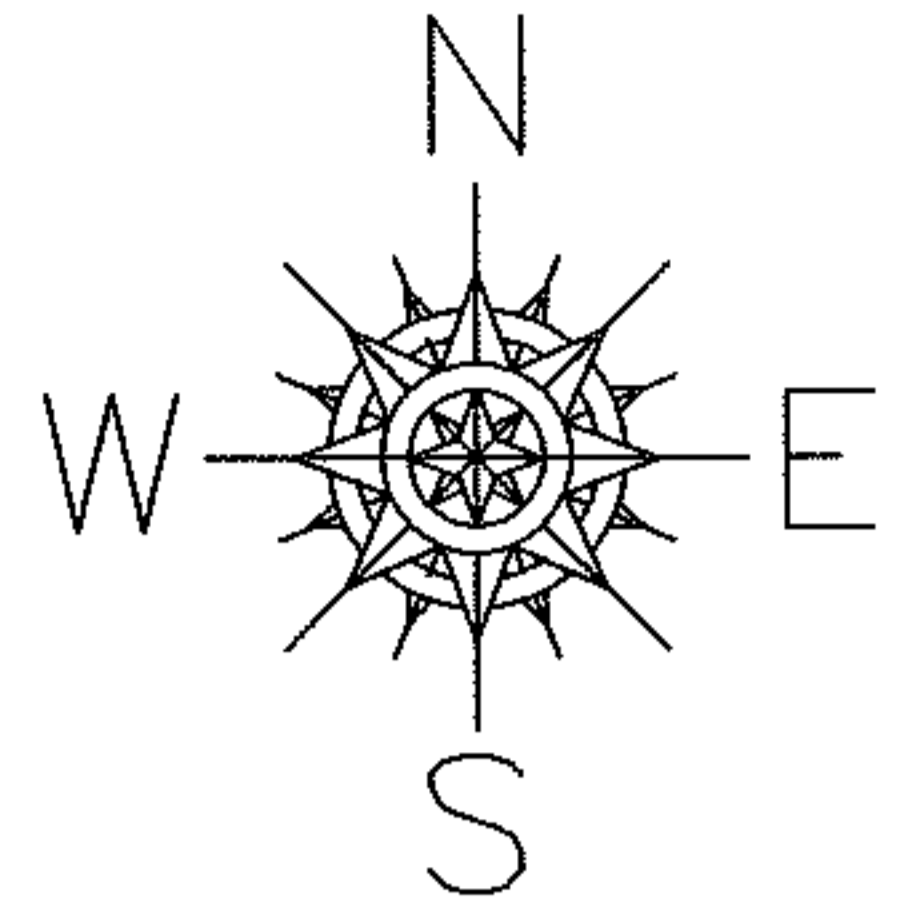

SPLITS/DEEDS PROCESSED

LORAIN COUNTY TAX MAP DEPARTMENT
226 MIDDLE AVE. ELYRIA, OHIO

SURVEYED BY: JAMES A. RESAR

CLOSURE: .01:10,000

MAP PAGE(S): 2-00-051-B

APPROVED BY: RRM DATE: 10-28-13

SCALE: 1" = 50' PRIOR INST.: DV 1410/872