


PARENT PARCEL: 01-00-056-000-087



CHILD PARCEL: 01-00-056-000-088, -089

STARTING POINT: CENTERLINE OF RICE RD & O.L. 56

10-02834

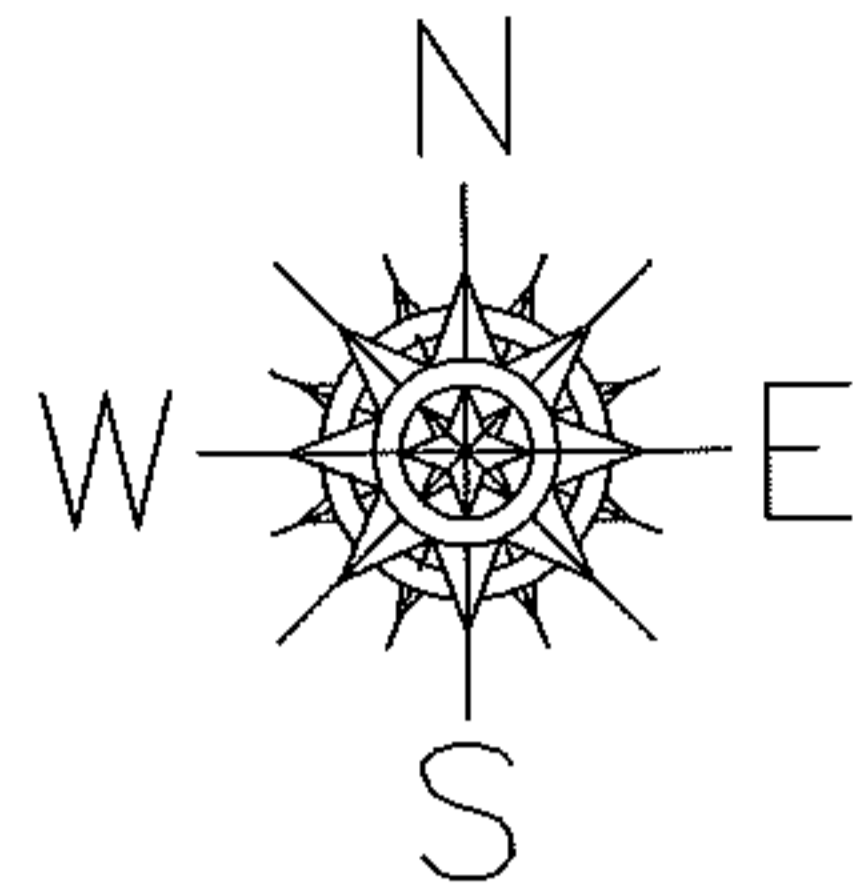

~~=087~~  
~~42.69 A.~~  
-089  
40.69 A.

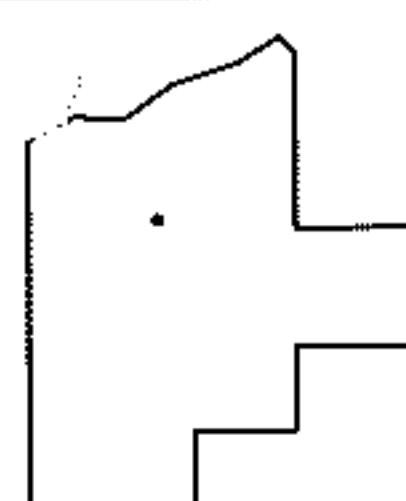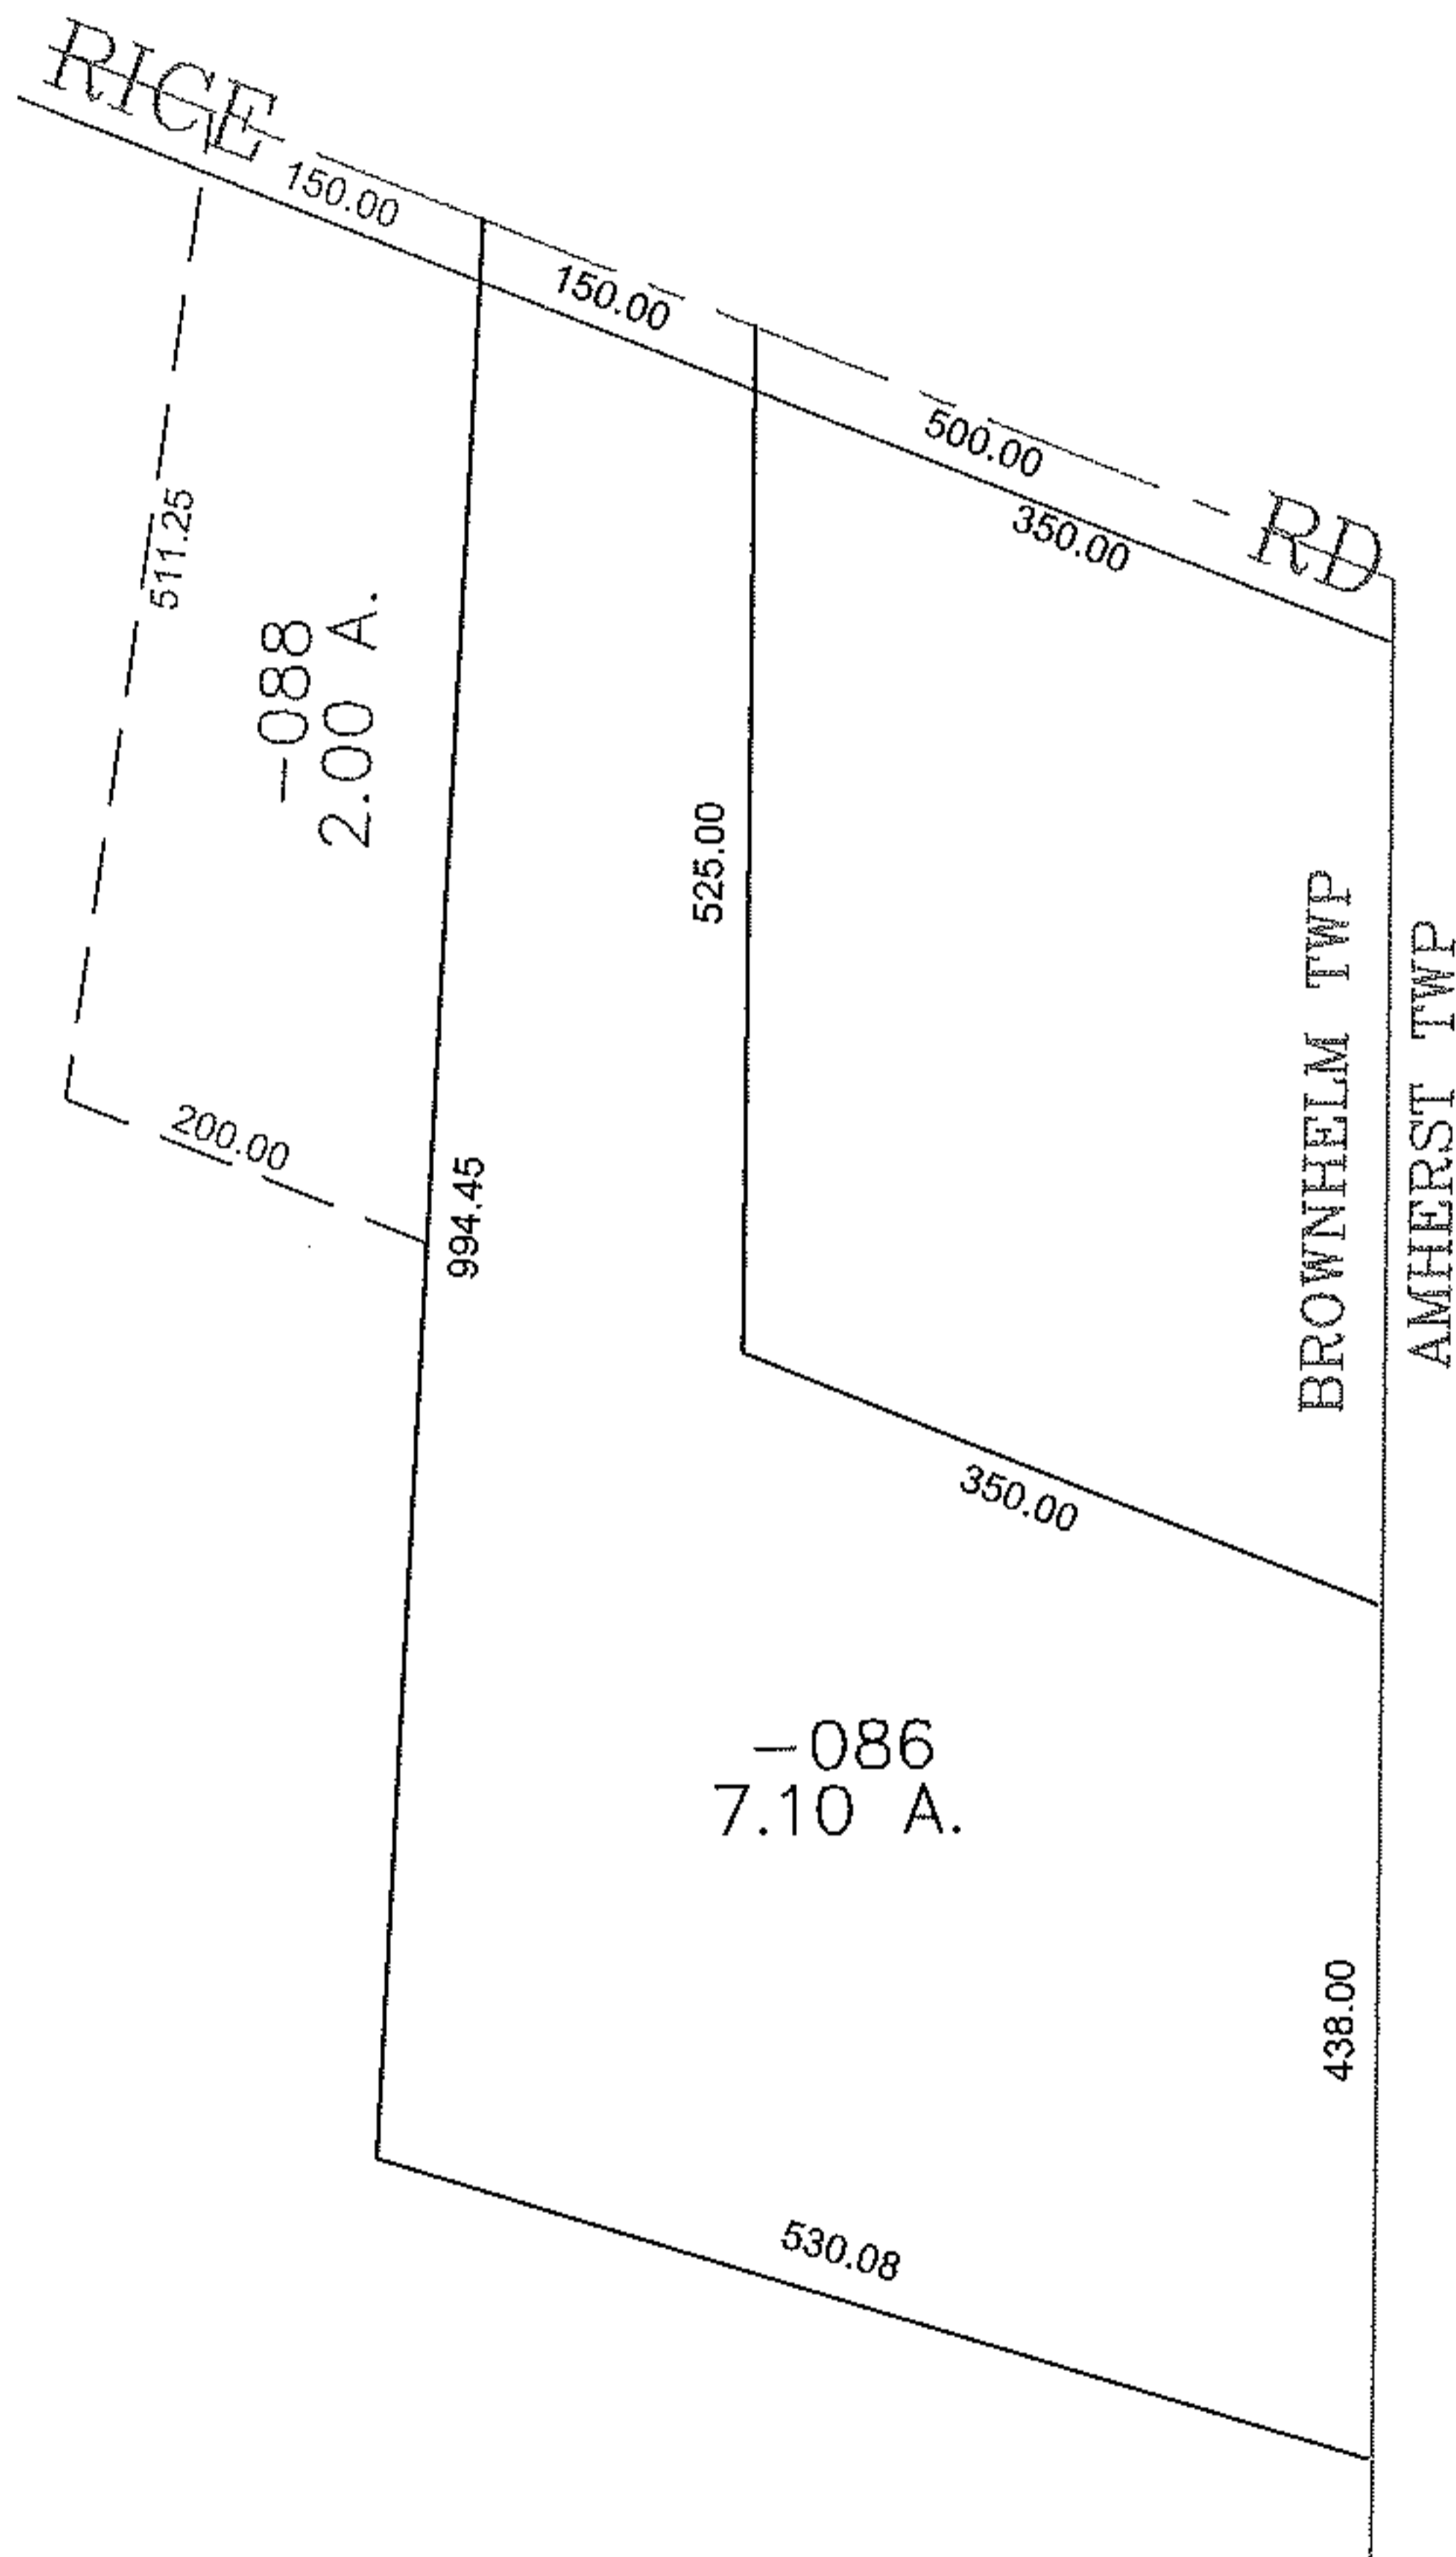

**SPLITS/DEEDS PROCESSED**  
LORAIN COUNTY TAX MAP DEPARTMENT  
226 MIDDLE AVE. ELYRIA, OHIO

SURVEYED BY: THOMAS SIMON  
CLOSURE: 0.00 : 10,000  
MAP PAGE(S): 1-L  
APPROVED BY: JAH DATE: 6-8-10  
SCALE: 1" = 200 PRIOR INSTRUMENT: 19990627543