


PARENT PARCEL: 03-00-100-105-041

CHILD PARCEL: 03-00-100-105-042, -043


13-02835-U

STARTING POINT: EAST 20 FEET OF S/L'S 46 AND 47 IN OAKWOOD DEVELOPMENT CO. SUB. NO.1 (VOL.14 PG.33)

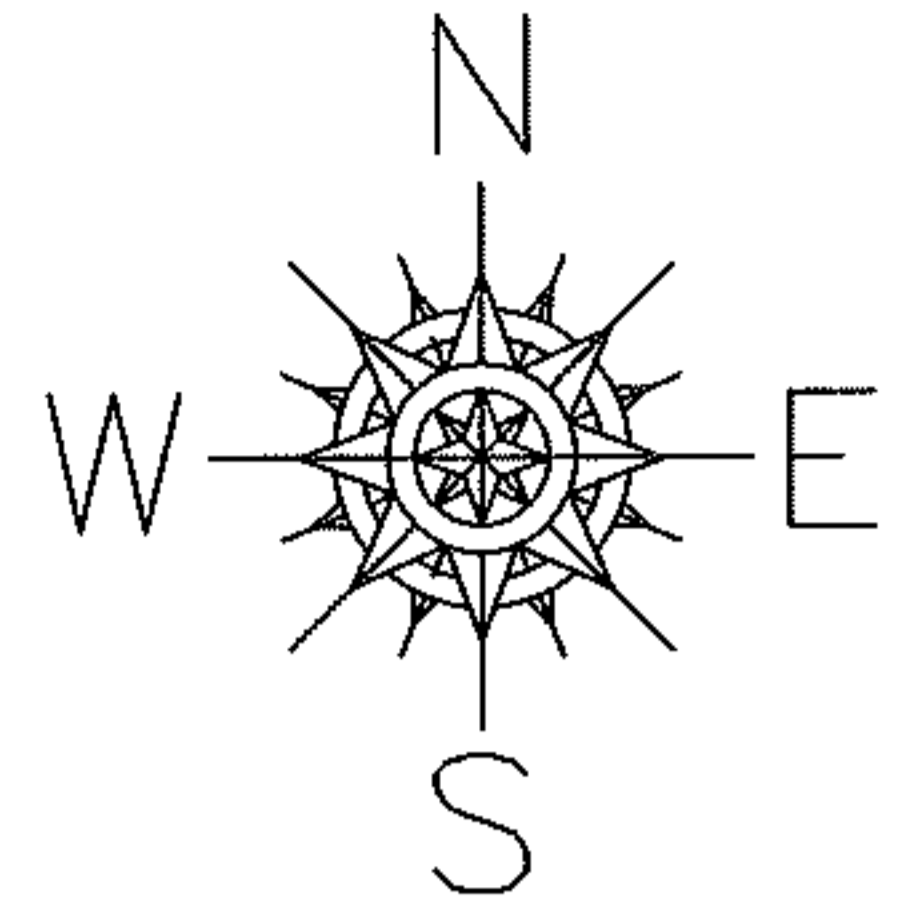

37TH ST.

PEARL AVE.

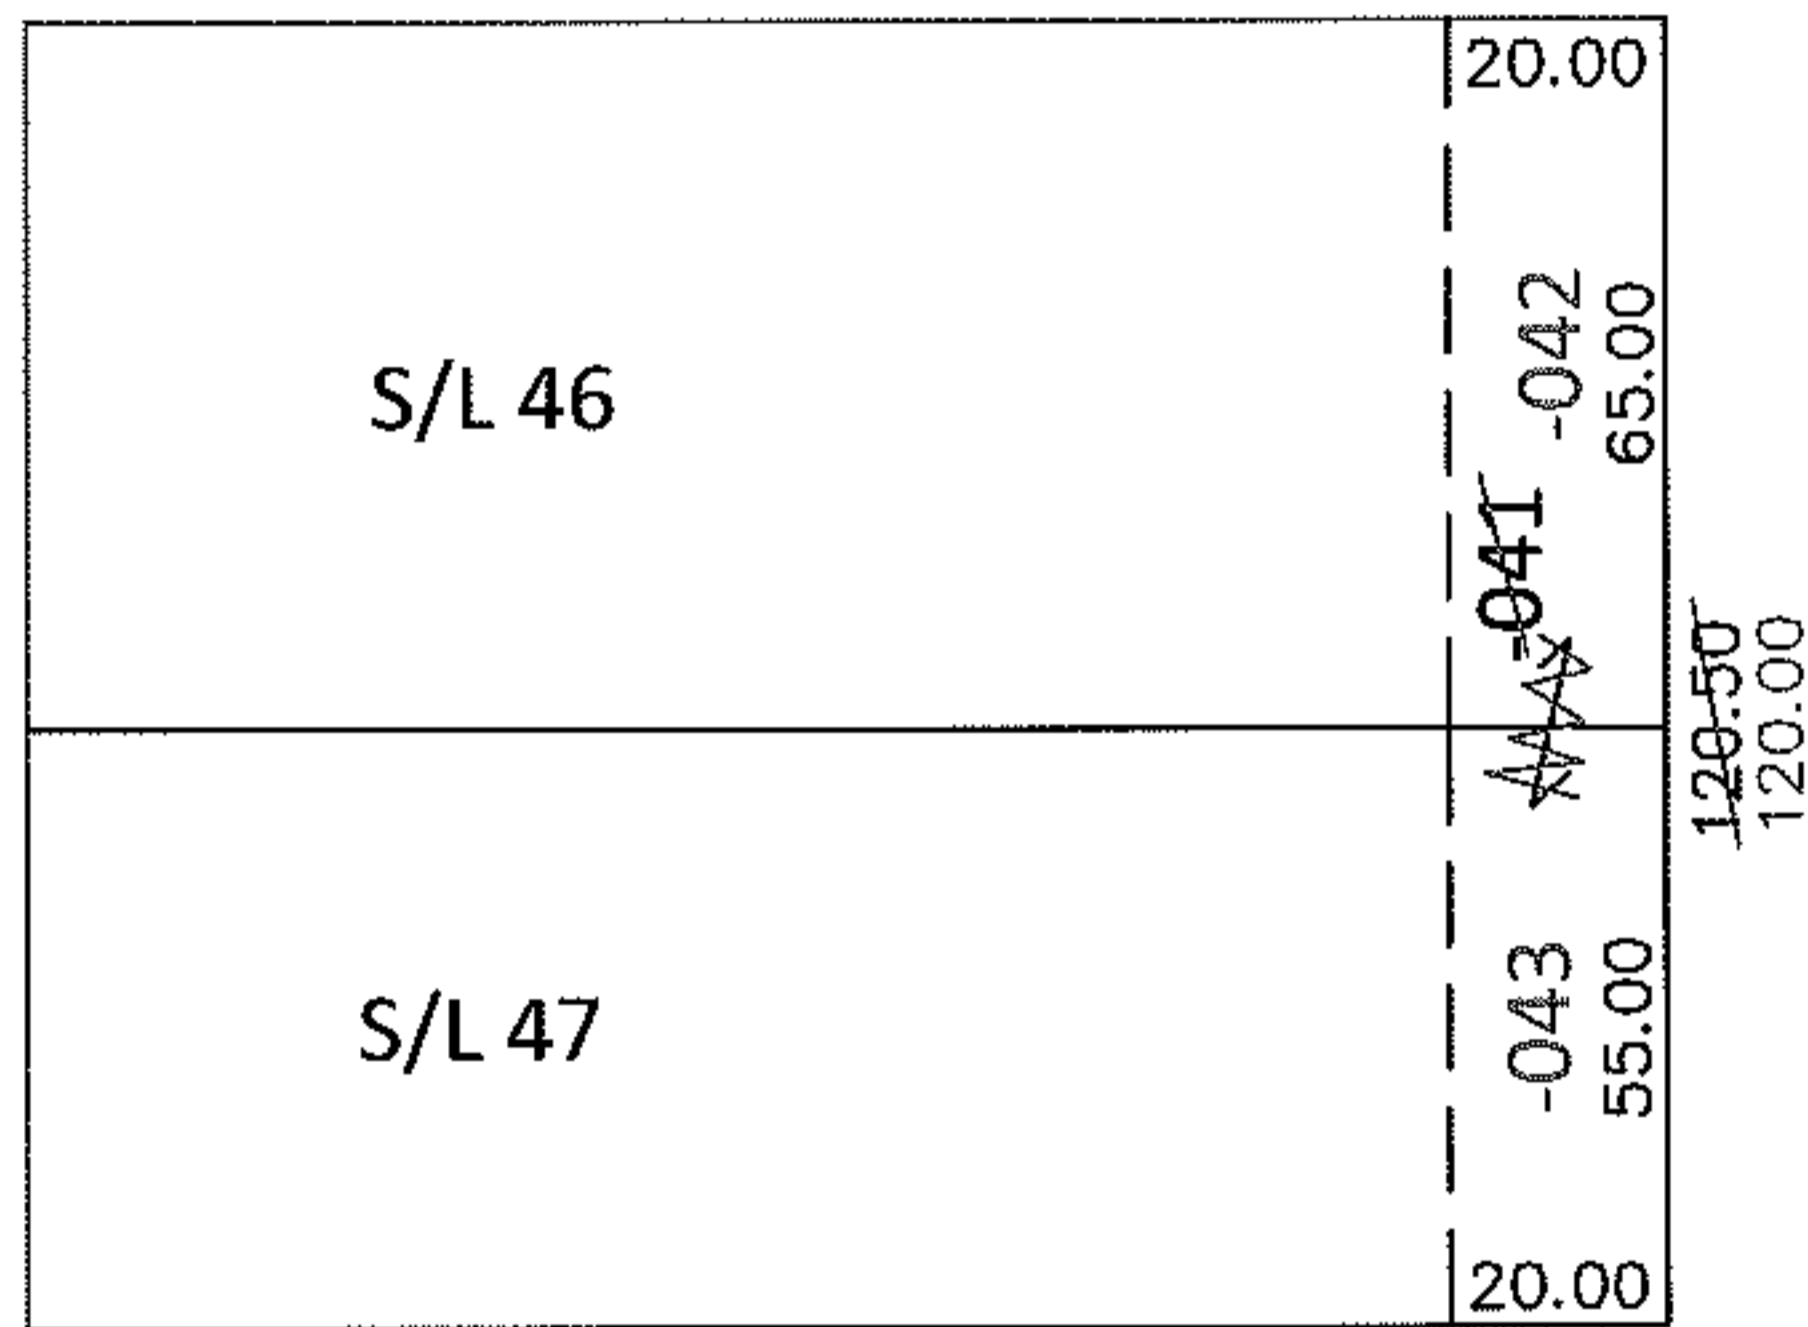

UNCOMBINATION

~~03-00-100-105-041~~
~~20 X 120.50~~

03-00-100-105-042 03-00-100-105-043
20 X 65 20 X 55

PER PRIOR DEEDS
TO REMOVE UPDATE LEGAL
FOR 2 LEGALS, 1 PARCEL NO.

SPLITS/DEEDS PROCESSED

LORAIN COUNTY TAX MAP DEPARTMENT
226 MIDDLE AVE. ELYRIA, OHIO

SURVEYED BY: N/A
CLOSURE: N/A
MAP PAGE(S): 3-00-100-A
APPROVED BY: RRM DATE: 10-28-13
SCALE: 1" = 50' PRIOR INST.: 20120415827

