
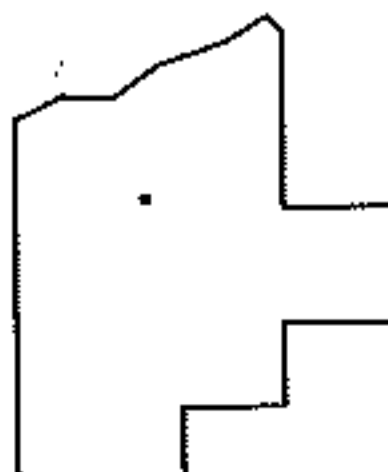
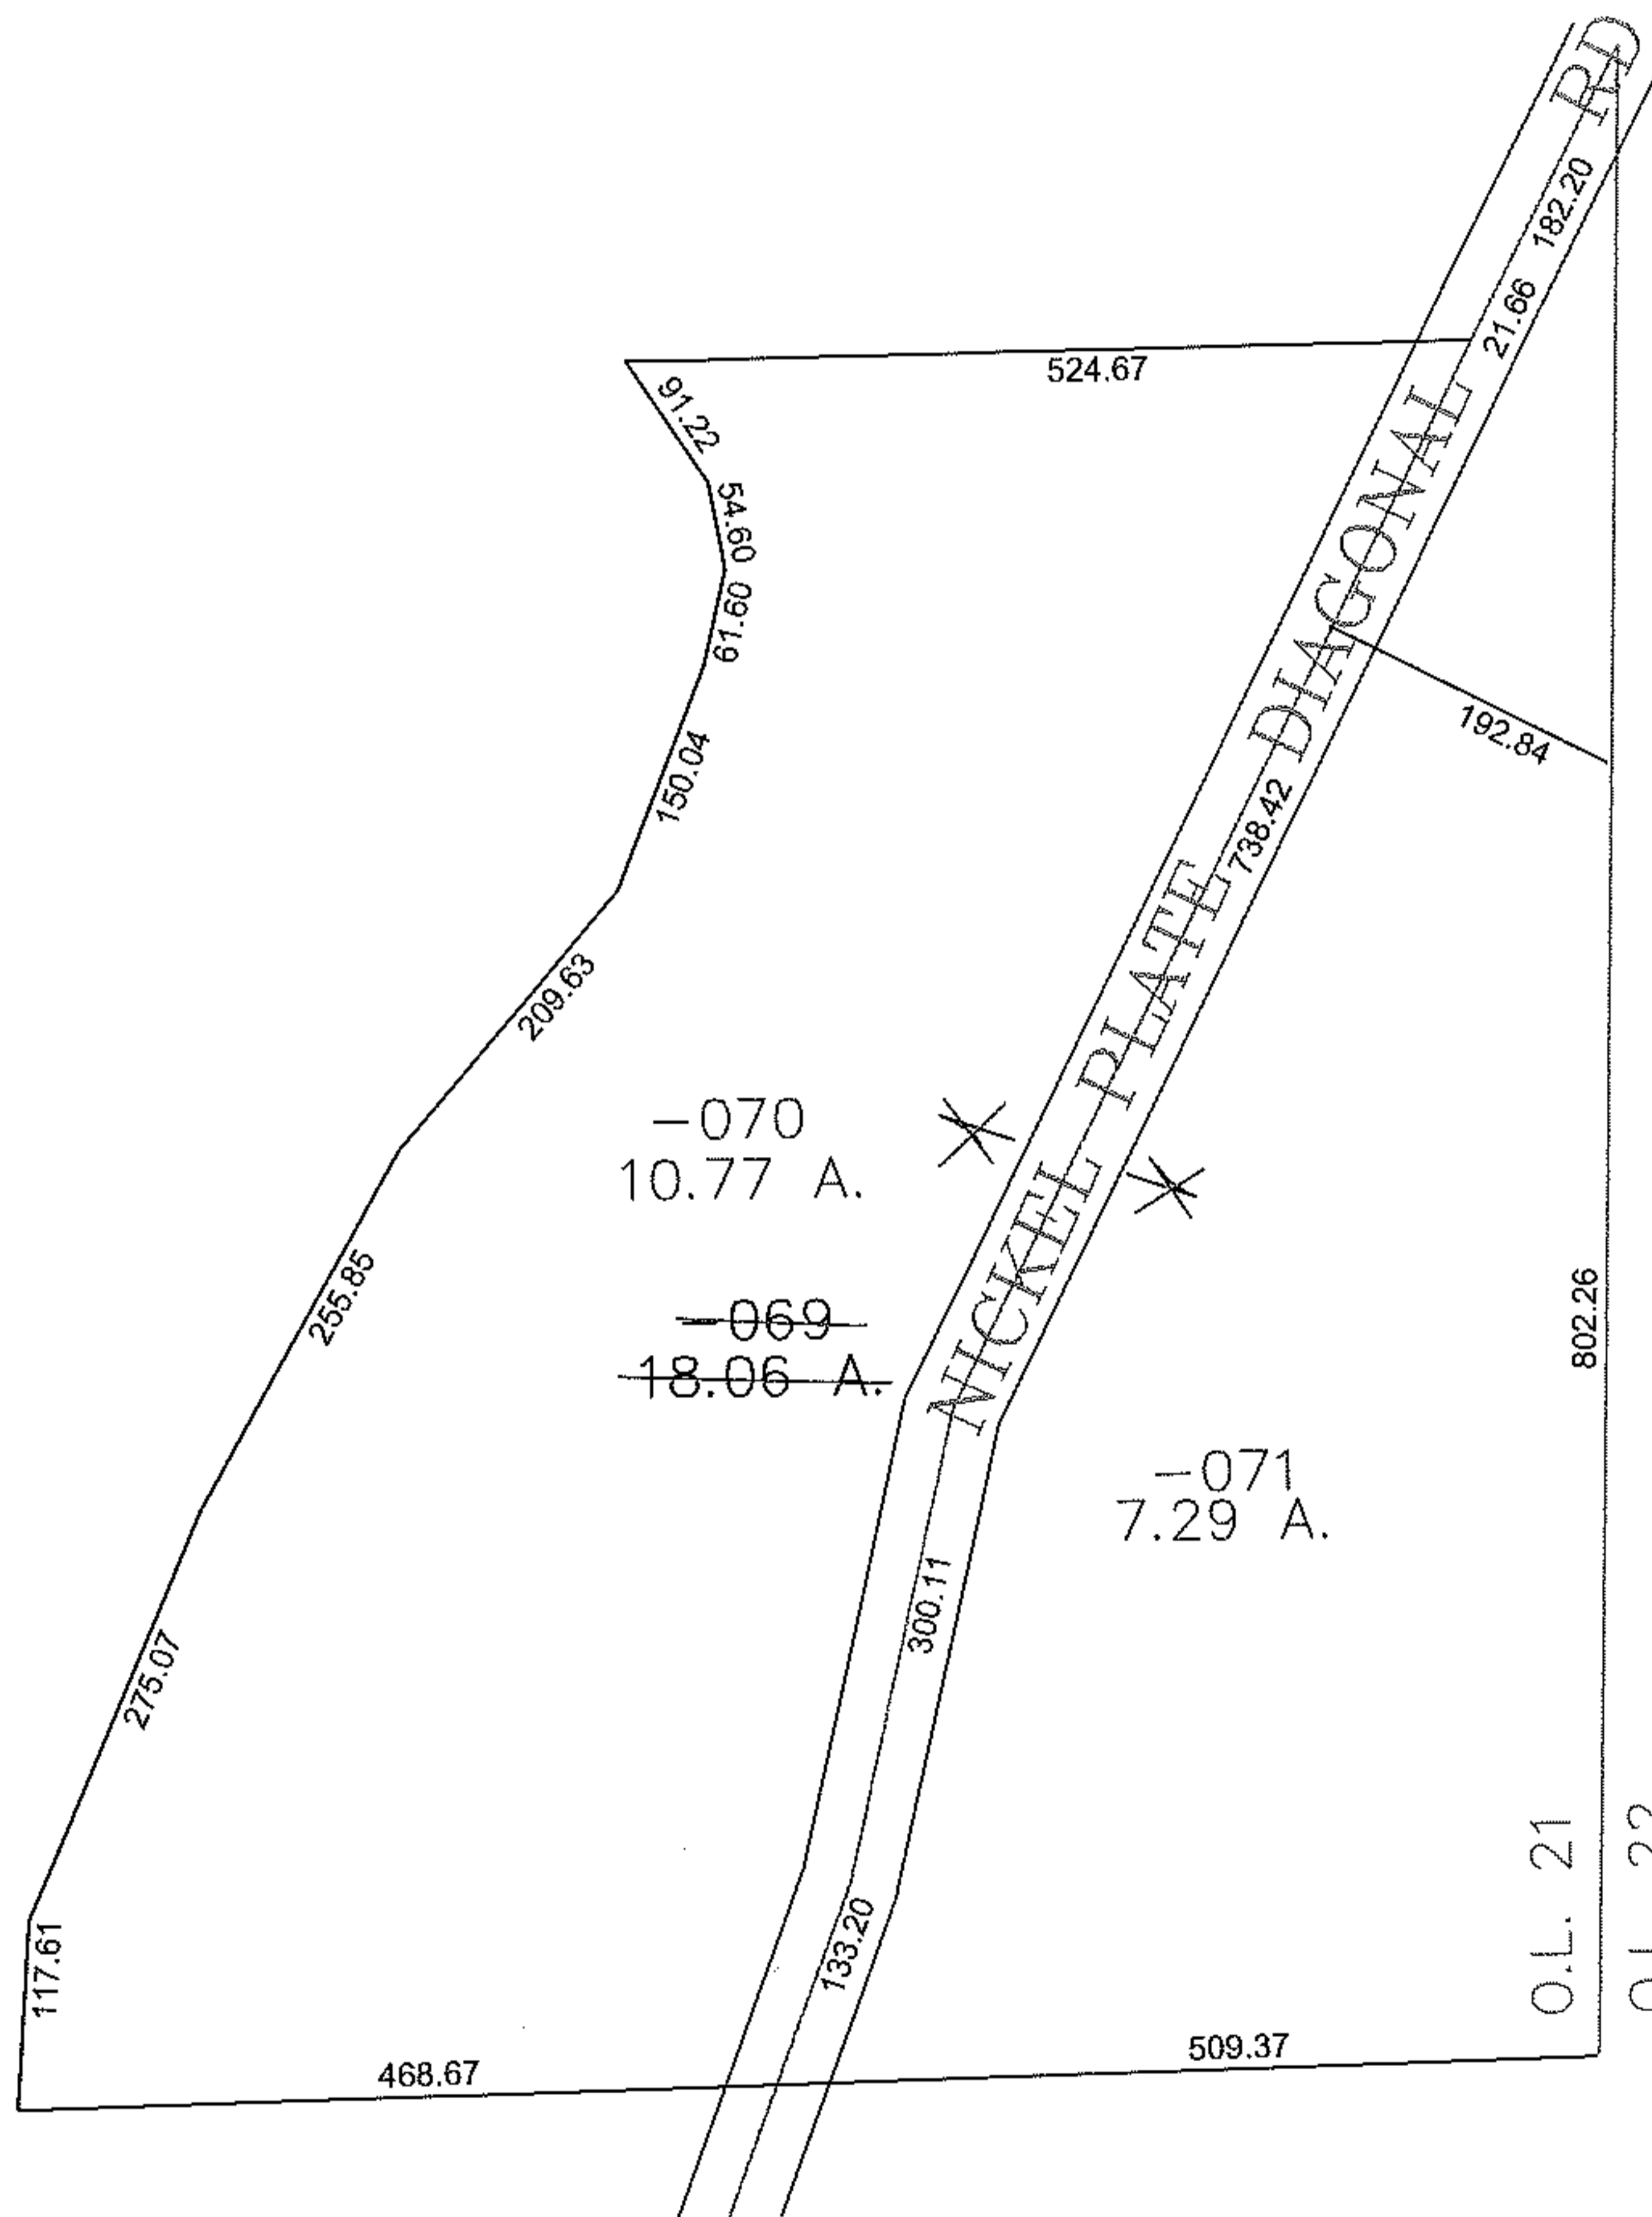


PARENT PARCEL: 10-00-021-000-069

CHILD PARCEL: 10-00-021-000-070, -071

STARTING POINT: CENTERLINE OF NICKEL PLATE DIAGONAL RD & O.L. 21

10-02835

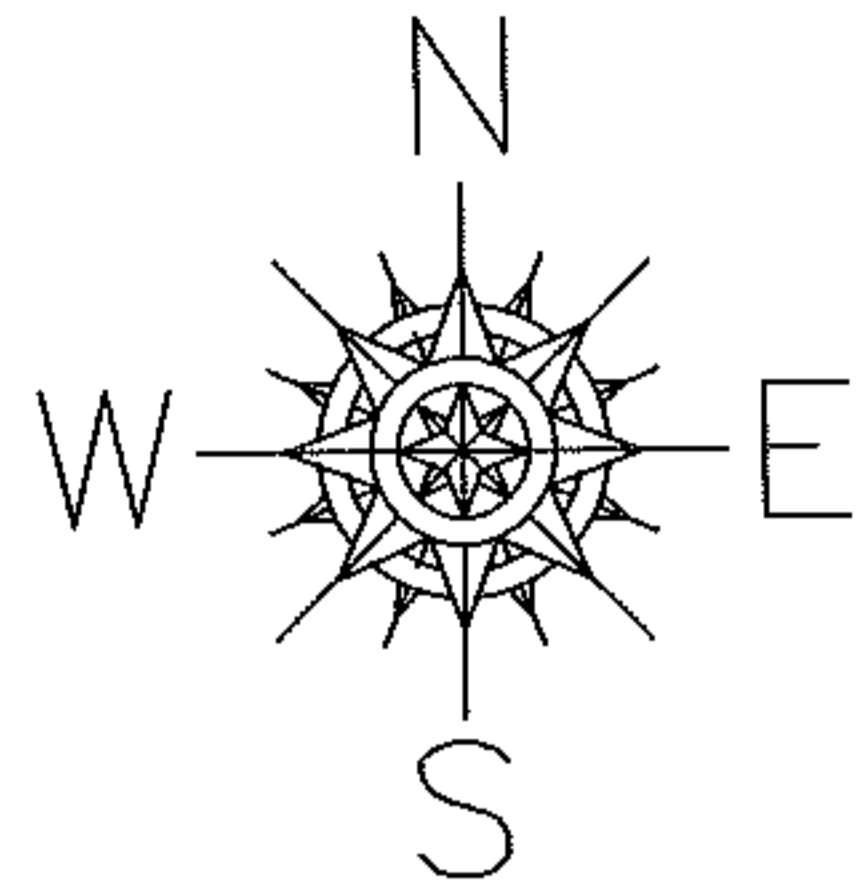

SPLITS/DEEDS PROCESSED

LORAIN COUNTY TAX MAP DEPARTMENT
226 MIDDLE AVE. ELYRIA, OHIO

SURVEYED BY: THOMAS SIMON
 CLOSURE: 0.00 : 10,000
 MAP PAGE(S): 10-00-021-D
 APPROVED BY: JAH DATE: 6-8-2010
 SCALE: 1" = 200 PRIOR INSTRUMENT: 20070189269