
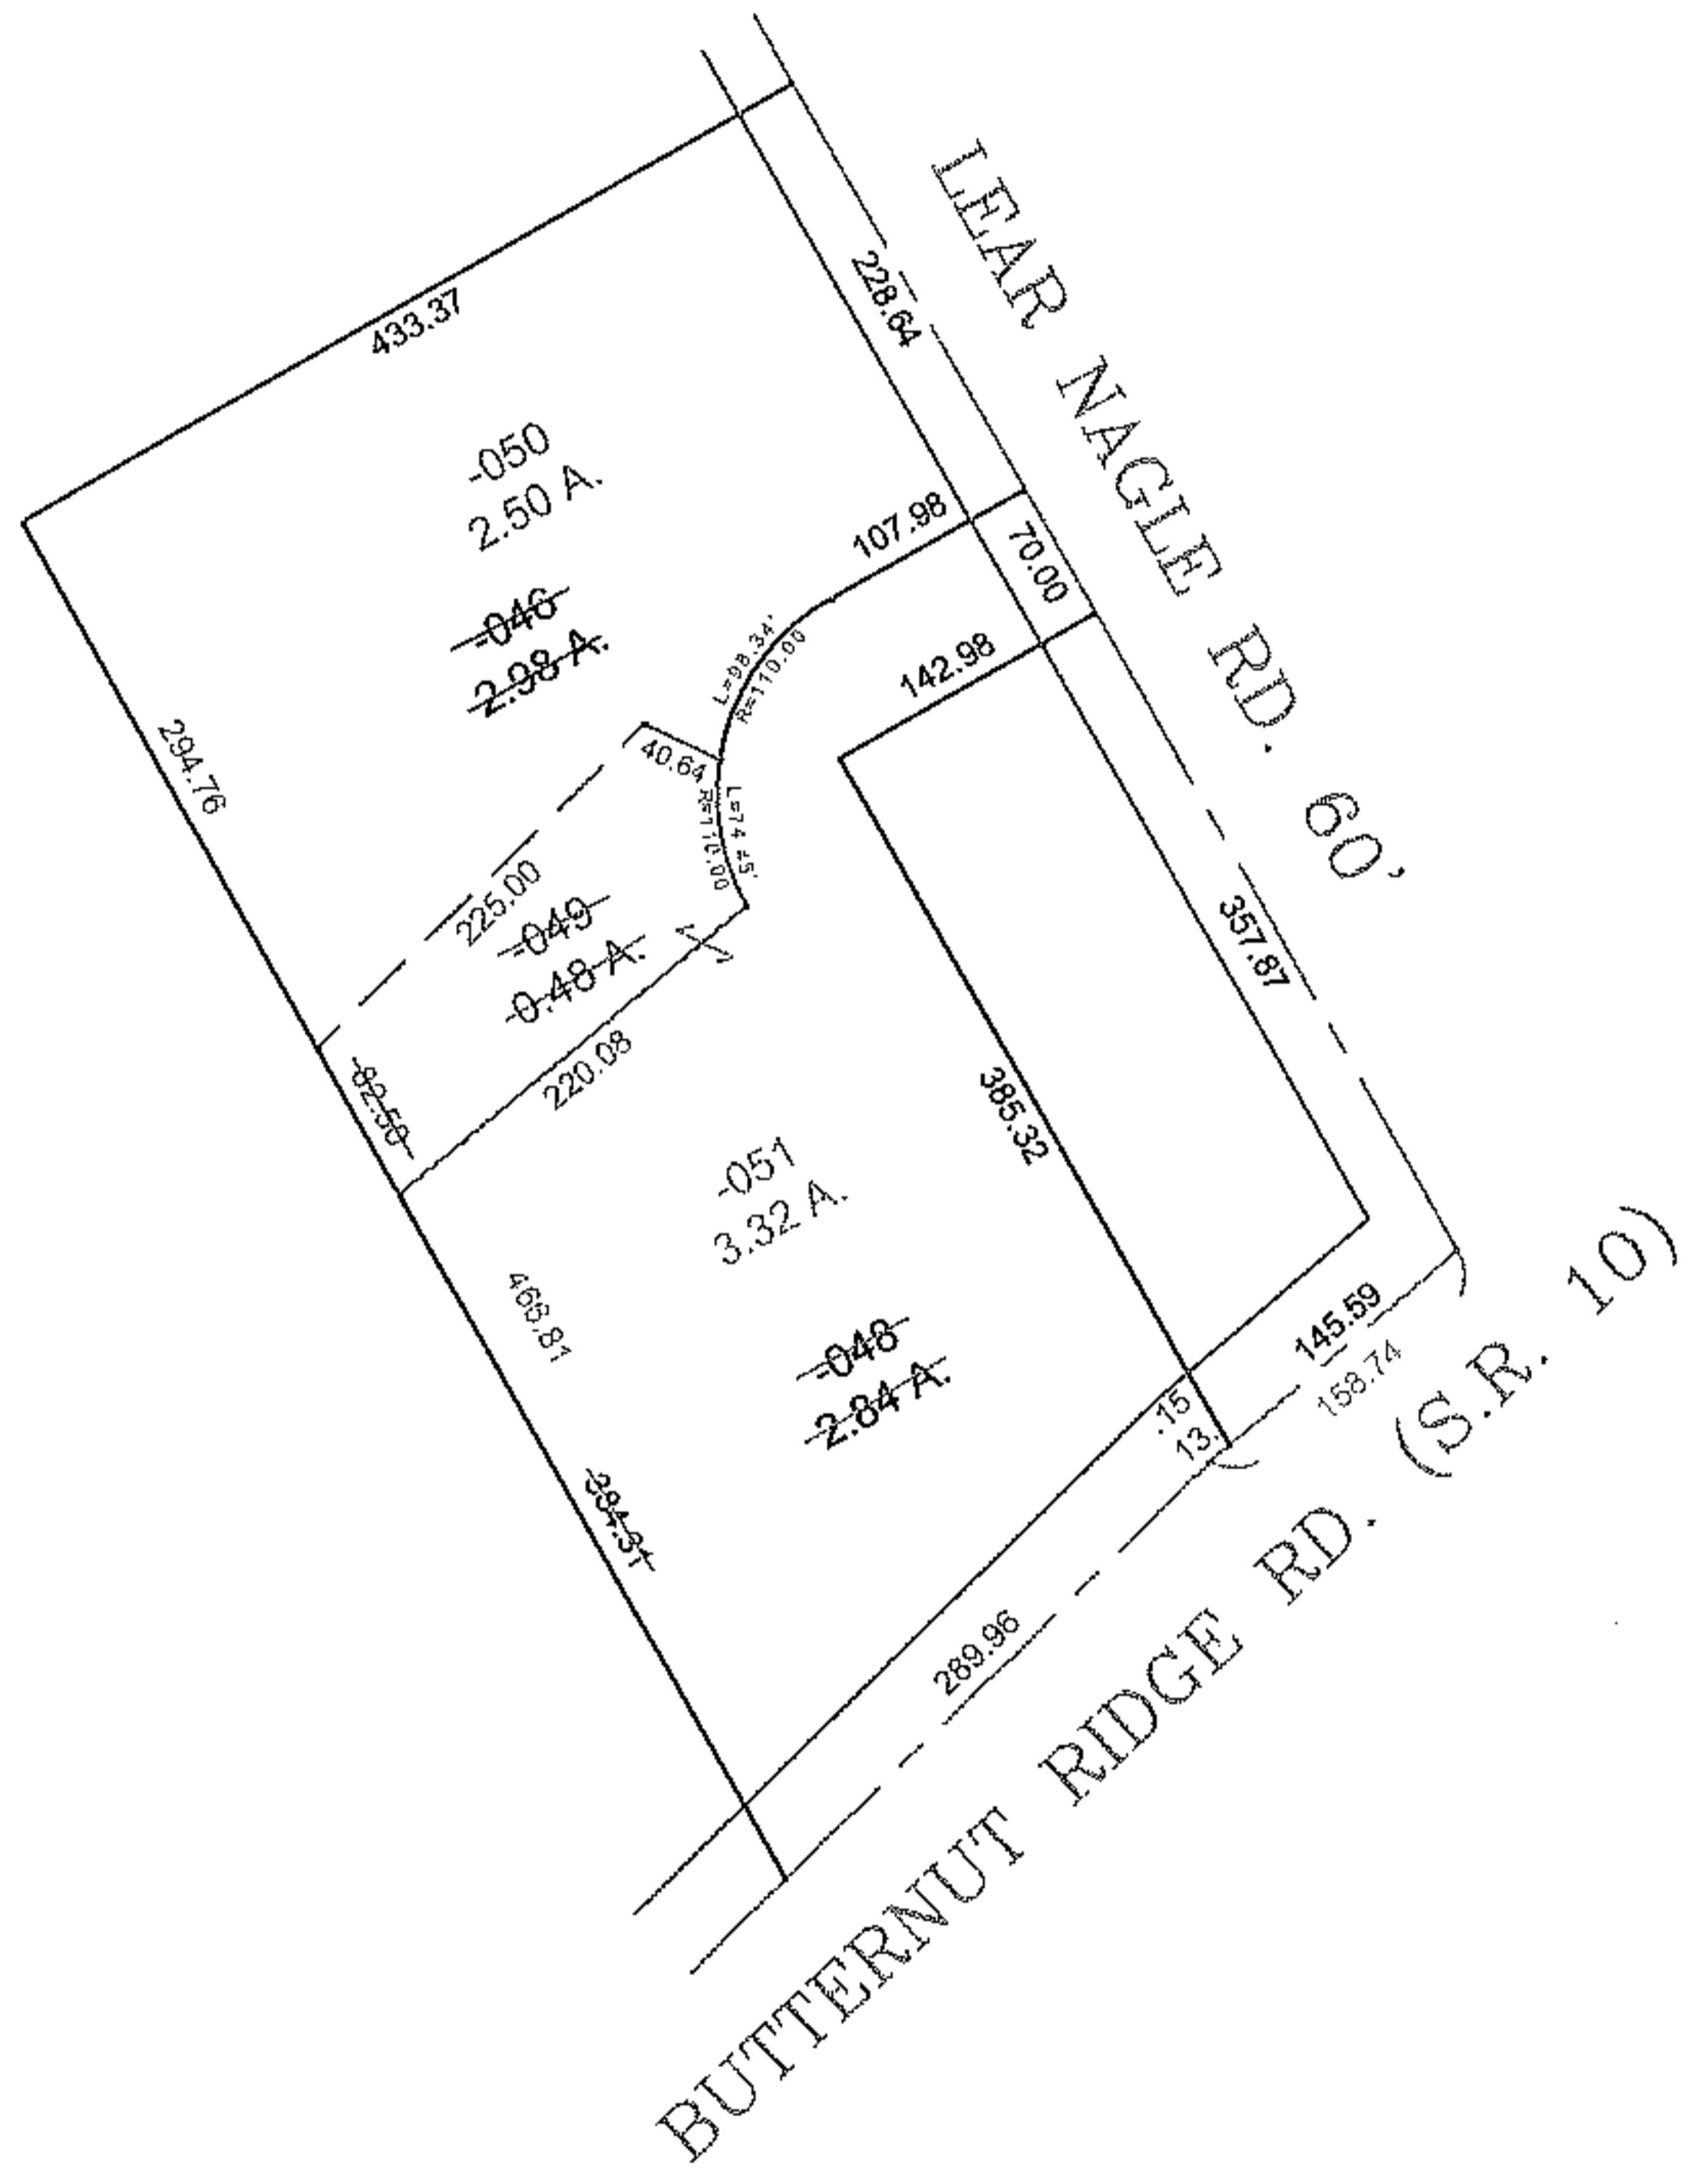


PARENT PARCEL: 07-00-004-109-046 & -048
 CHILD PARCEL: 07-00-004-109-049 THRU -051
 STARTING POINT: NAIL FD. , CL OF BUTTERNUT RIDGE RD. & CL OF LEAR NAGLE RD.

NO. 10-02836

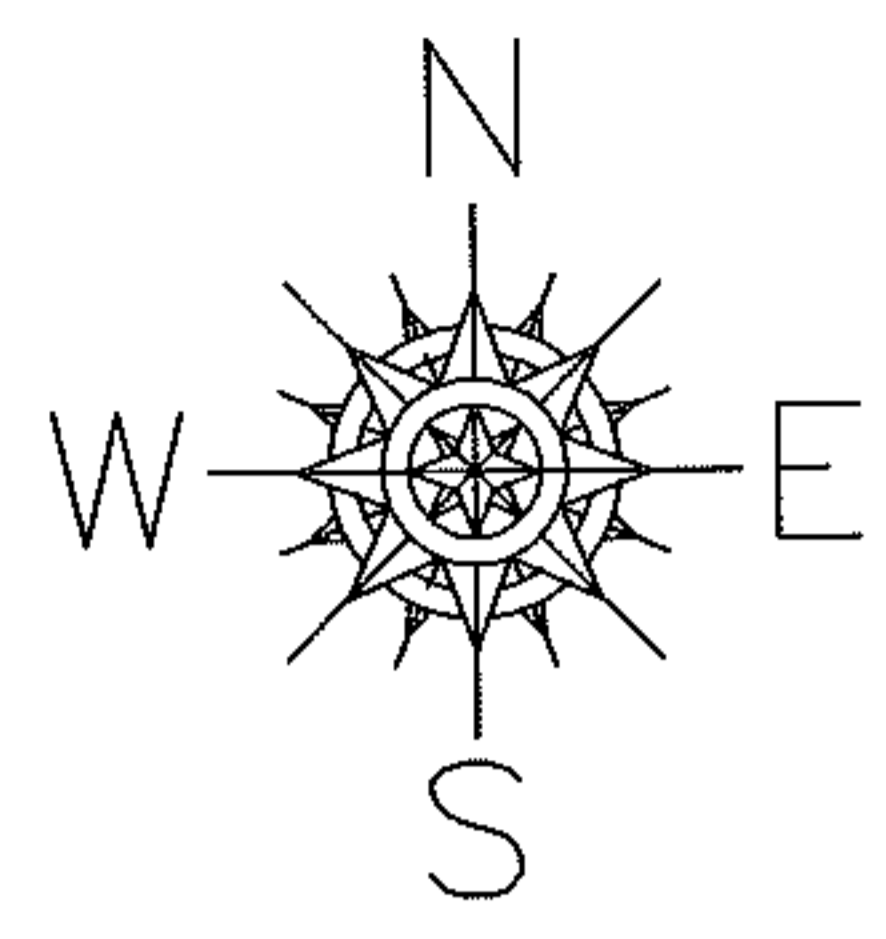

PRIOR INSTRUMENT: 20030927059
 PRIOR INSTRUMENT: 20090302710

SPLITS/DEEDS PROCESSED
 LORAIN COUNTY TAX MAP DEPARTMENT
 226 MIDDLE AVE. ELYRIA, OHIO

SURVEYED BY: KENNETH L. BOHNING
 CLOSURE: 0.01 : 10,000
 MAP PAGE(S): 07-00-004-C
 APPROVED BY: TJS DATE: 6/16/10
 SCALE: 1" = 200'