



RASTER

PARENT PARCEL: 13-09-025-000-015, 13-09-026-000-015

CHILD PARCEL: 13-09-025-000-016, -017

STARTING POINT: CENTERLINE OF GIFFORD RD & O.L. 25

10-02839

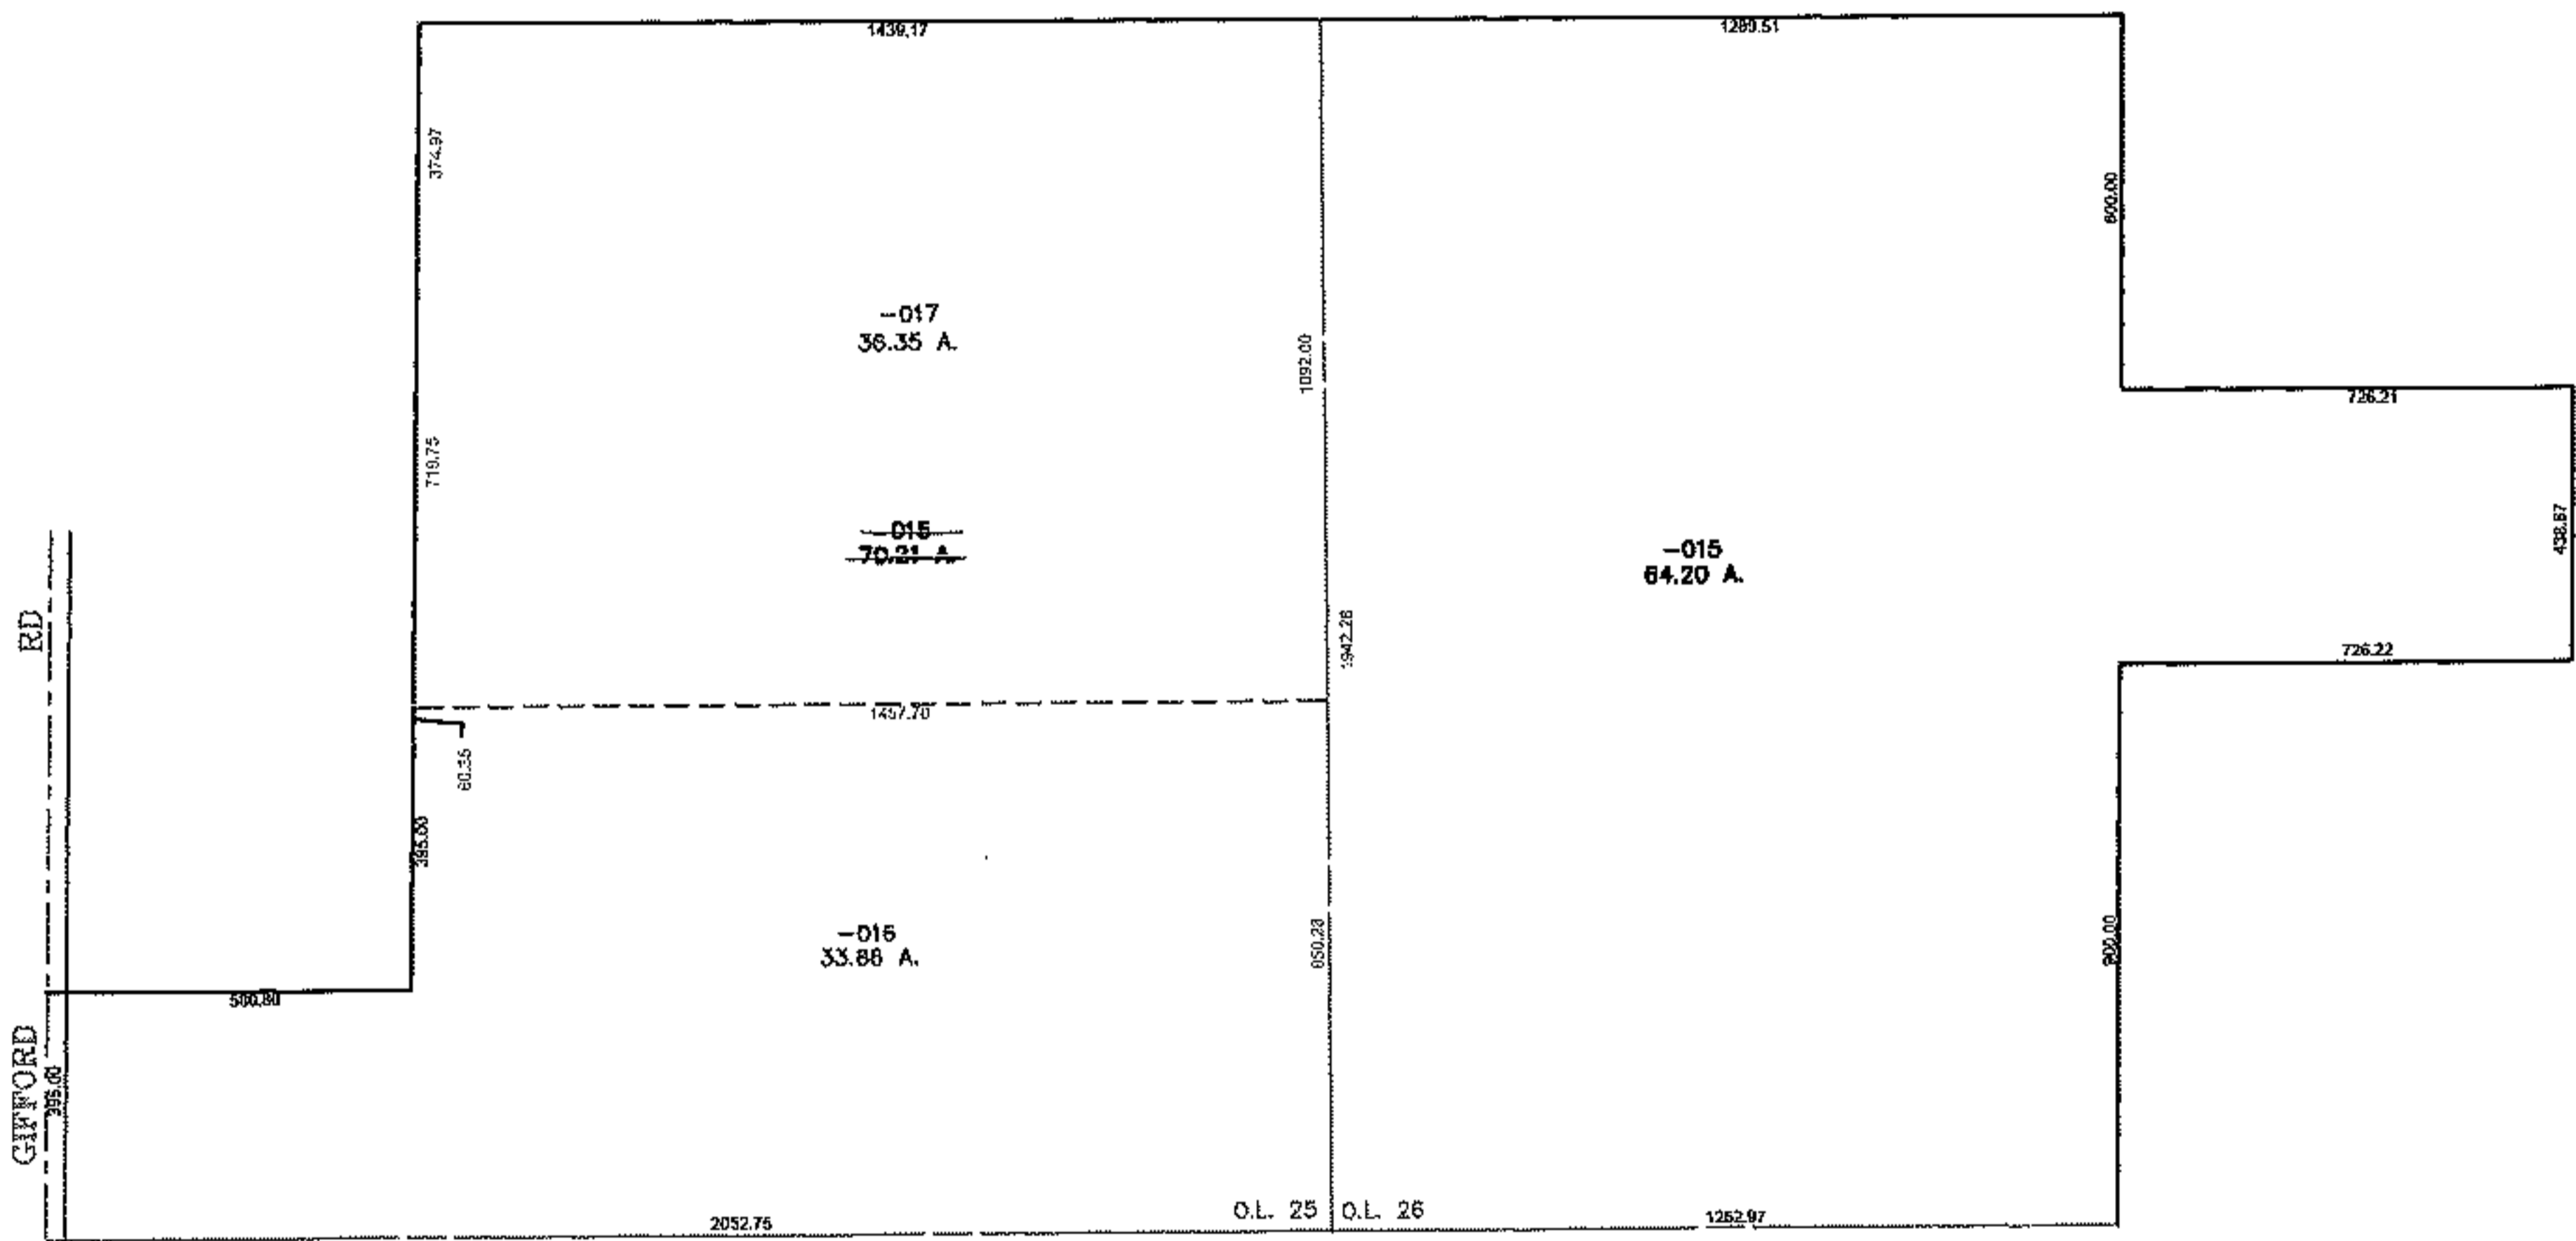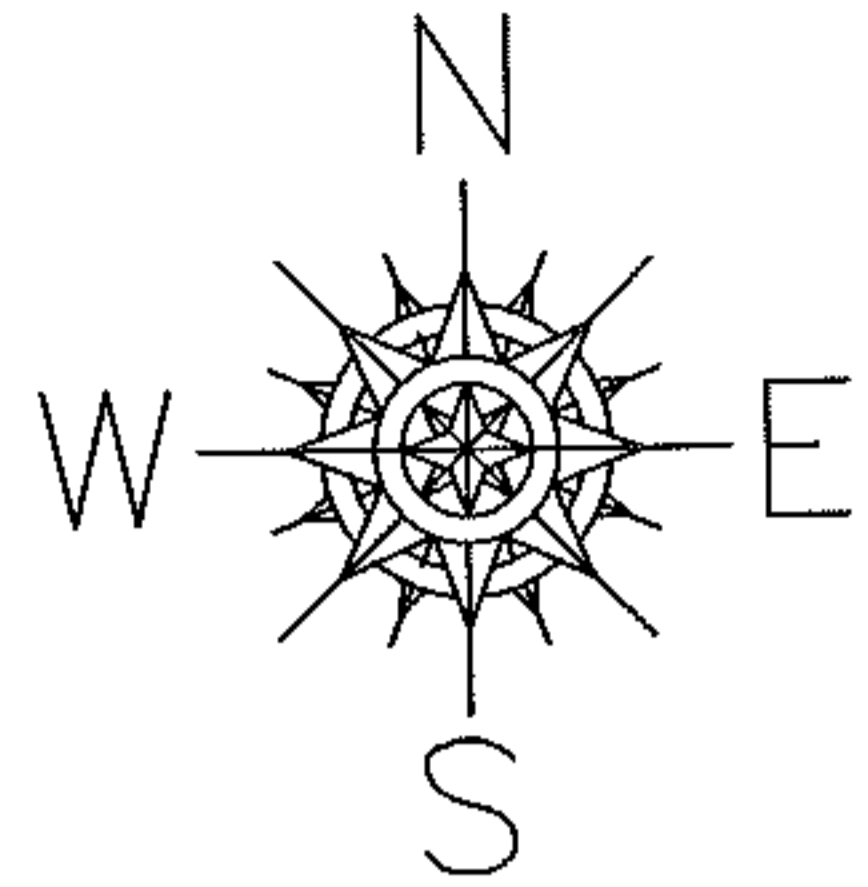

SPLITS/DEEDS PROCESSED

LORAIN COUNTY TAX MAP DEPARTMENT
226 MIDDLE AVE. ELYRIA, OHIO

SURVEYED BY: MICHAEL BRAMHALL

CLOSURE: 0.00 : 10,000

MAP PAGE(S): 13-H

APPROVED BY: JAH DATE: 7-7-2010

SCALE: 1" = 600 PRIOR INSTRUMENT: 20060123041