



RASTER

PARENT PARCEL: 09-00-091-000-030

CHILD PARCEL: 09-00-091-000-035, -036

STARTING POINT: CENTERLINE OF HAMILTON ST & QUARRY RD

10-02840

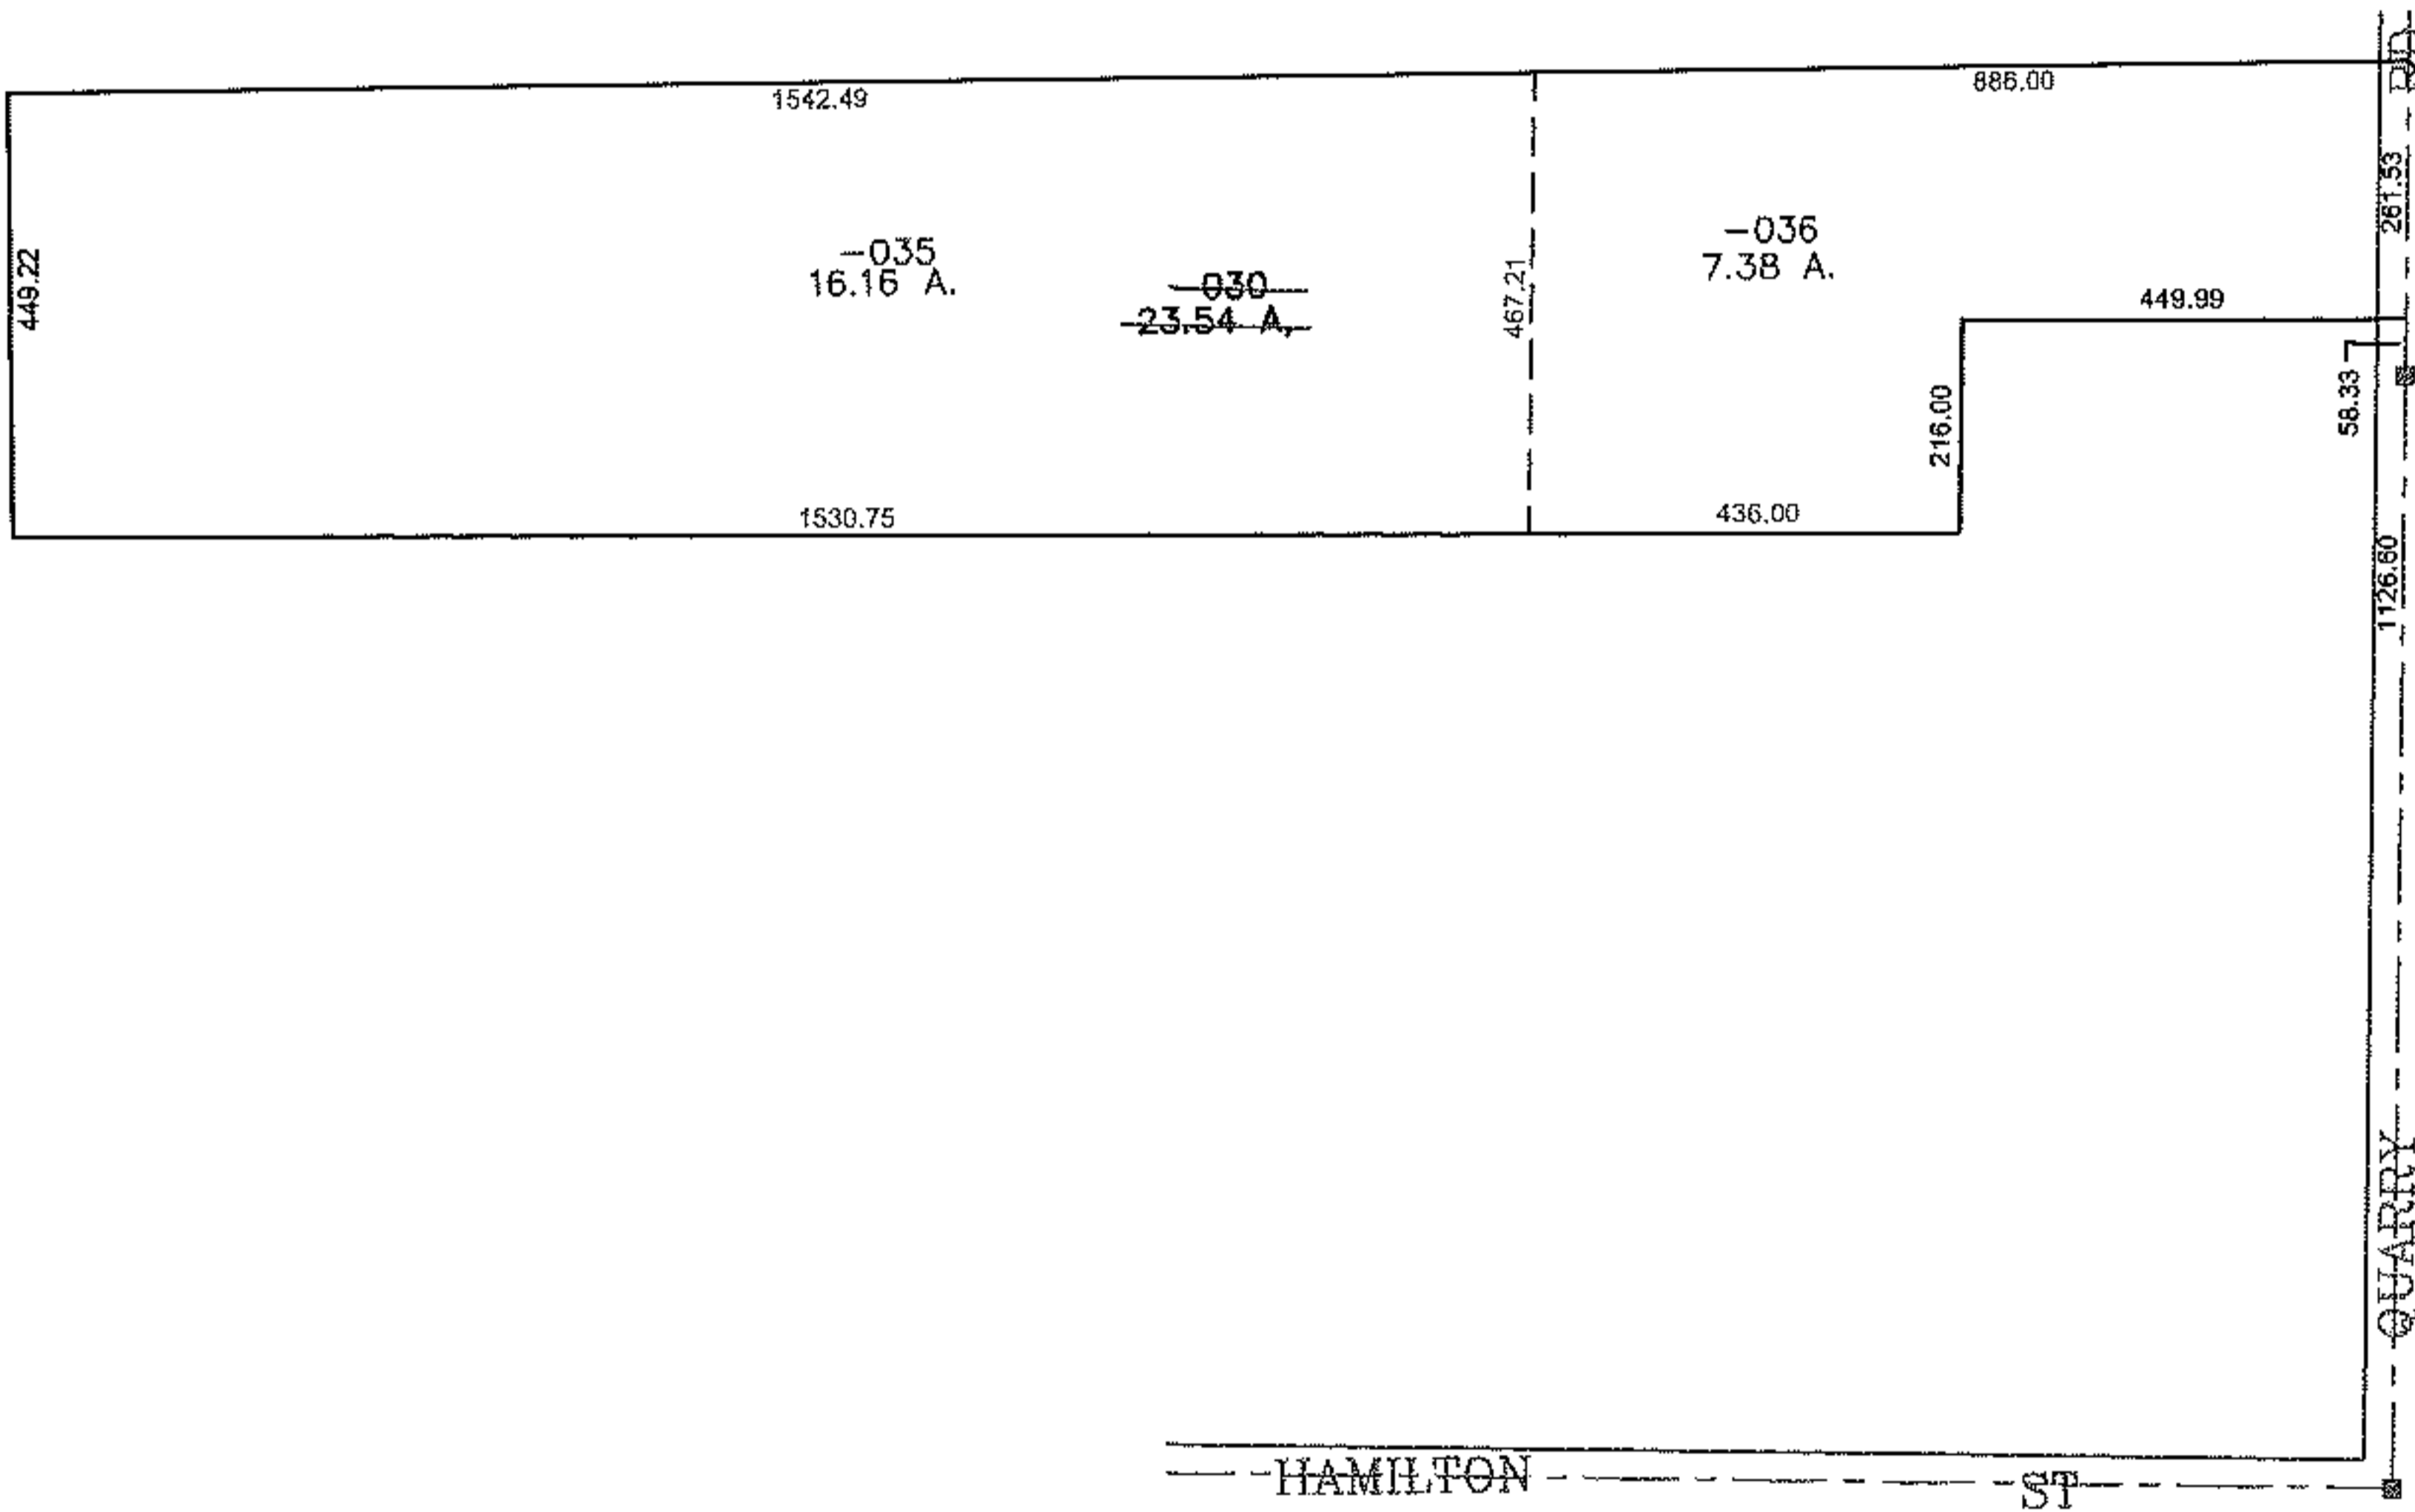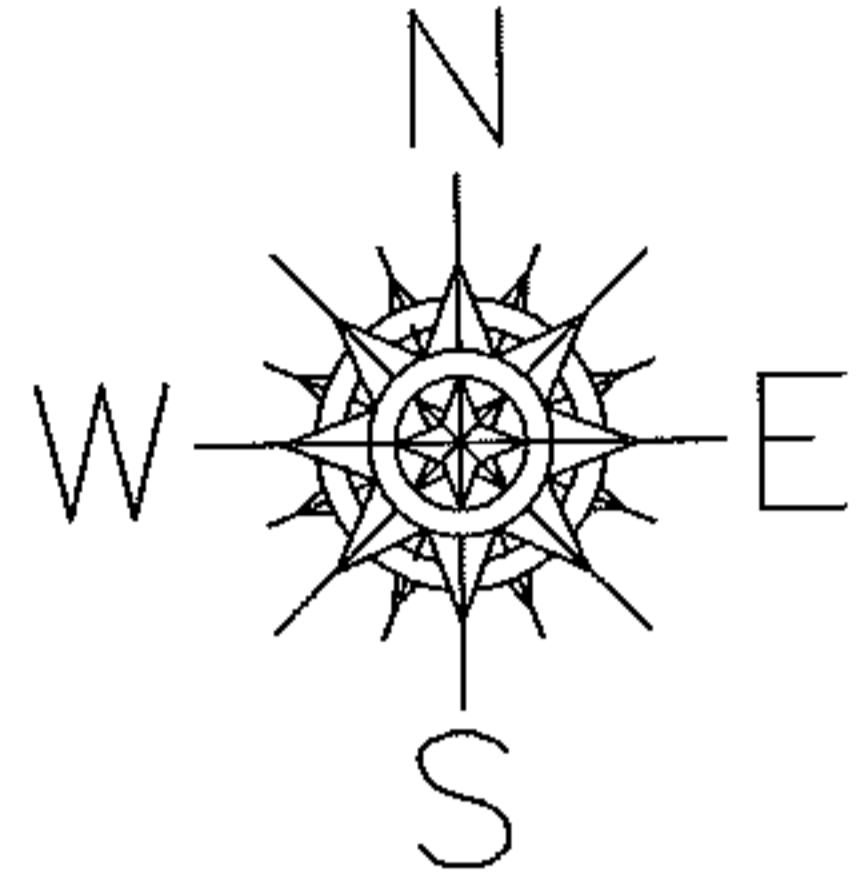

SPLITS/DEEDS PROCESSED

LORAIN COUNTY TAX MAP DEPARTMENT
226 MIDDLE AVE. ELYRIA, OHIO

SURVEYED BY: ADAM TREAT

CLOSURE: 0.00 : 10.000

MAP PAGE(S): 9-E

APPROVED BY: JAH DATE: 7-8-2010

SCALE: 1" = 400 PRIOR INSTRUMENT: OR 764/135