
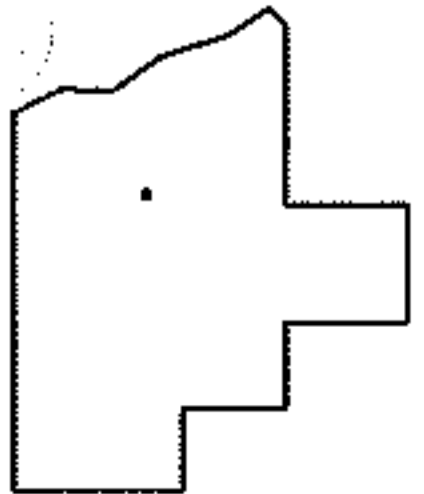
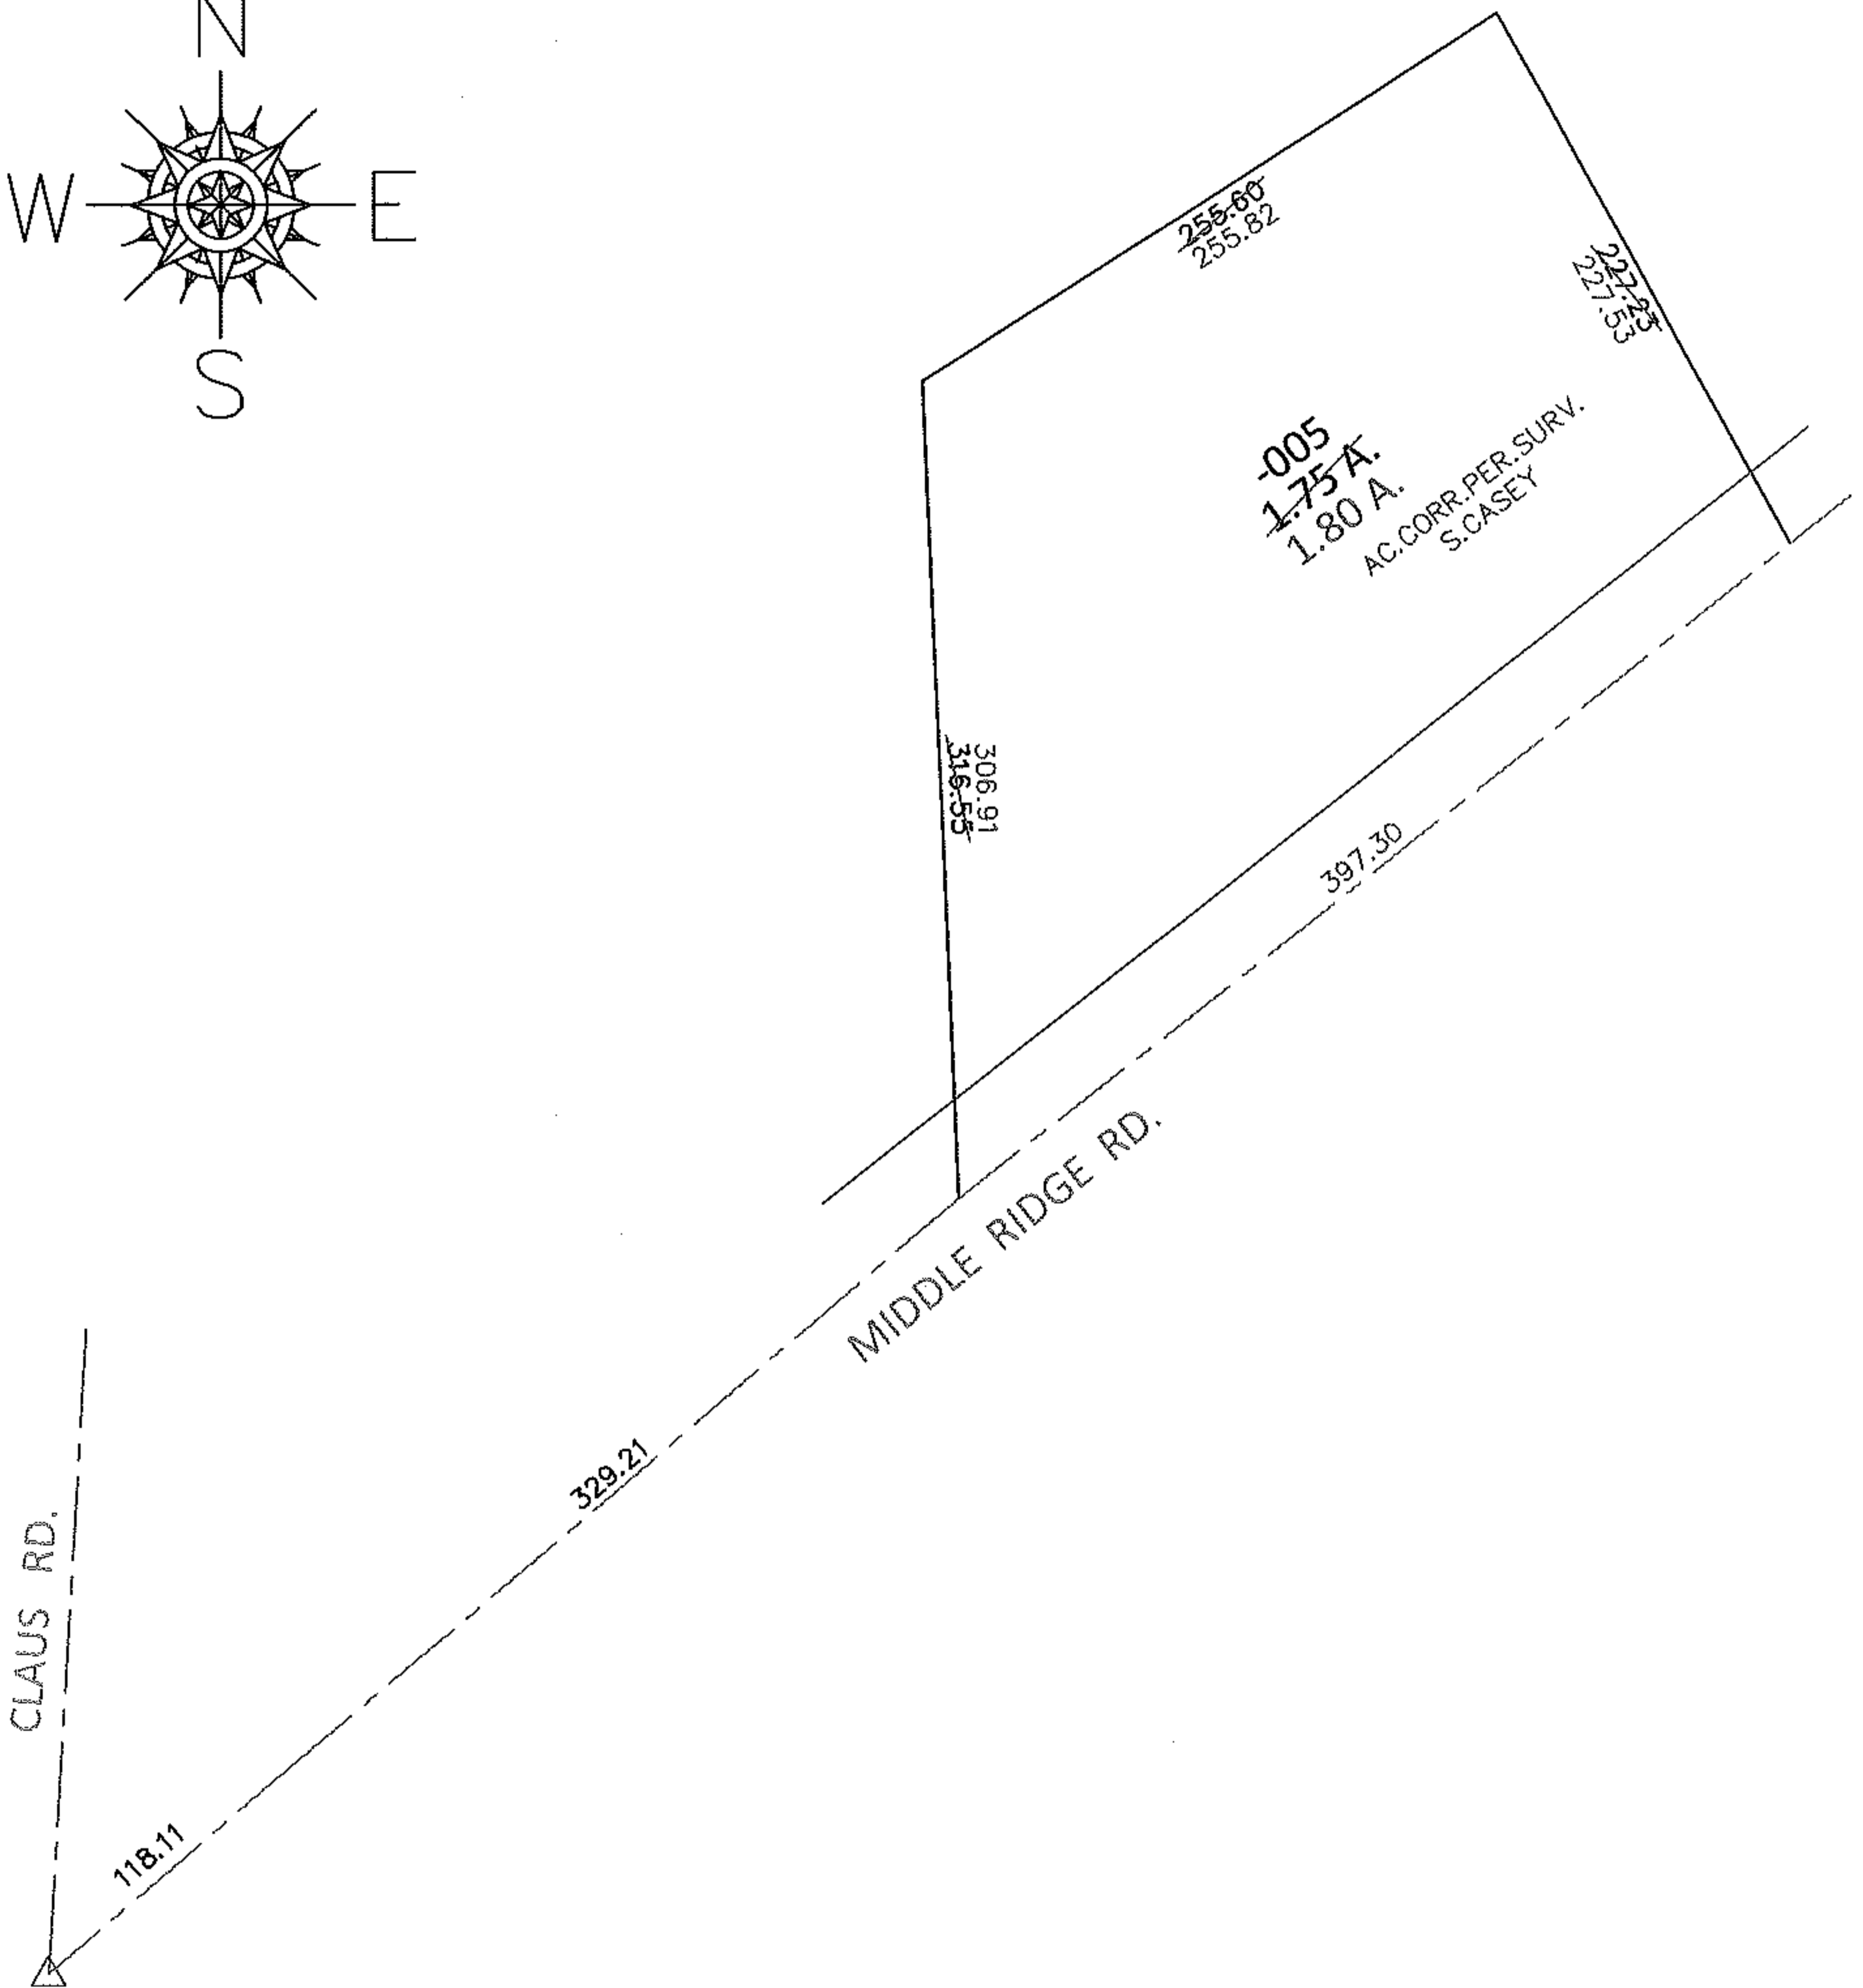


PARENT PARCEL: 01-00-060-000-007

CHILD PARCEL: \_\_\_\_\_

13-02841-A

STARTING POINT: AT A R.R.S. FOUND AT THE INTERSECTION OF C/L OF CLAUS RD. AND C/L OF MIDDLE RIDGE RD.

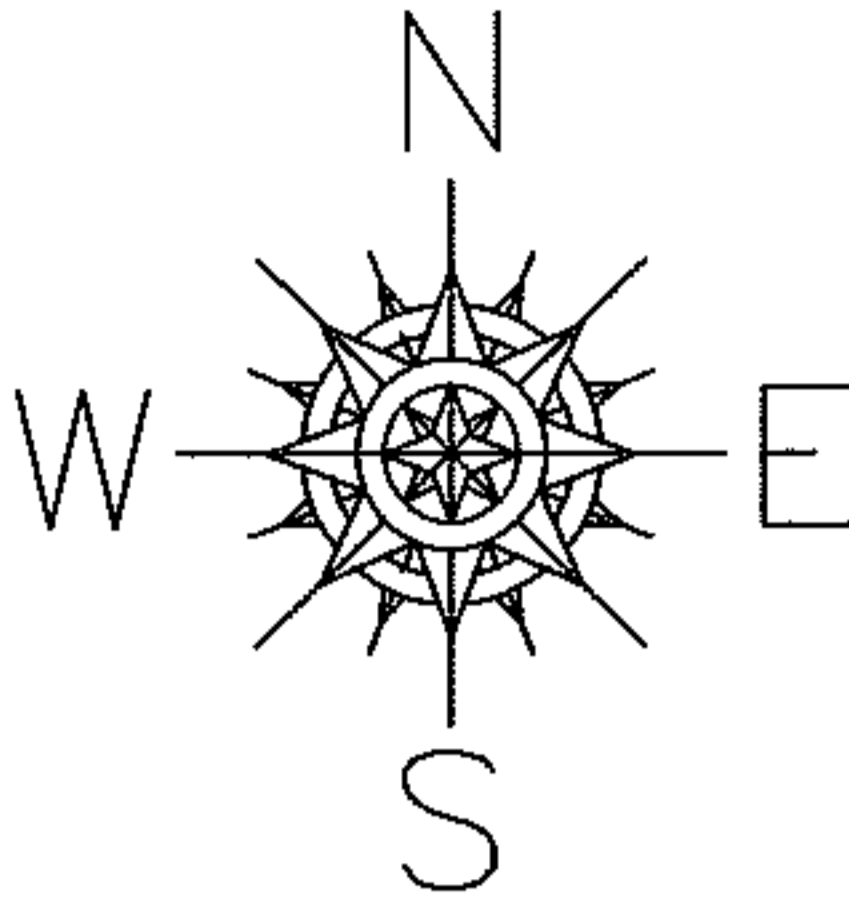

**SPLITS/DEEDS PROCESSED**

LORAIN COUNTY TAX MAP DEPARTMENT  
226 MIDDLE AVE. ELYRIA, OHIO

SURVEYED BY: SCOTT J. CASEY

CLOSURE: .01:10,000

MAP PAGE(S): 1-K

APPROVED BY: RRM DATE: 11-13-13

SCALE: 1"= 100 PRIOR INST.: 20120401484