
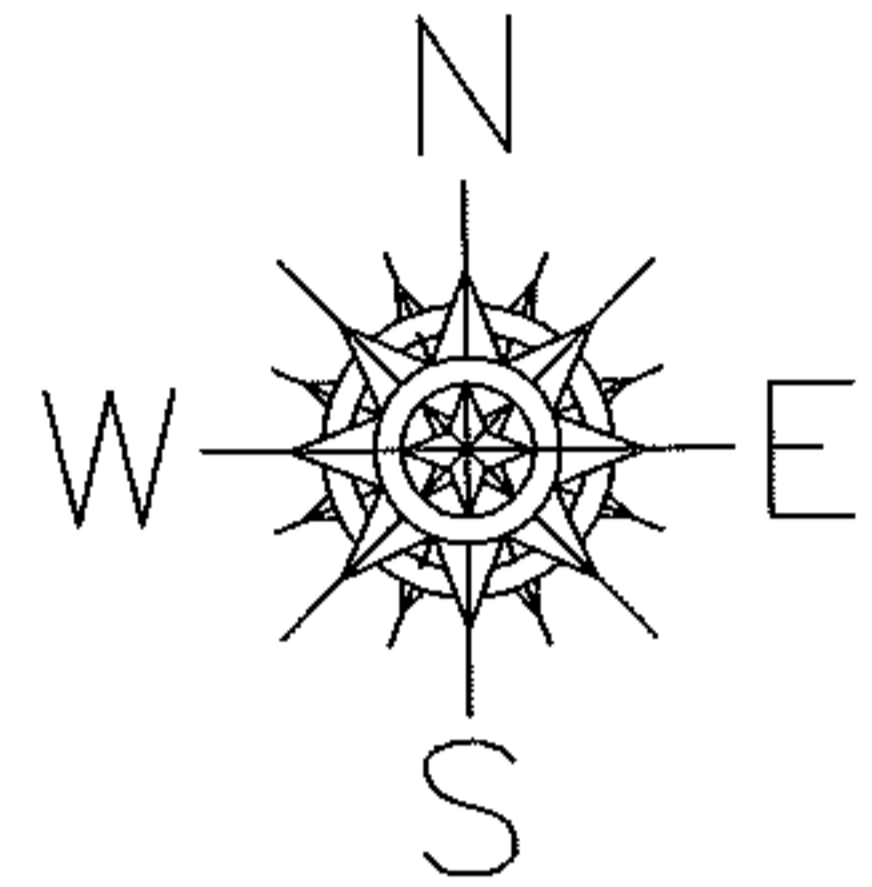


PARENT PARCEL: 04-00-008-104-119

CHILD PARCEL: 04-00-008-104-128, -129

STARTING POINT: CENTERLINE OF WEBBER & MOORE RD


10-02841

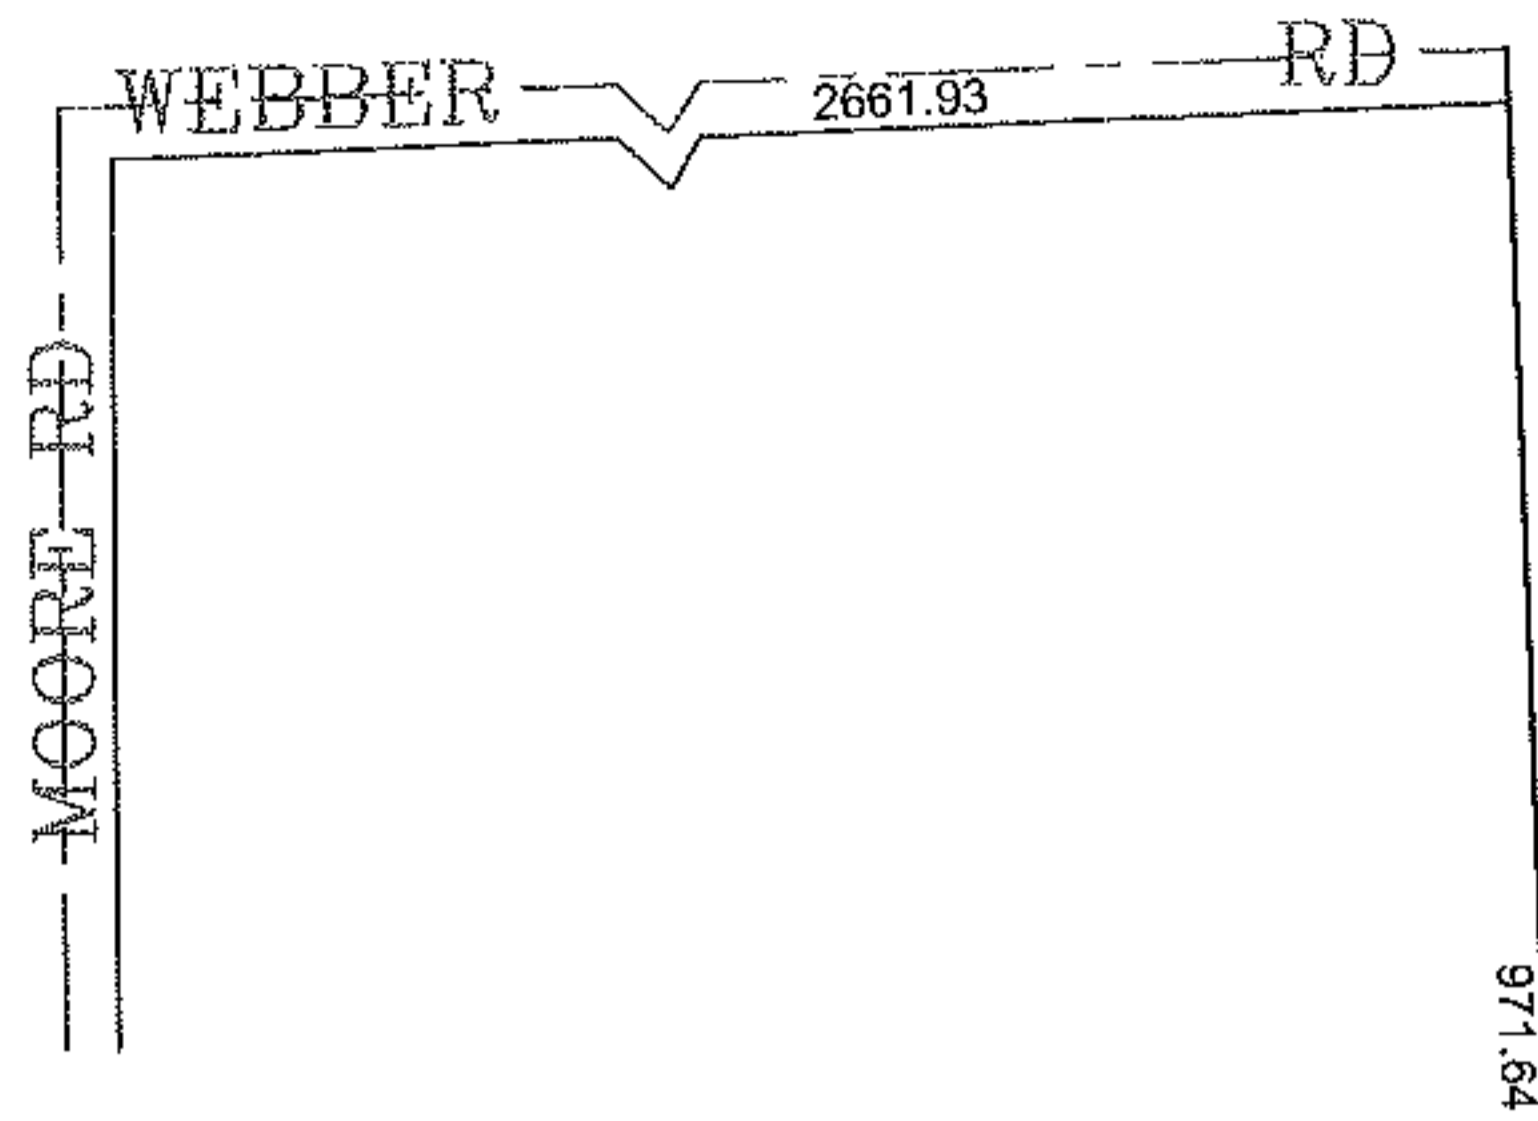

971.84

656.36

434.93

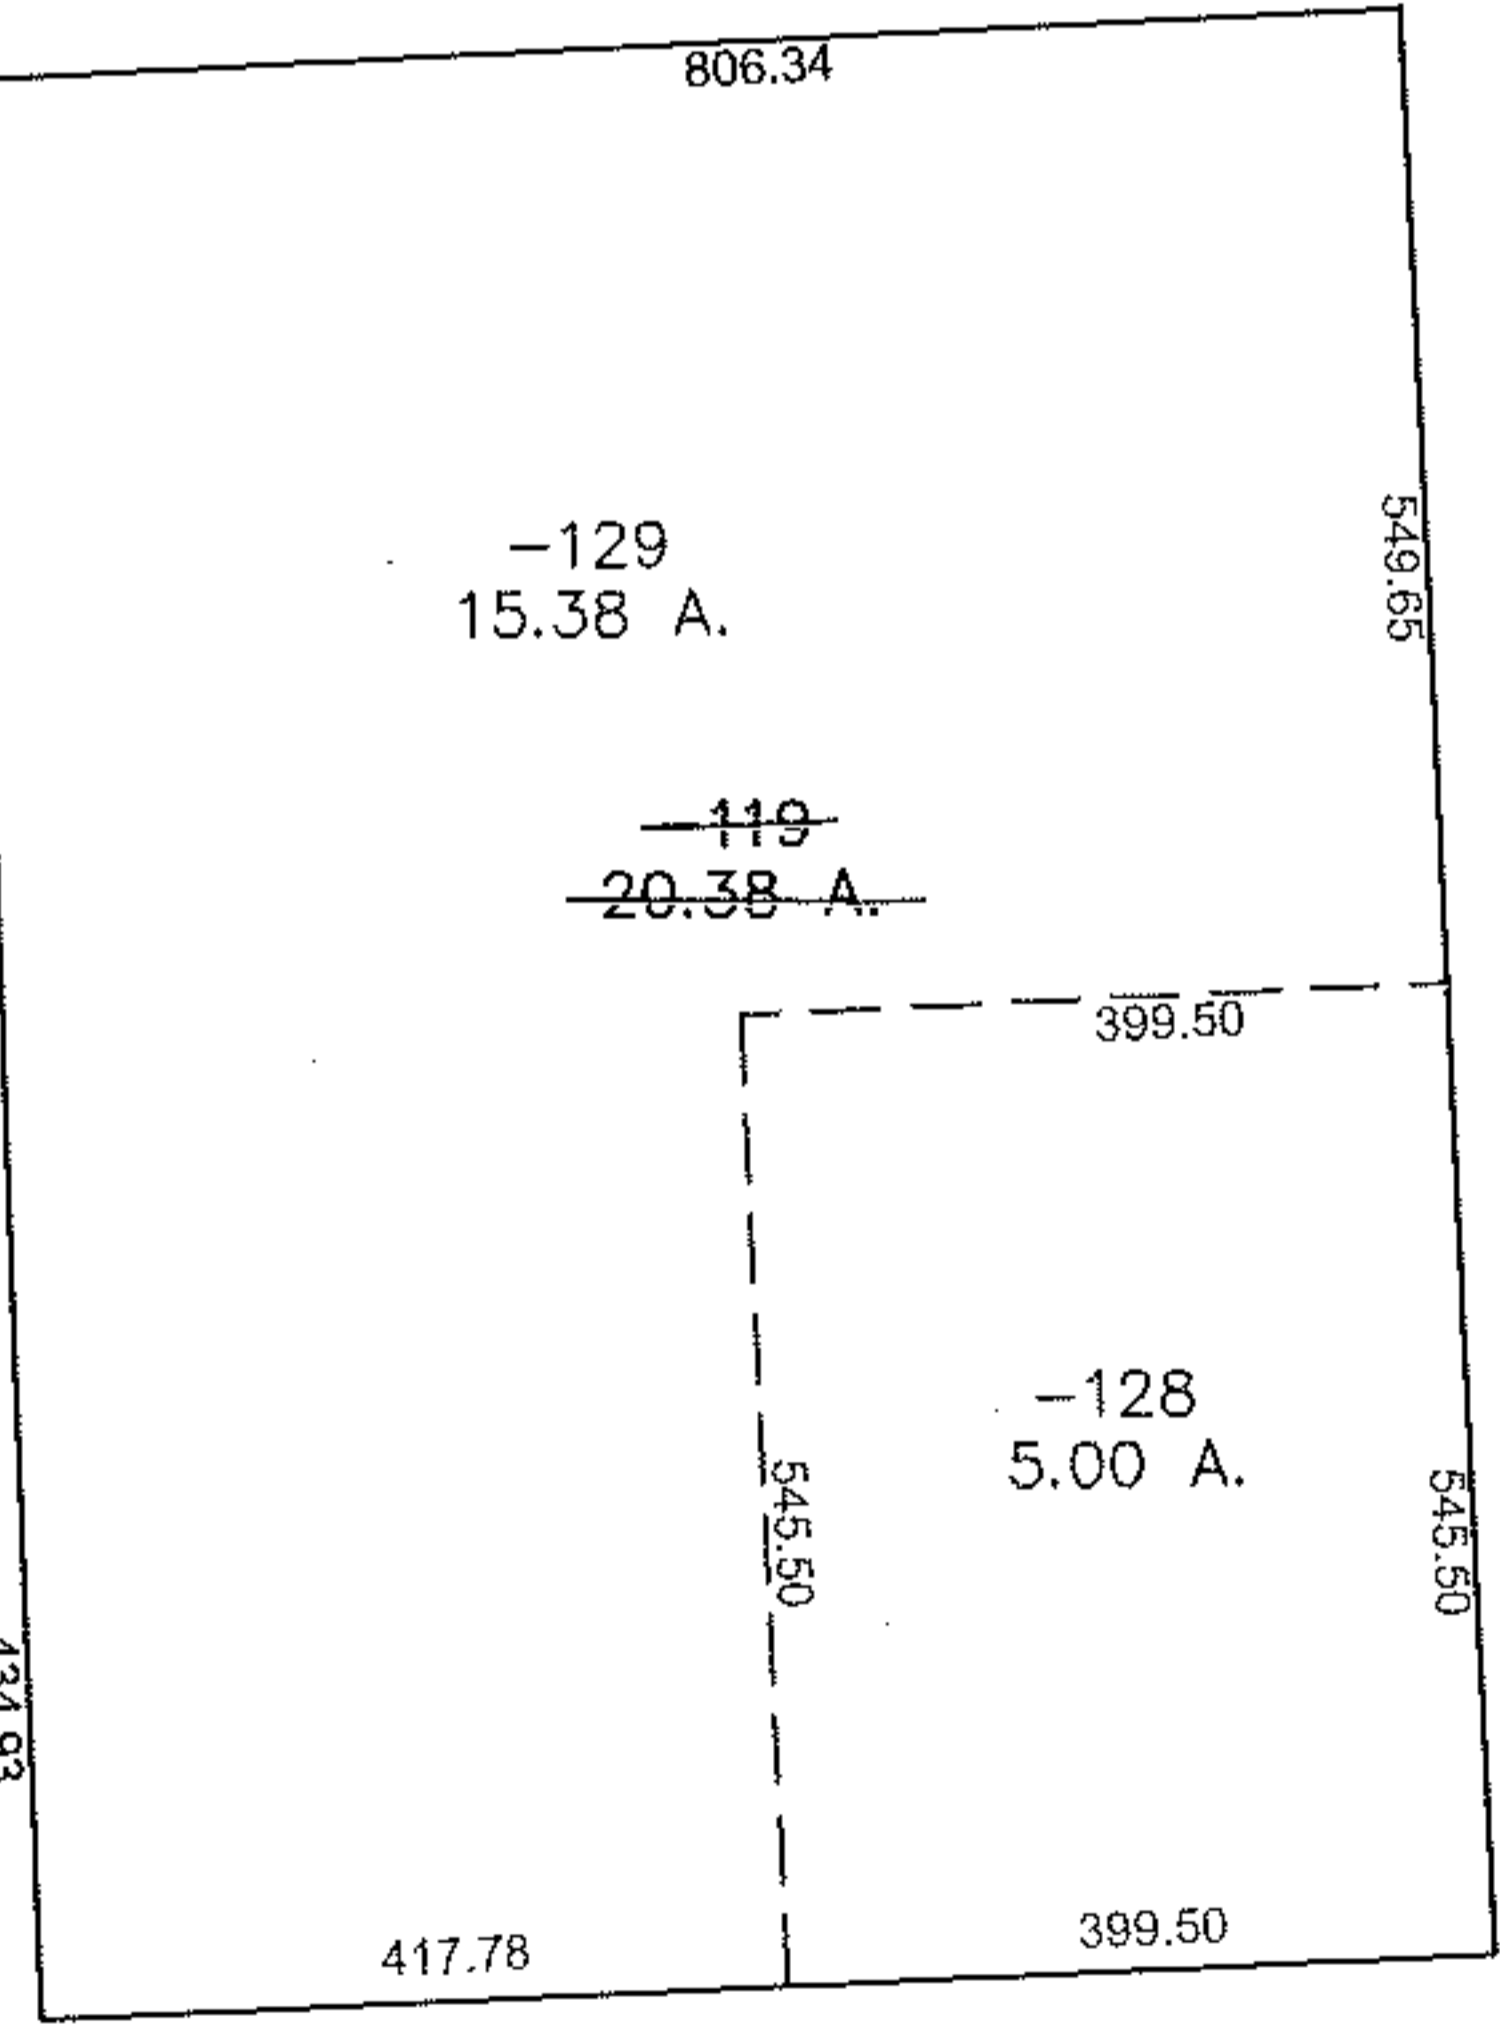

-129
15.38 A.

~~-119~~
~~20.38 A.~~

-128
5.00 A.

806.34

549.65


399.50

545.50

545.50

417.78

399.50

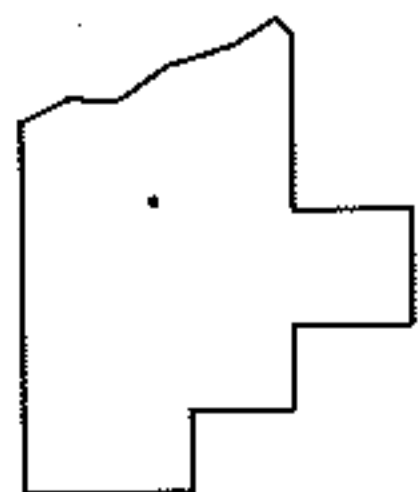

SPLITS/DEEDS PROCESSED

LORAIN COUNTY TAX MAP DEPARTMENT
226 MIDDLE AVE. ELYRIA, OHIO

SURVEYED BY: DAVE ELWELL

CLOSURE: 0.00 : 10.000

MAP PAGE(S): 04-00-008-G

APPROVED BY: JAH DATE: 7-8-2010

SCALE: 1" = 300 PRIOR INSTRUMENT: 20070207726