


PARENT PARCEL: 10-00-008-112-010, -011

CHILD PARCEL: _____

13-02843-D



STARTING POINT: INTERSECTION OF C/L OF CARLISLE RD. AND C/L OF LAGRANGE RD.

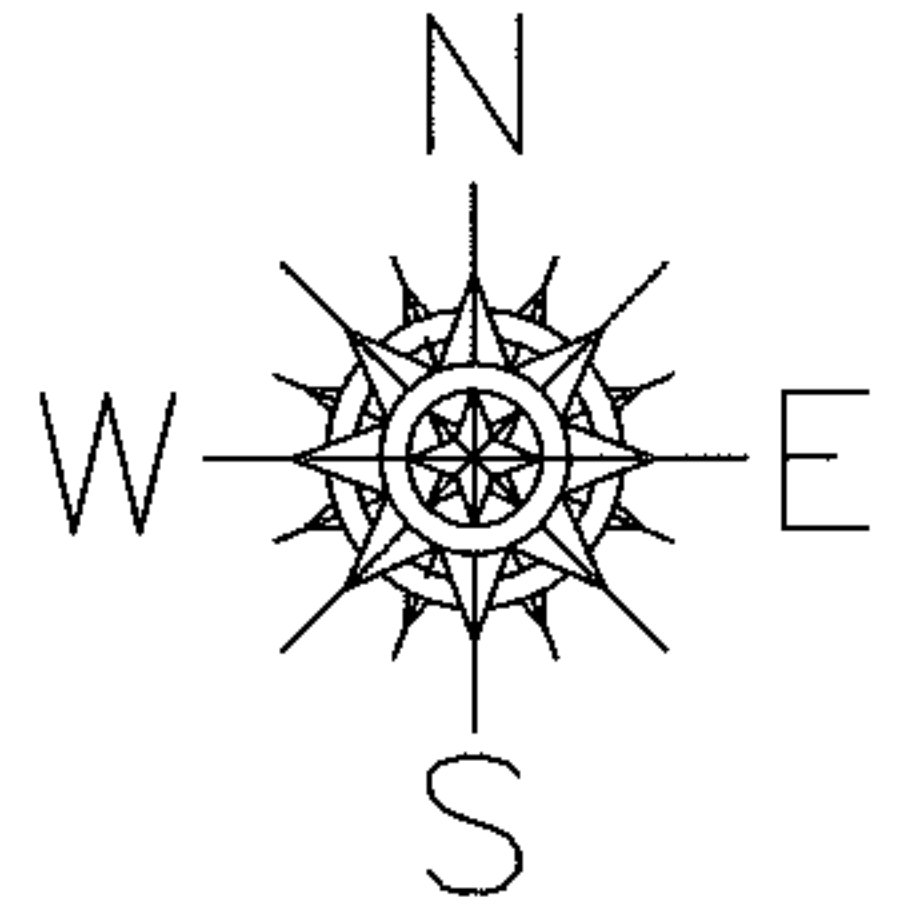

CARLISLE RD.

1562.66
LAGRANGE RD.

MAP CORRECTION ONLY

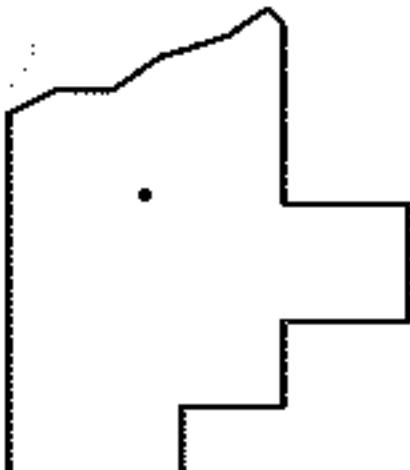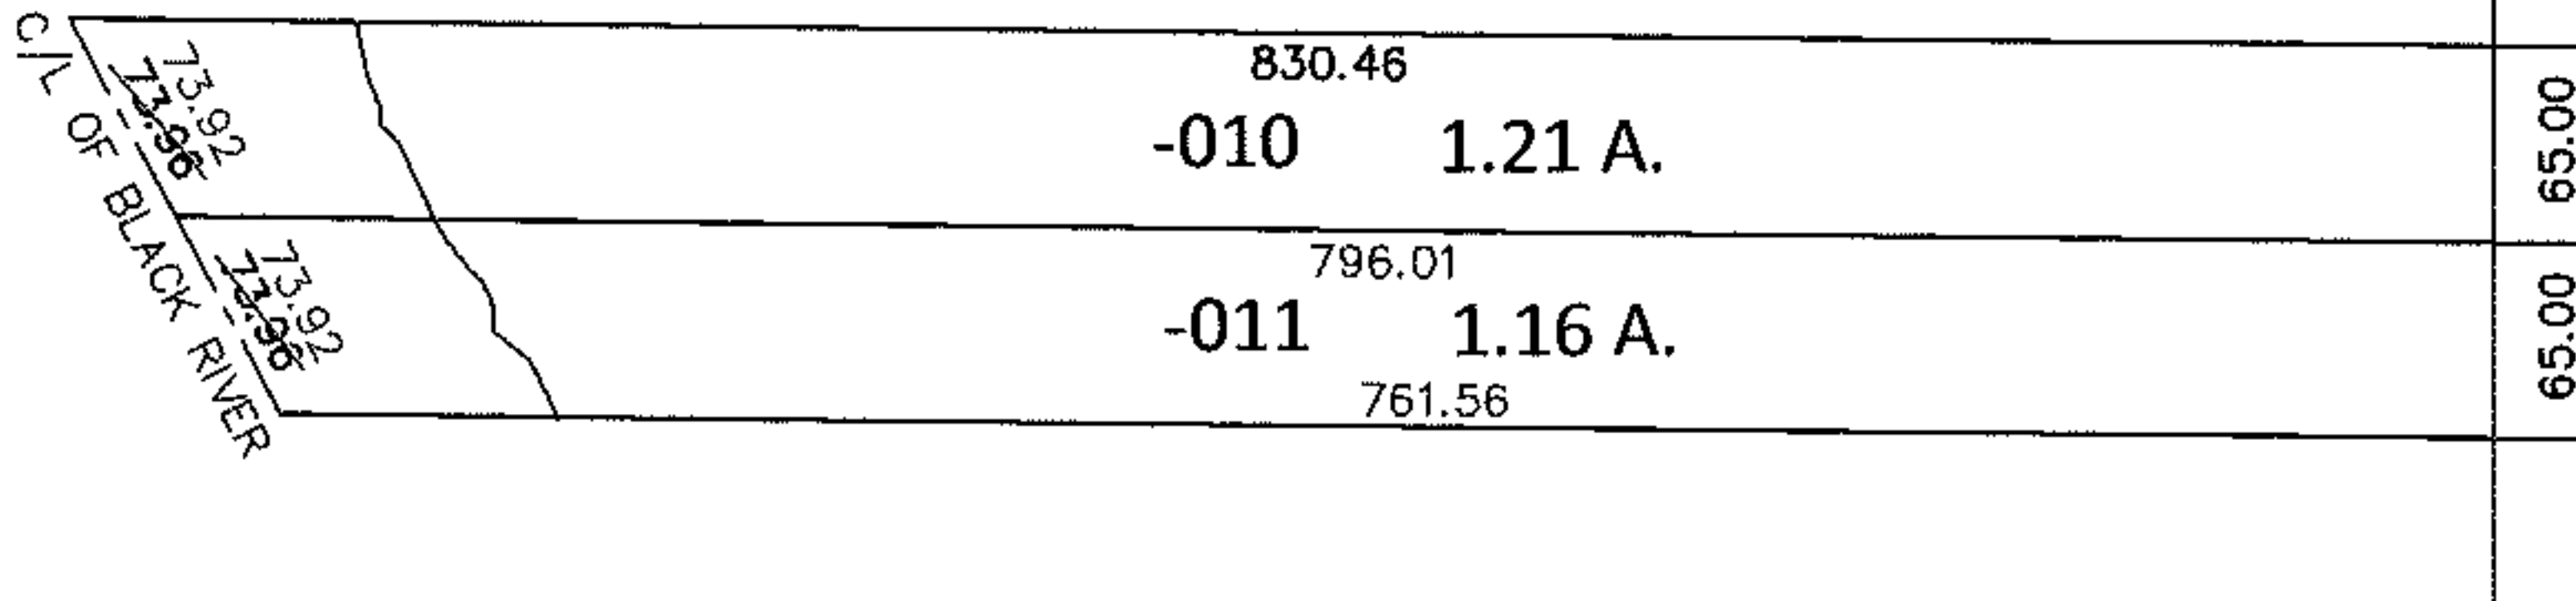

SPLITS/DEEDS PROCESSED

LORAIN COUNTY TAX MAP DEPARTMENT
226 MIDDLE AVE. ELYRIA, OHIO

SURVEYED BY: EDWARD B. DUDLEY III

CLOSURE: .01:10,000

MAP PAGE(S): 10-00-008-F

APPROVED BY: RRM DATE: 11-13-13

SCALE: 1"= 150' PRIOR INST.: 20130454205