



RASPER

PARENT PARCEL: 09-00-096-111-041

CHILD PARCEL: 09-00-096-111-047 THRU -049

STARTING POINT: CENTERLINE OF SOUTH PLEASANT ST & SMITH ST

10-02848

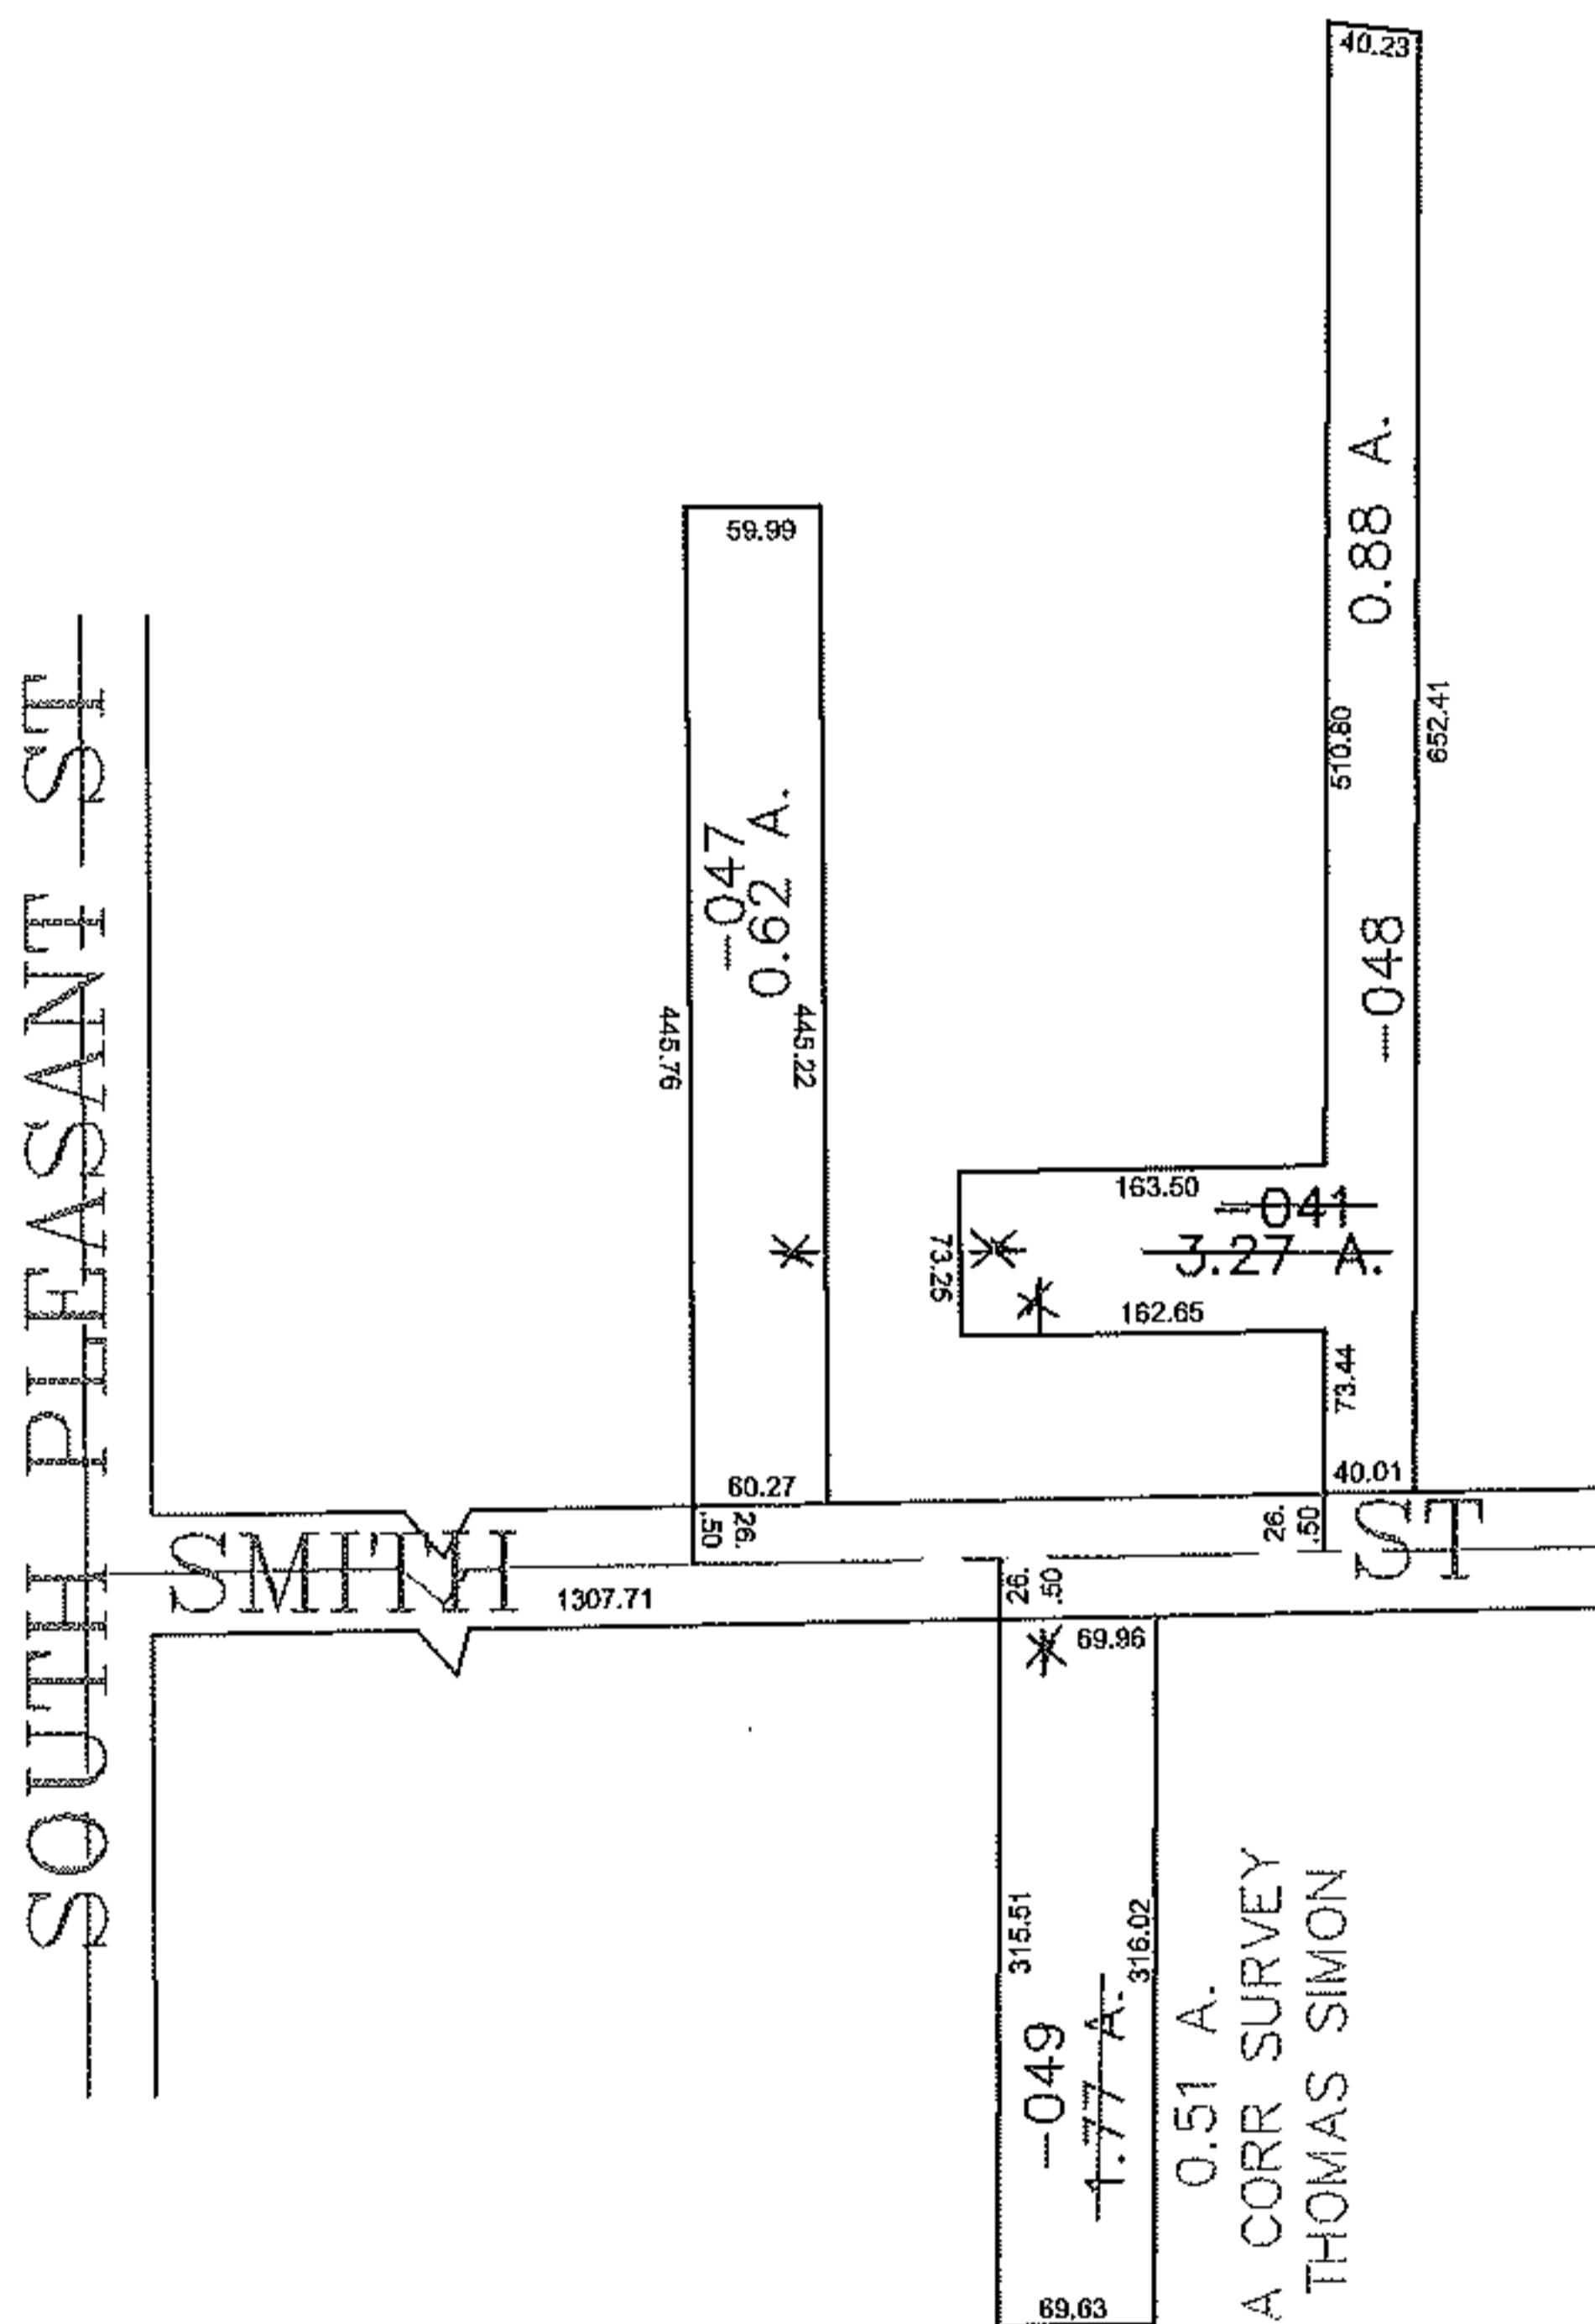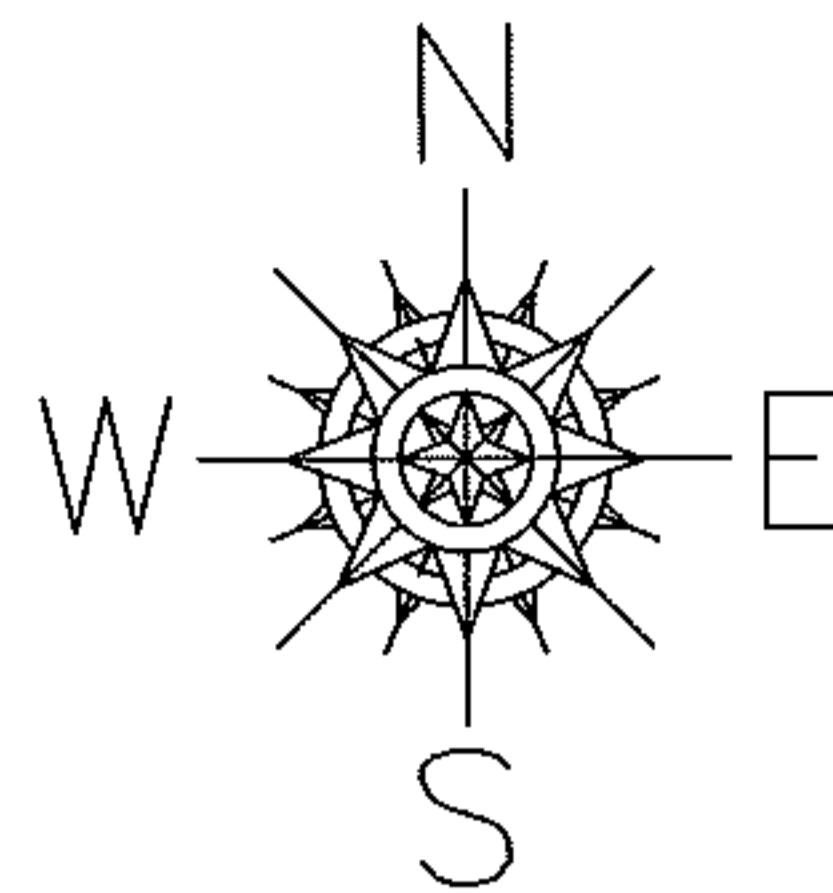

SPLITS/DEEDS PROCESSED
 LORAIN COUNTY TAX MAP DEPARTMENT
 226 MIDDLE AVE. ELYRIA, OHIO

SURVEYED BY: THOMAS SIMON
 CLOSURE: 0.00 : 10.00
 MAP PAGE(S): 09-00-096-B
 APPROVED BY: JAH DATE: 8-2-2010
 SCALE: 1" = 200 PRIOR INSTRUMENT: 20080279448