
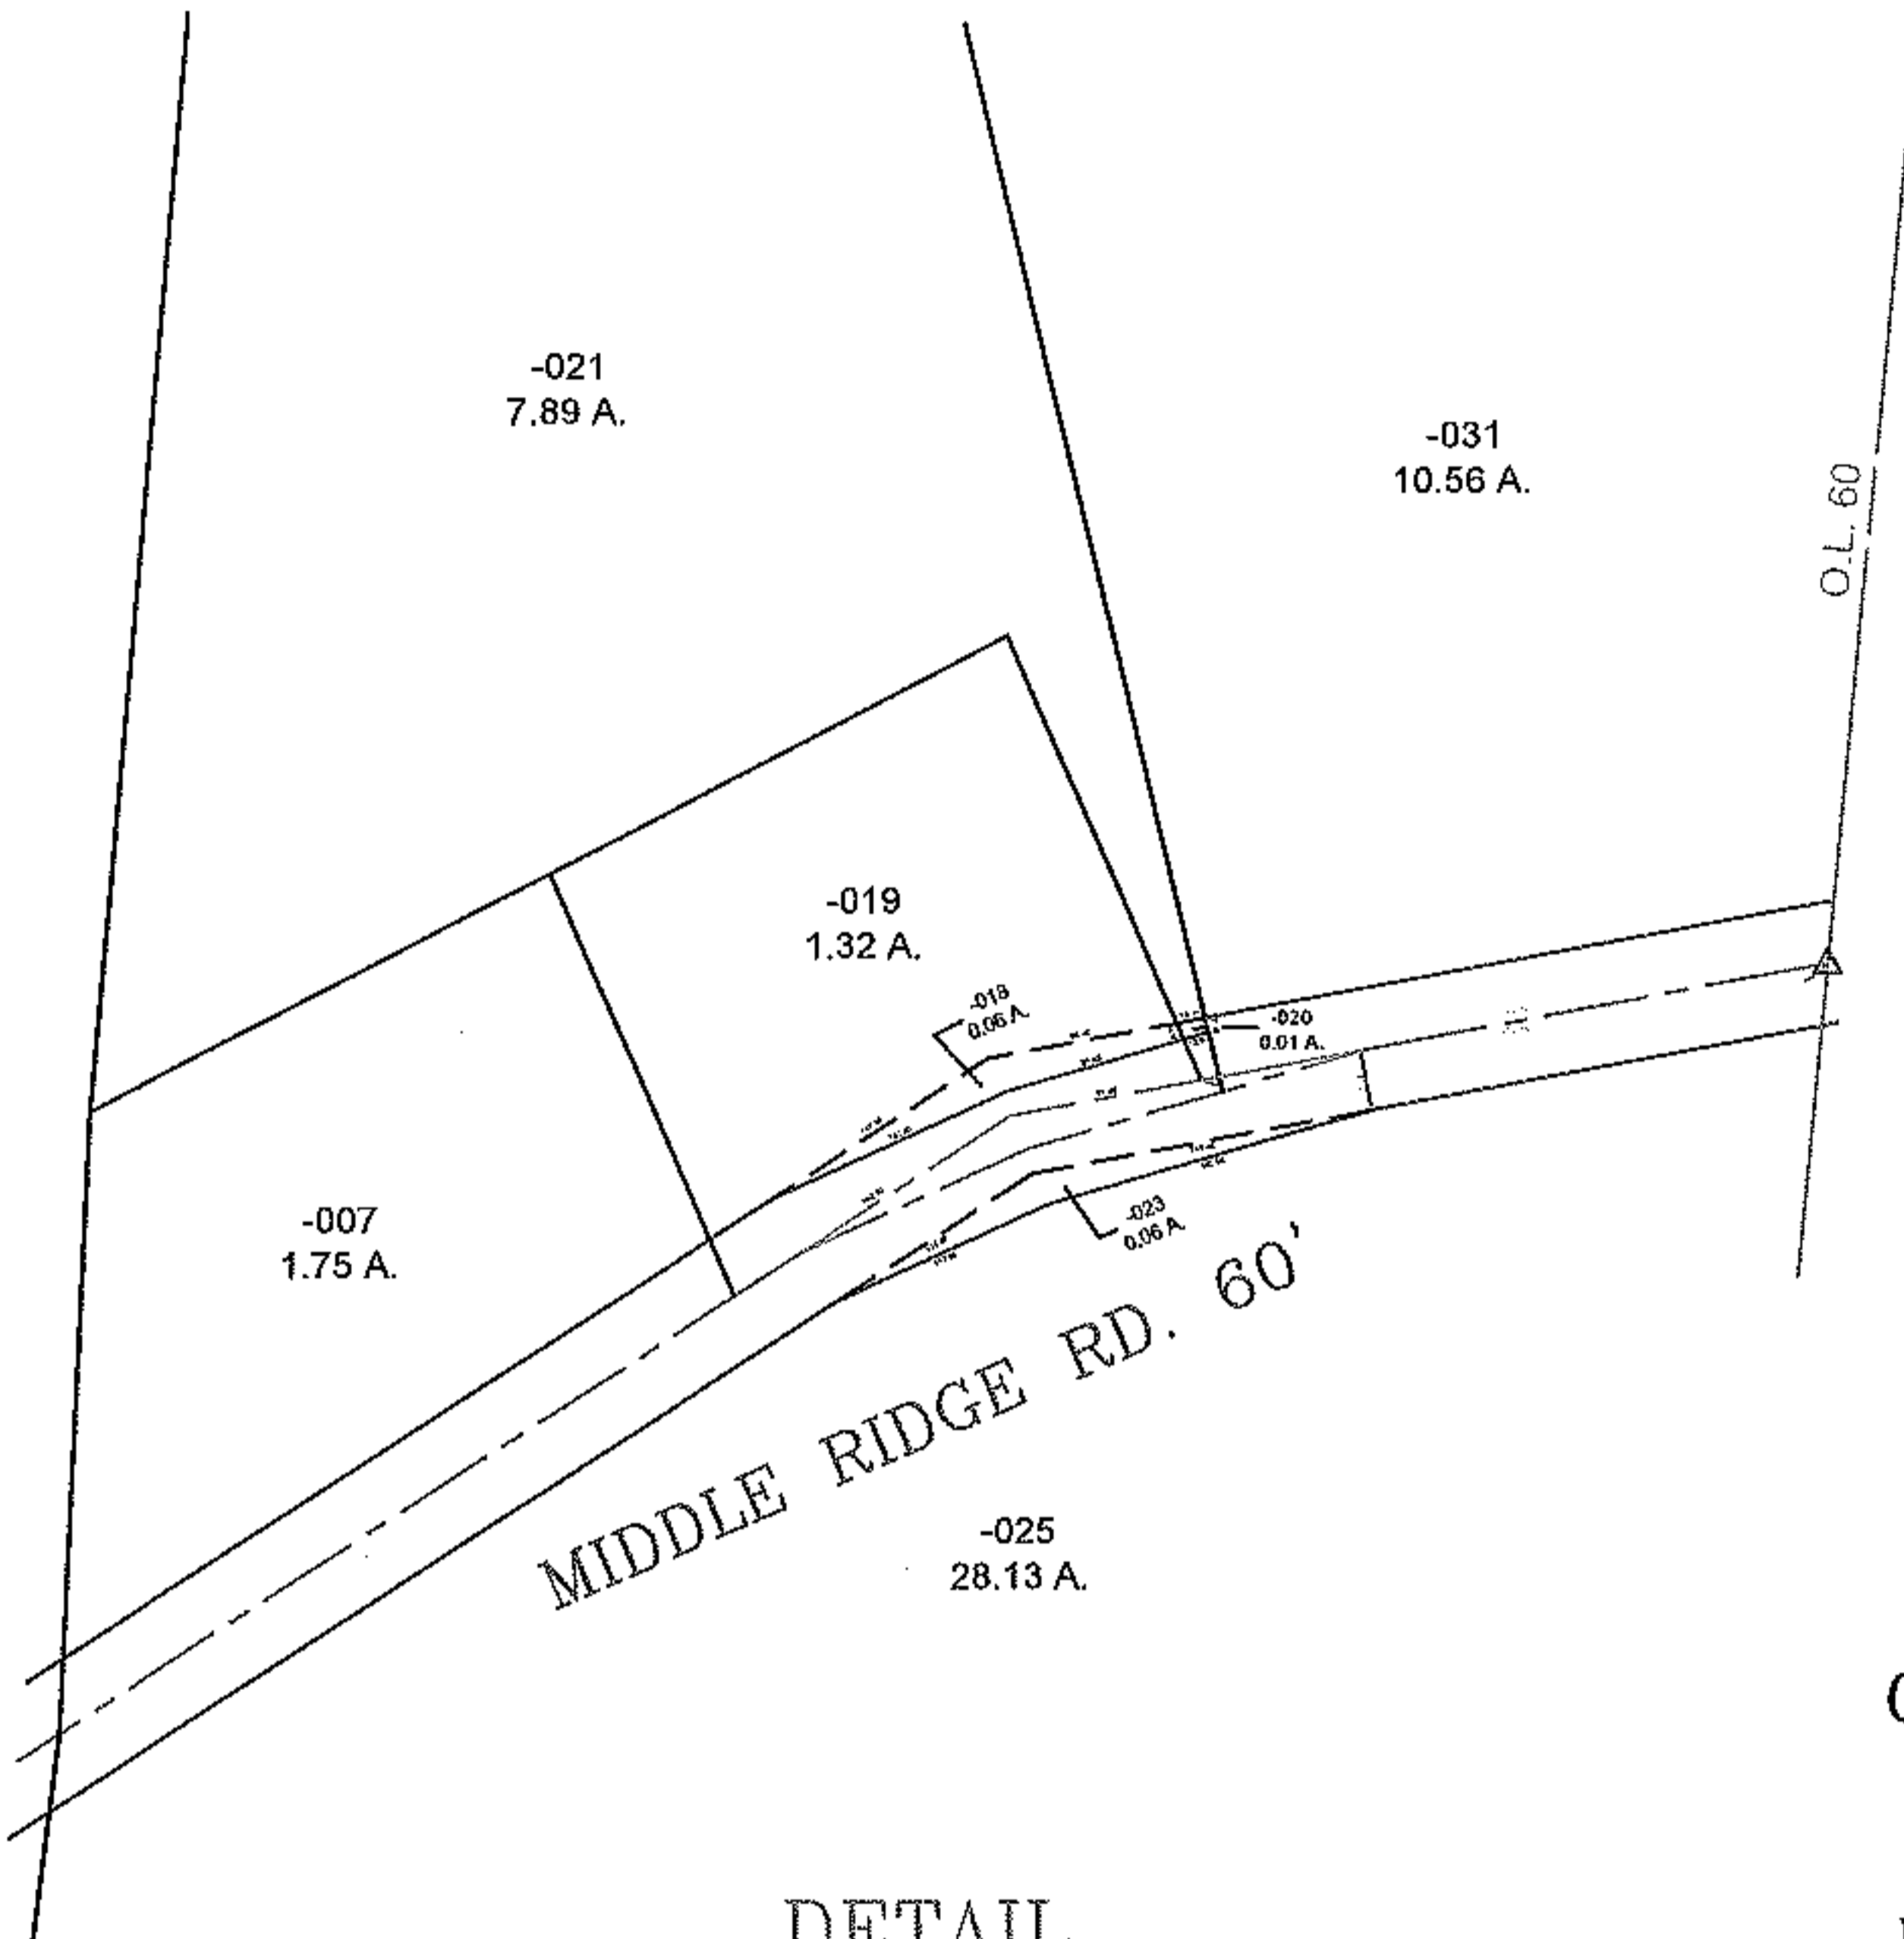


PARENT PARCEL: 01-00-060-000-018 & -020

CHILD PARCEL: XX-XX-XXX-XXX-XXX


STARTING POINT: CL OF MIDDLE RIDGE RD. & EAST LINE OF O.L. 60

13-02849-C

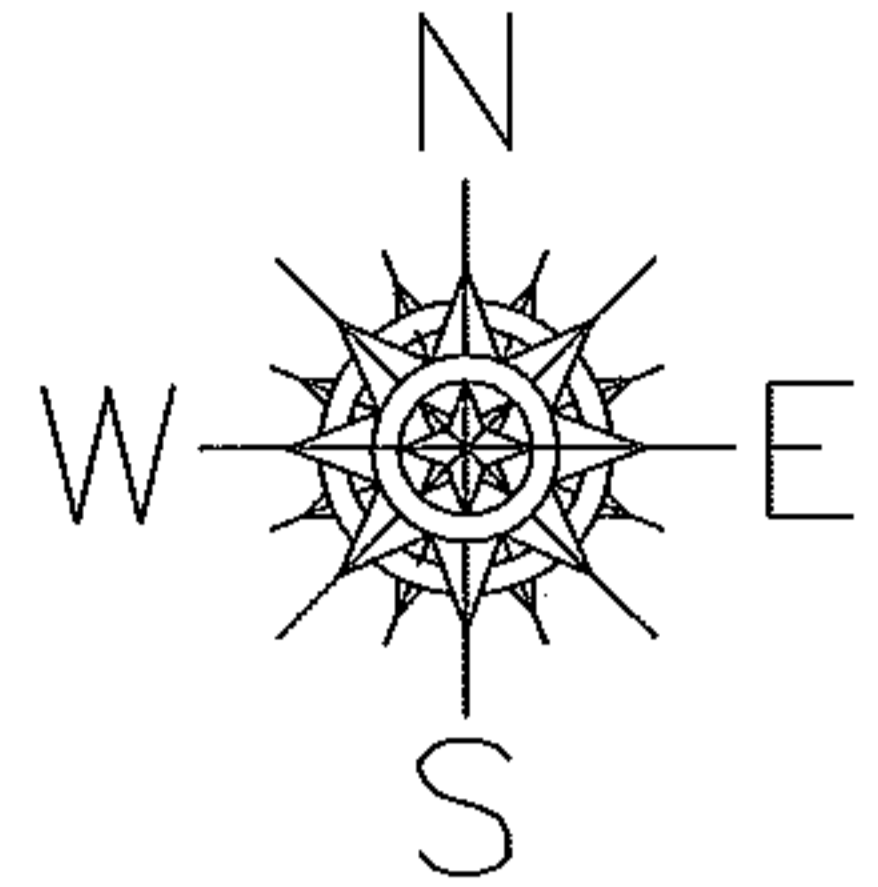

DETAIL

1" = 100'

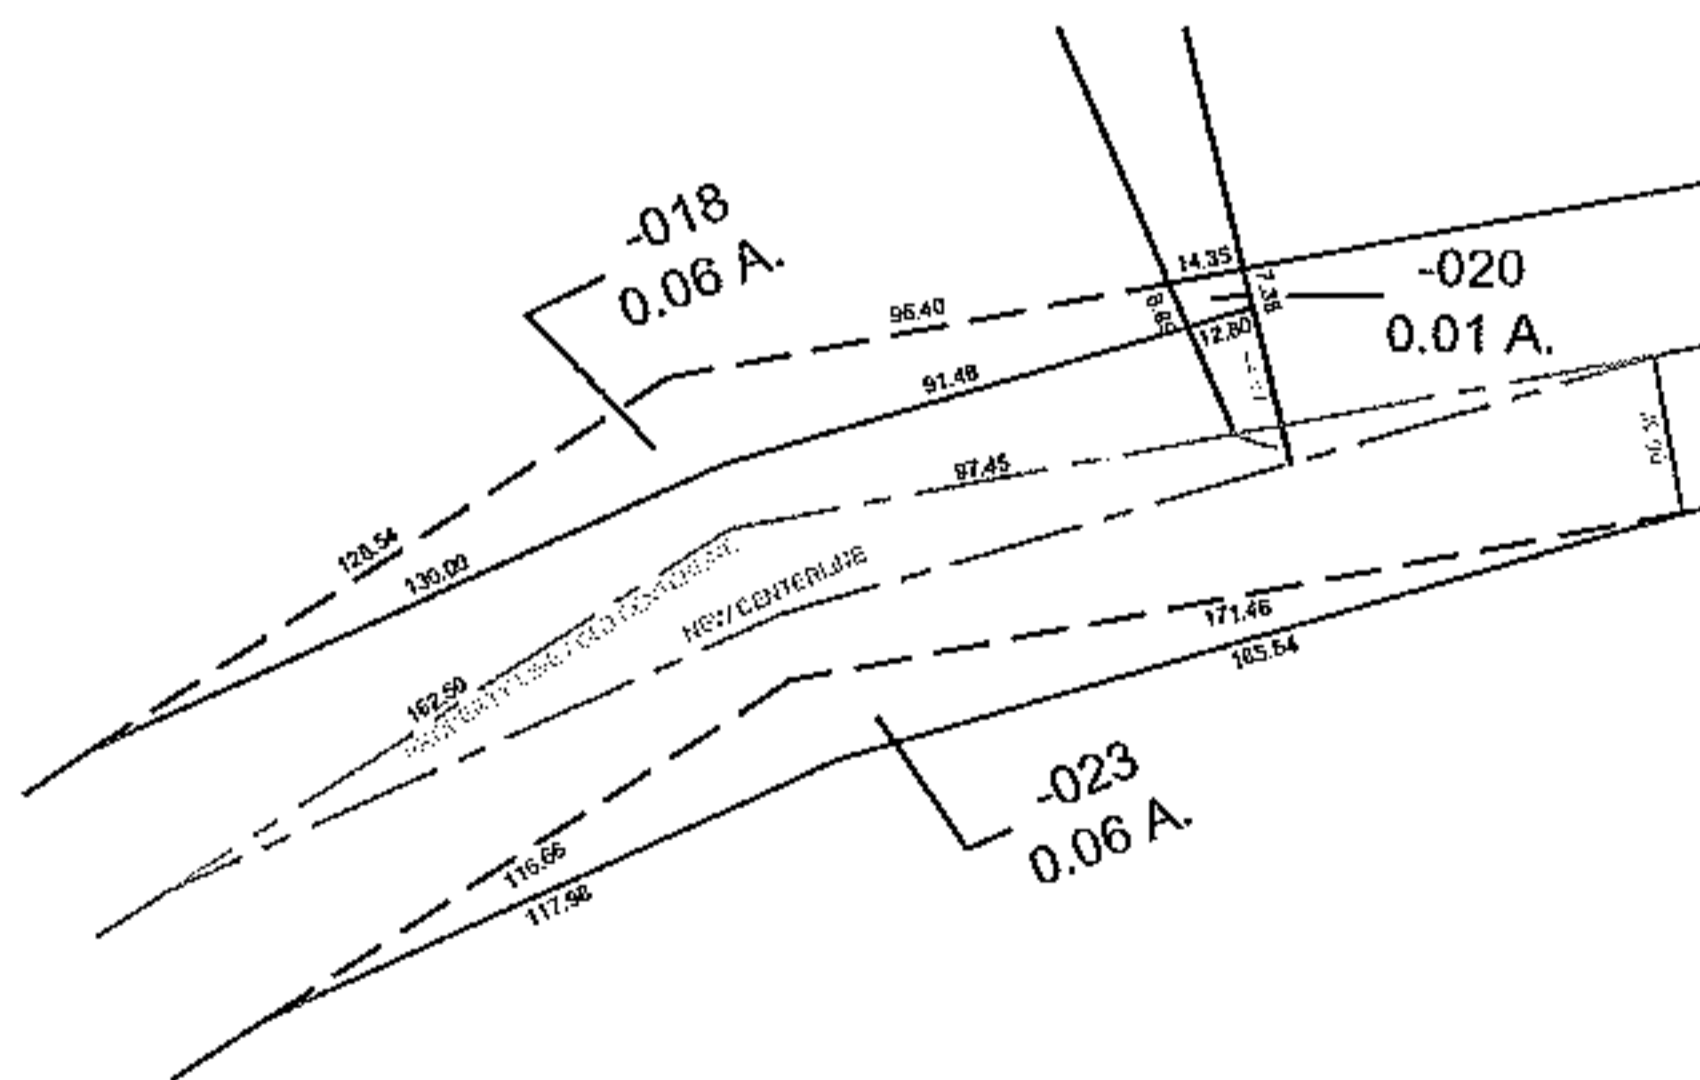

DEED CHECK

01-00-060-000-018

0.06 A.

OR. 1326/746-747

NEED TO CORRECT P.P.N. &  
ACREAGE ON DEED


01-00-060-000-020

0.01 A.

OR. 1326/746-747

NEED TO CORRECT P.P.N. &  
ACREAGE ON DEED

PG. 1 OF 3

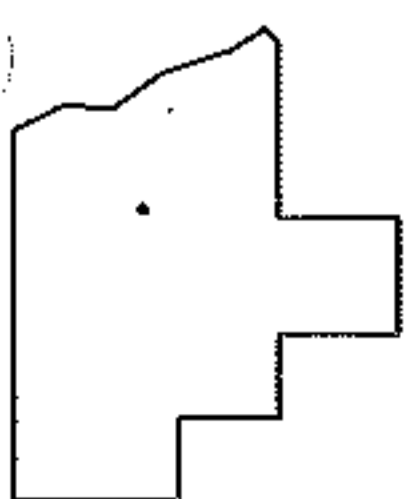

SPLITS/DEEDS PROCESSED

LORAIN COUNTY TAX MAP DEPARTMENT  
226 MIDDLE AVE. ELYRIA, OHIO

SURVEYED BY: LORAIN COUNTY ENGINEER

CLOSURE: 0.01 : 10,000

MAP PAGE(S): 1-K

APPROVED BY: TJS DATE: 11/20/13

SCALE: 1" = 200 PRIOR INSTRUMENT: