


PARENT PARCEL: 10-00-015-108-067, -068



CHILD PARCEL: _____

STARTING POINT: SOUTHEAST CORNER OF S/L 125 IN BRENTWOOD ALLOT. NO.2 (VOL.16 PG.11)

13-02850-D

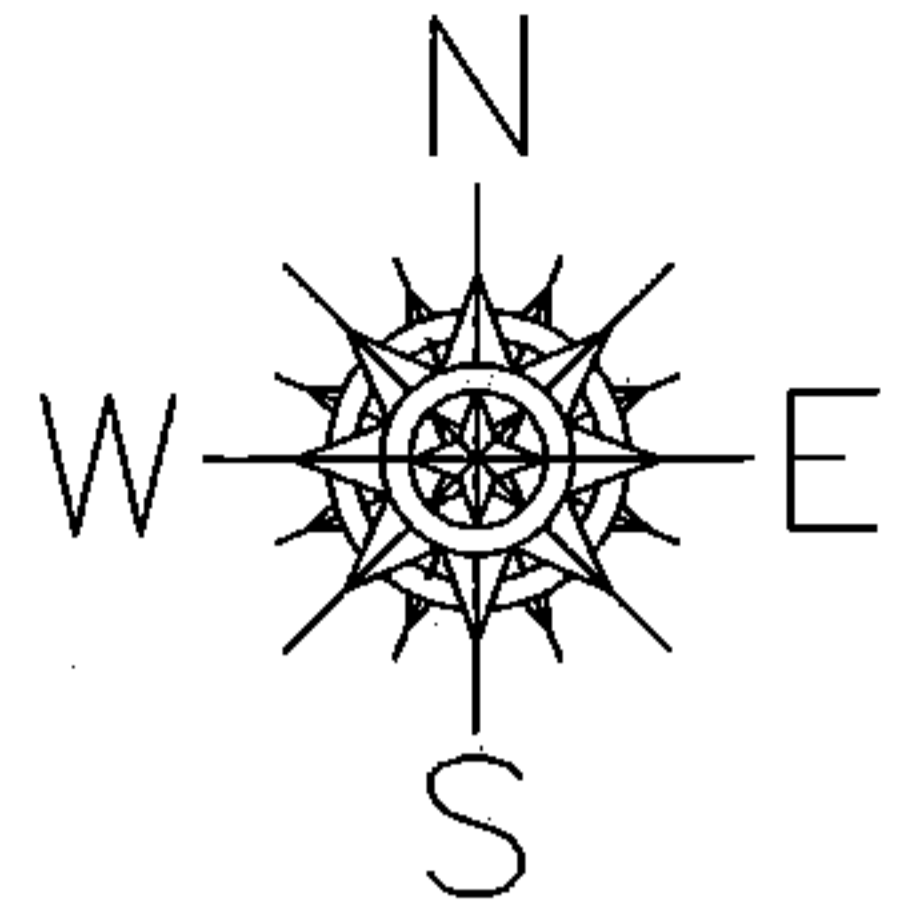

MAP CORRECTION ONLY

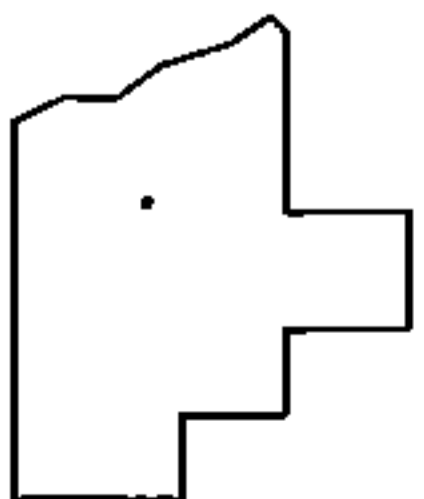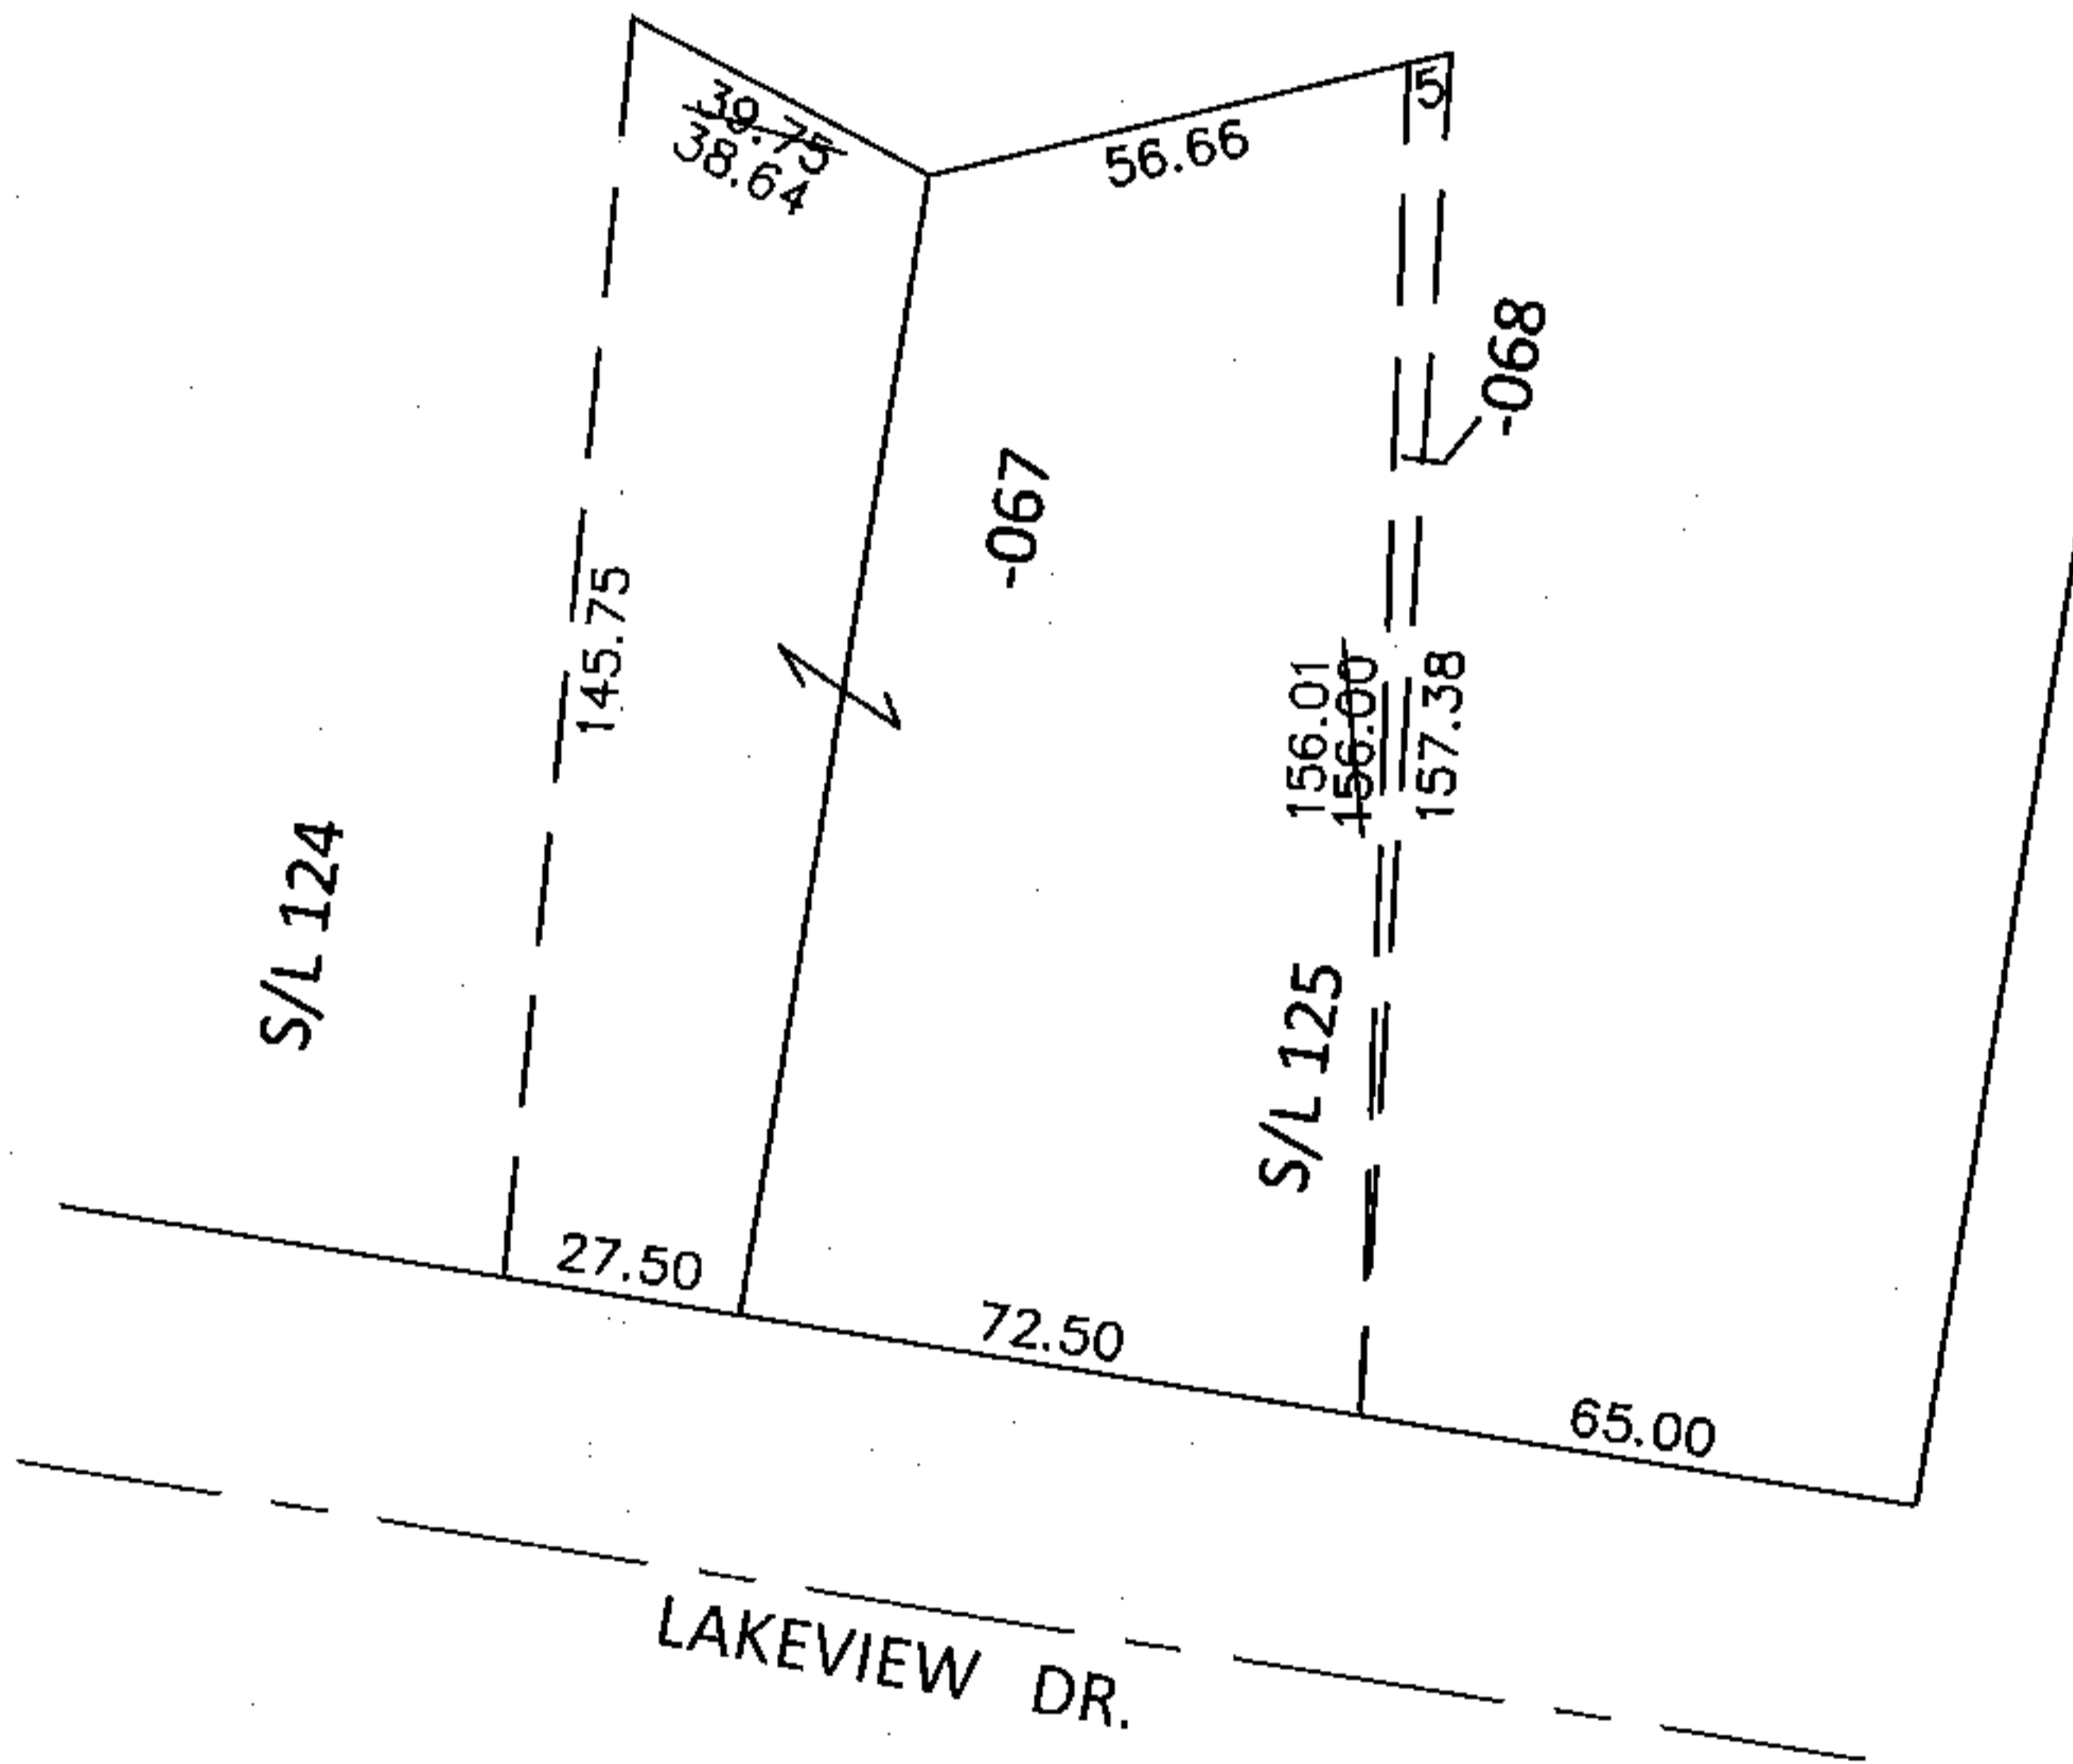

SPLITS/DEEDS PROCESSED

LORAIN COUNTY TAX MAP DEPARTMENT
226 MIDDLE AVE. ELYRIA, OHIO

SURVEYED BY: MICHAEL MACKAY

CLOSURE: .01:10,000

MAP PAGE(S): 10-00-015-D

APPROVED BY: RRM DATE: 11-20-13

SCALE: 1"= 50' PRIOR INST.: _____