
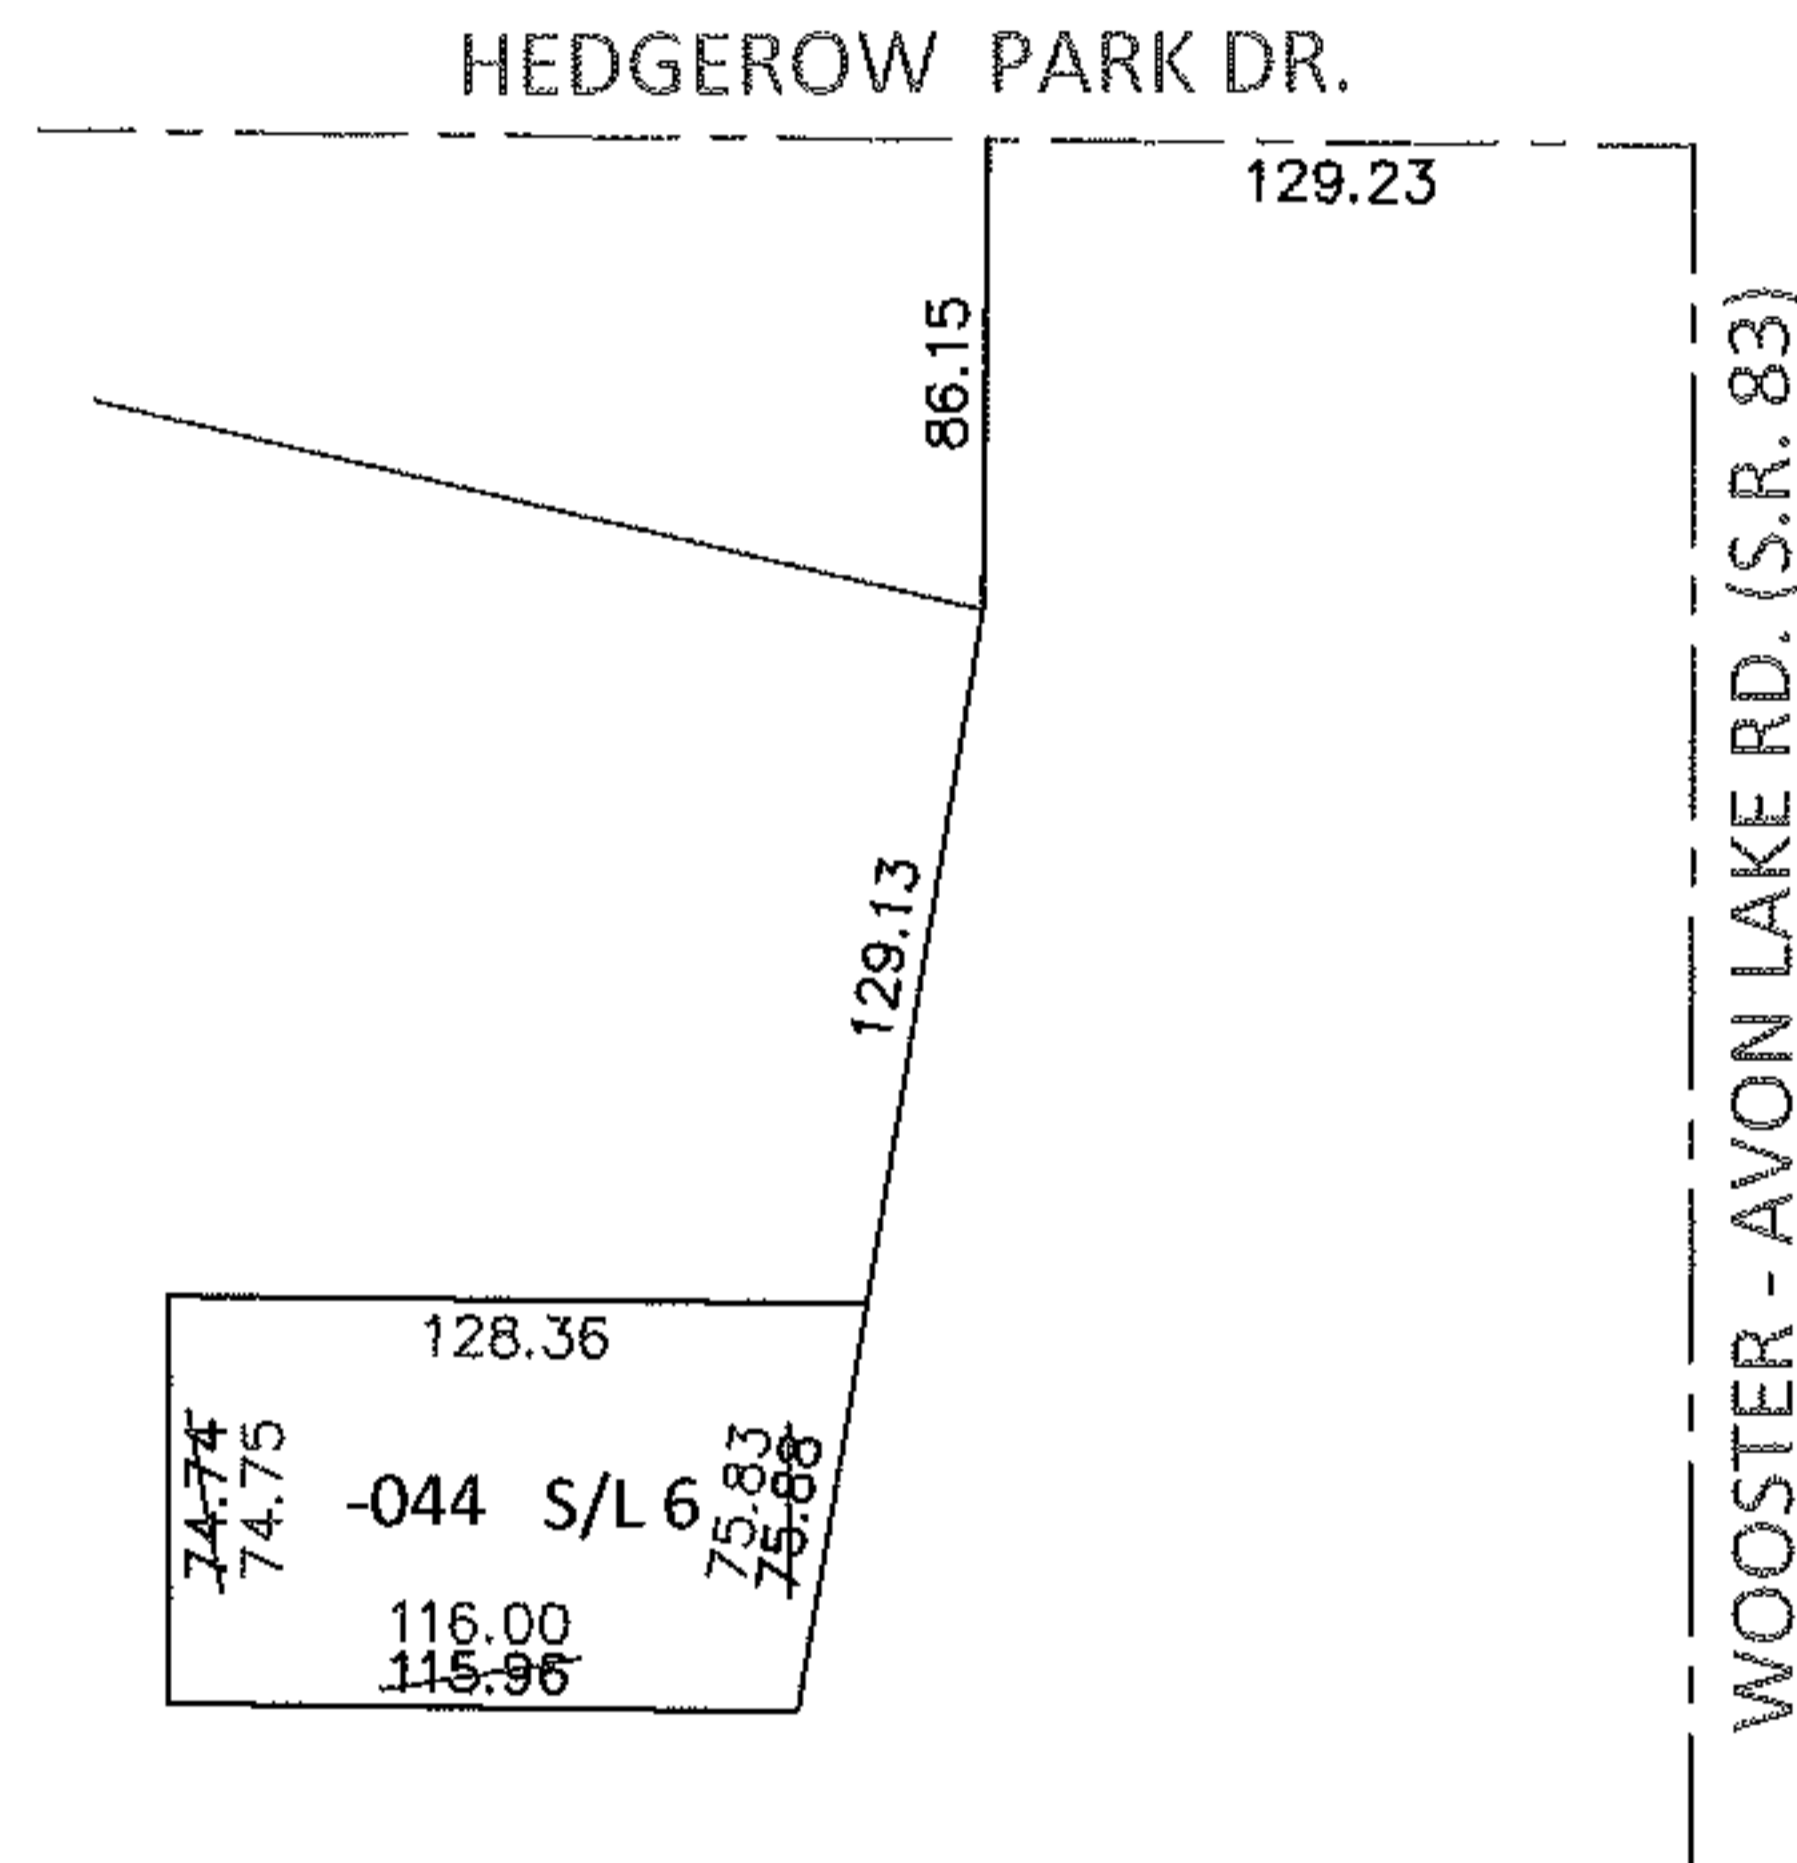


PARENT PARCEL: 07-00-025-105-044

CHILD PARCEL: _____

STARTING POINT: XXXXXX

13-02851-D

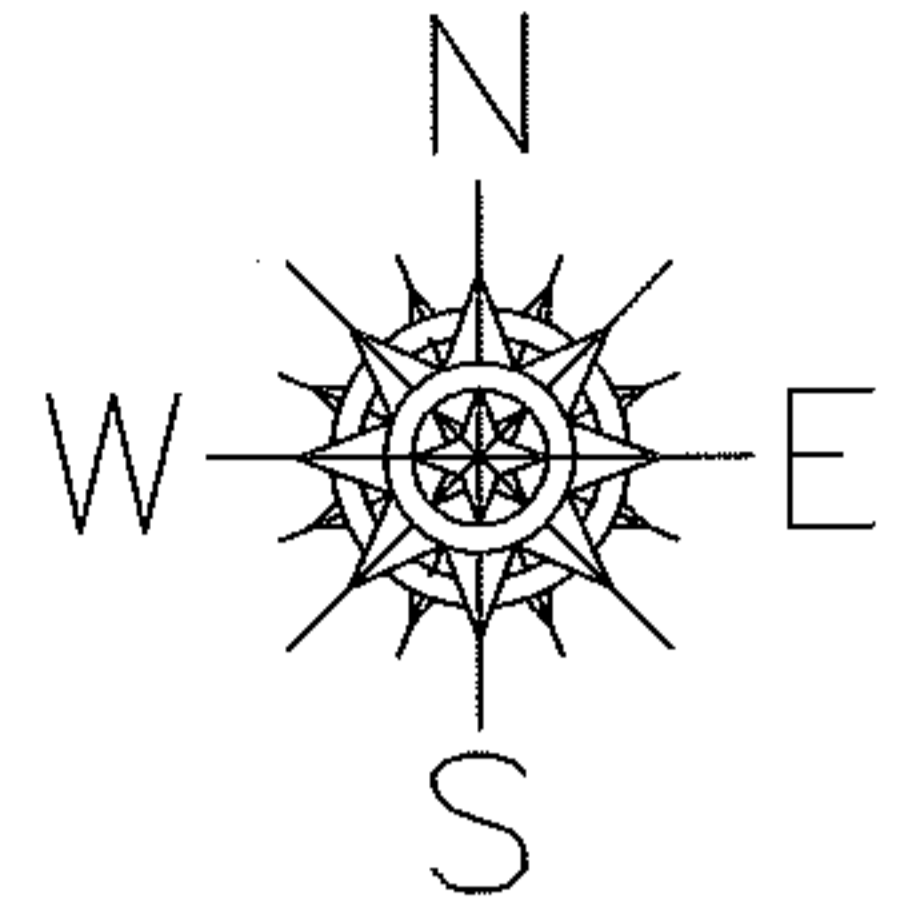


FRONTAGE AND DEPTH CORRECTION

07-00-025-105-044

75.83 X 128.36

~~75.88 X 128.30~~

CORR.PER.SURV. T.SIMON

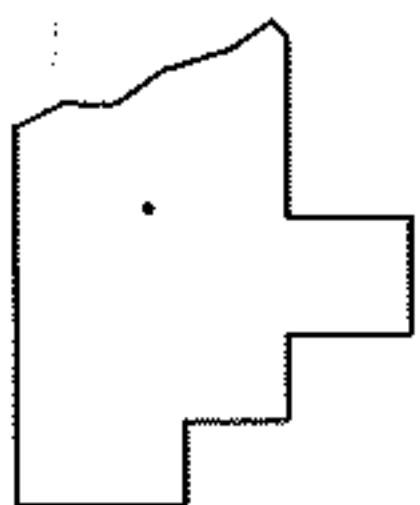

SPLITS/DEEDS PROCESSED

LORAIN COUNTY TAX MAP DEPARTMENT
226 MIDDLE AVE. ELYRIA, OHIO

SURVEYED BY: THOMAS A. SIMON

CLOSURE: .01:10,000

MAP PAGE(S): 7-00-025-B

APPROVED BY: RRM DATE: 11-26-13

SCALE: 1" = 100

PRIOR INST.: _____