
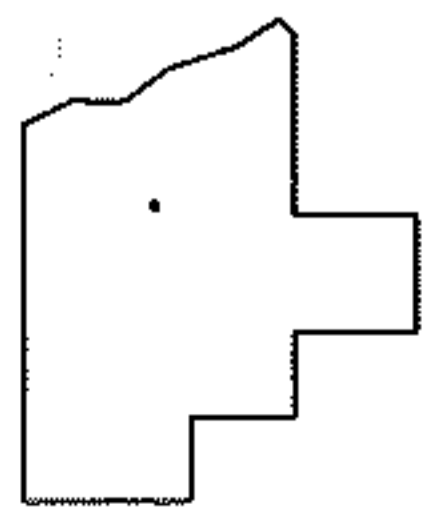
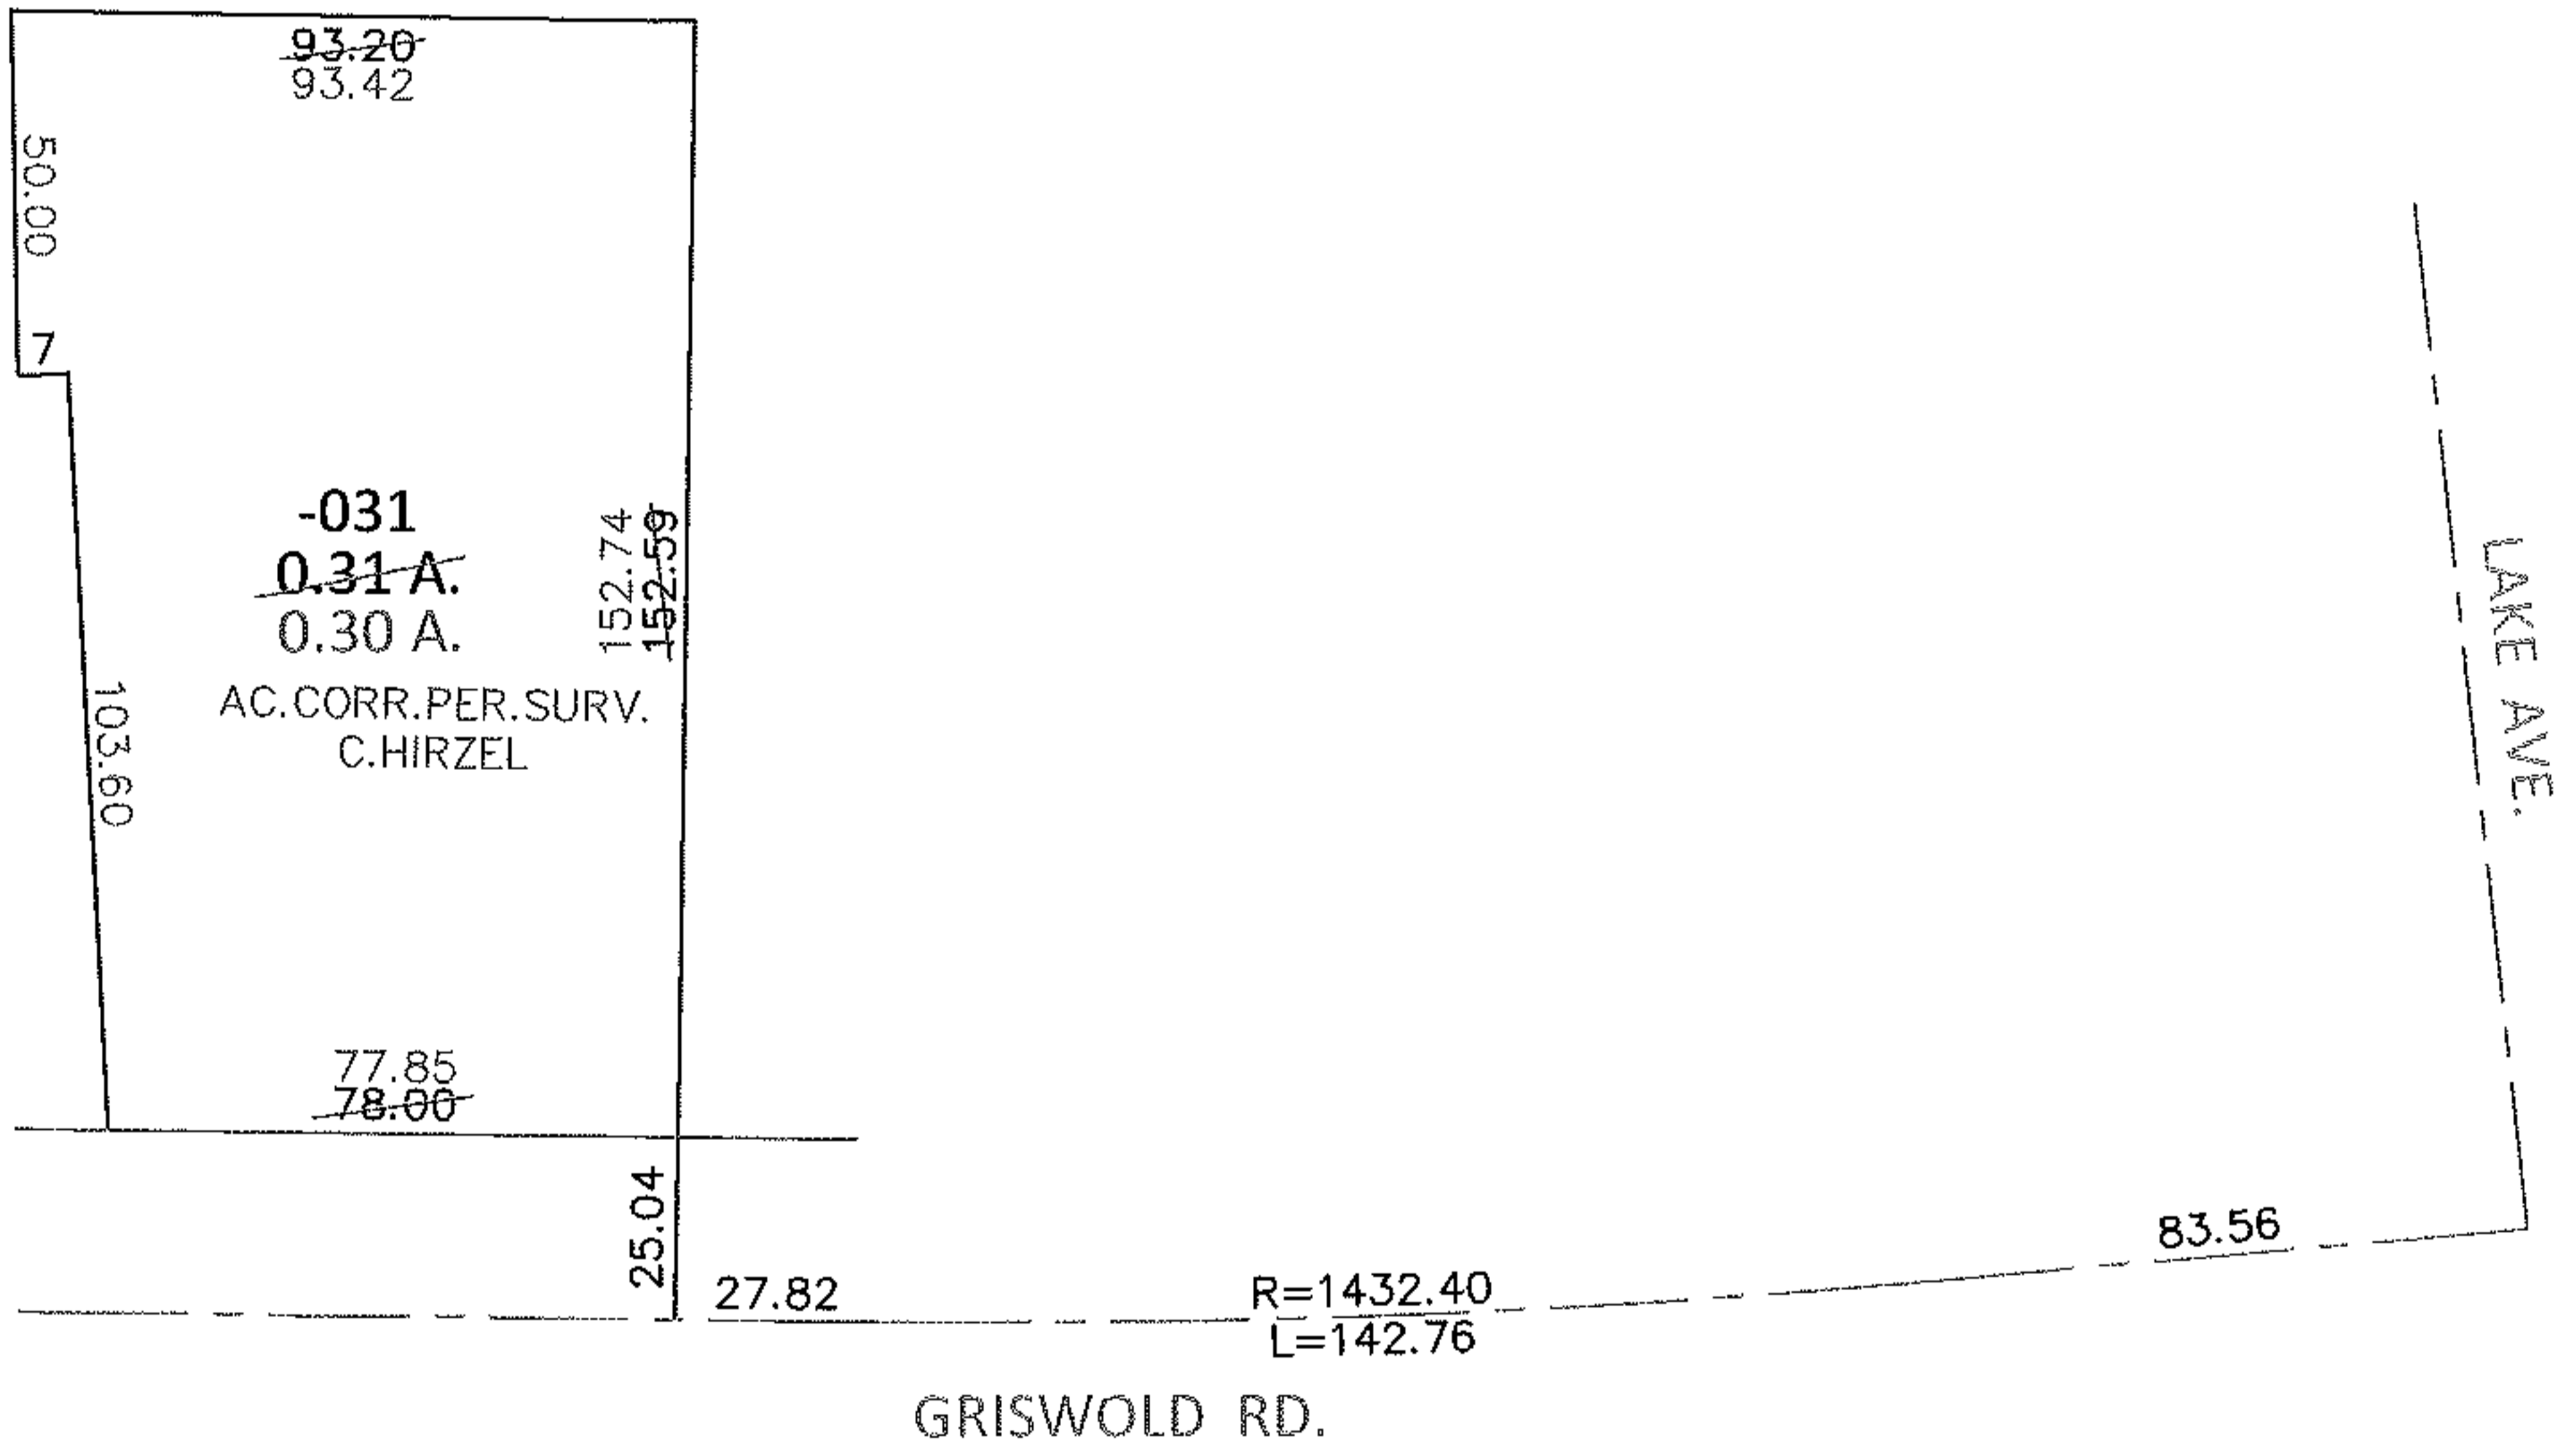


PARENT PARCEL: 06-23-011-101-031

CHILD PARCEL: _____

13-02853-D

STARTING POINT: INTERSECTION OF C/L OF LAKE AVE. AND C/L OF GRISWOLD RD.

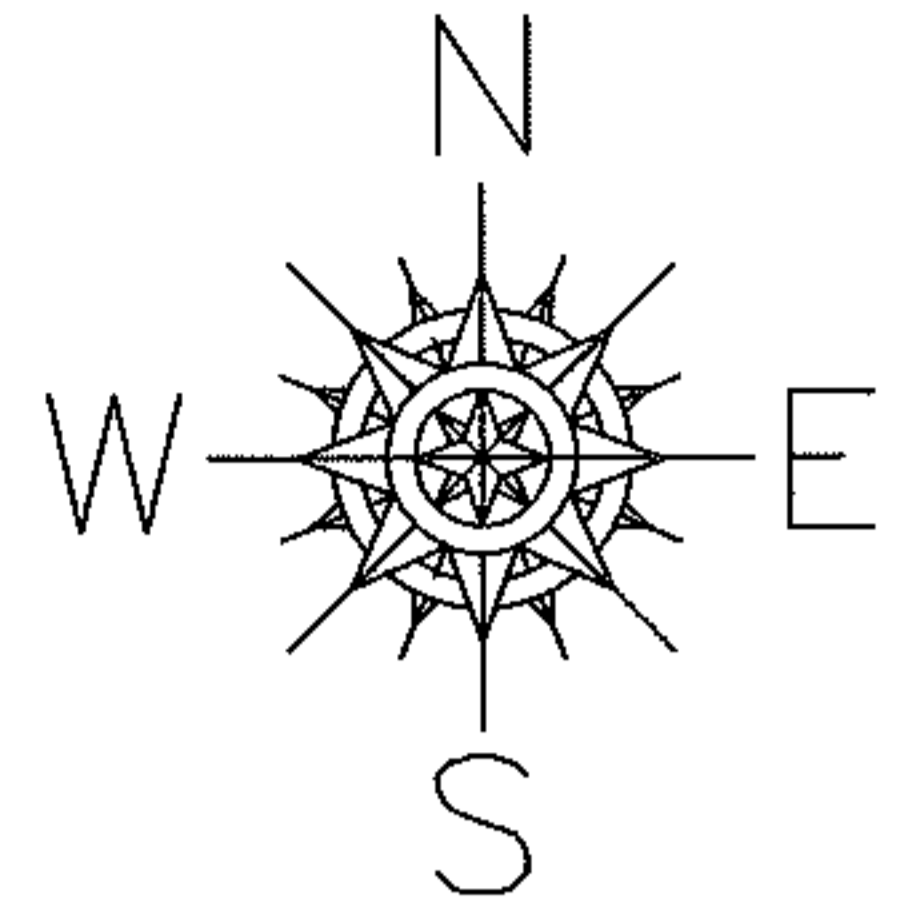

SPLITS/DEEDS PROCESSED

LORAIN COUNTY TAX MAP DEPARTMENT
226 MIDDLE AVE. ELYRIA, OHIO

SURVEYED BY: CHRISTOPHER M. HIRZEL
 CLOSURE: .01:10,000
 MAP PAGE(S): 6-42
 APPROVED BY: RRM DATE: 12-2-13
 SCALE: 1" = 50' PRIOR INST.: 20020825406