
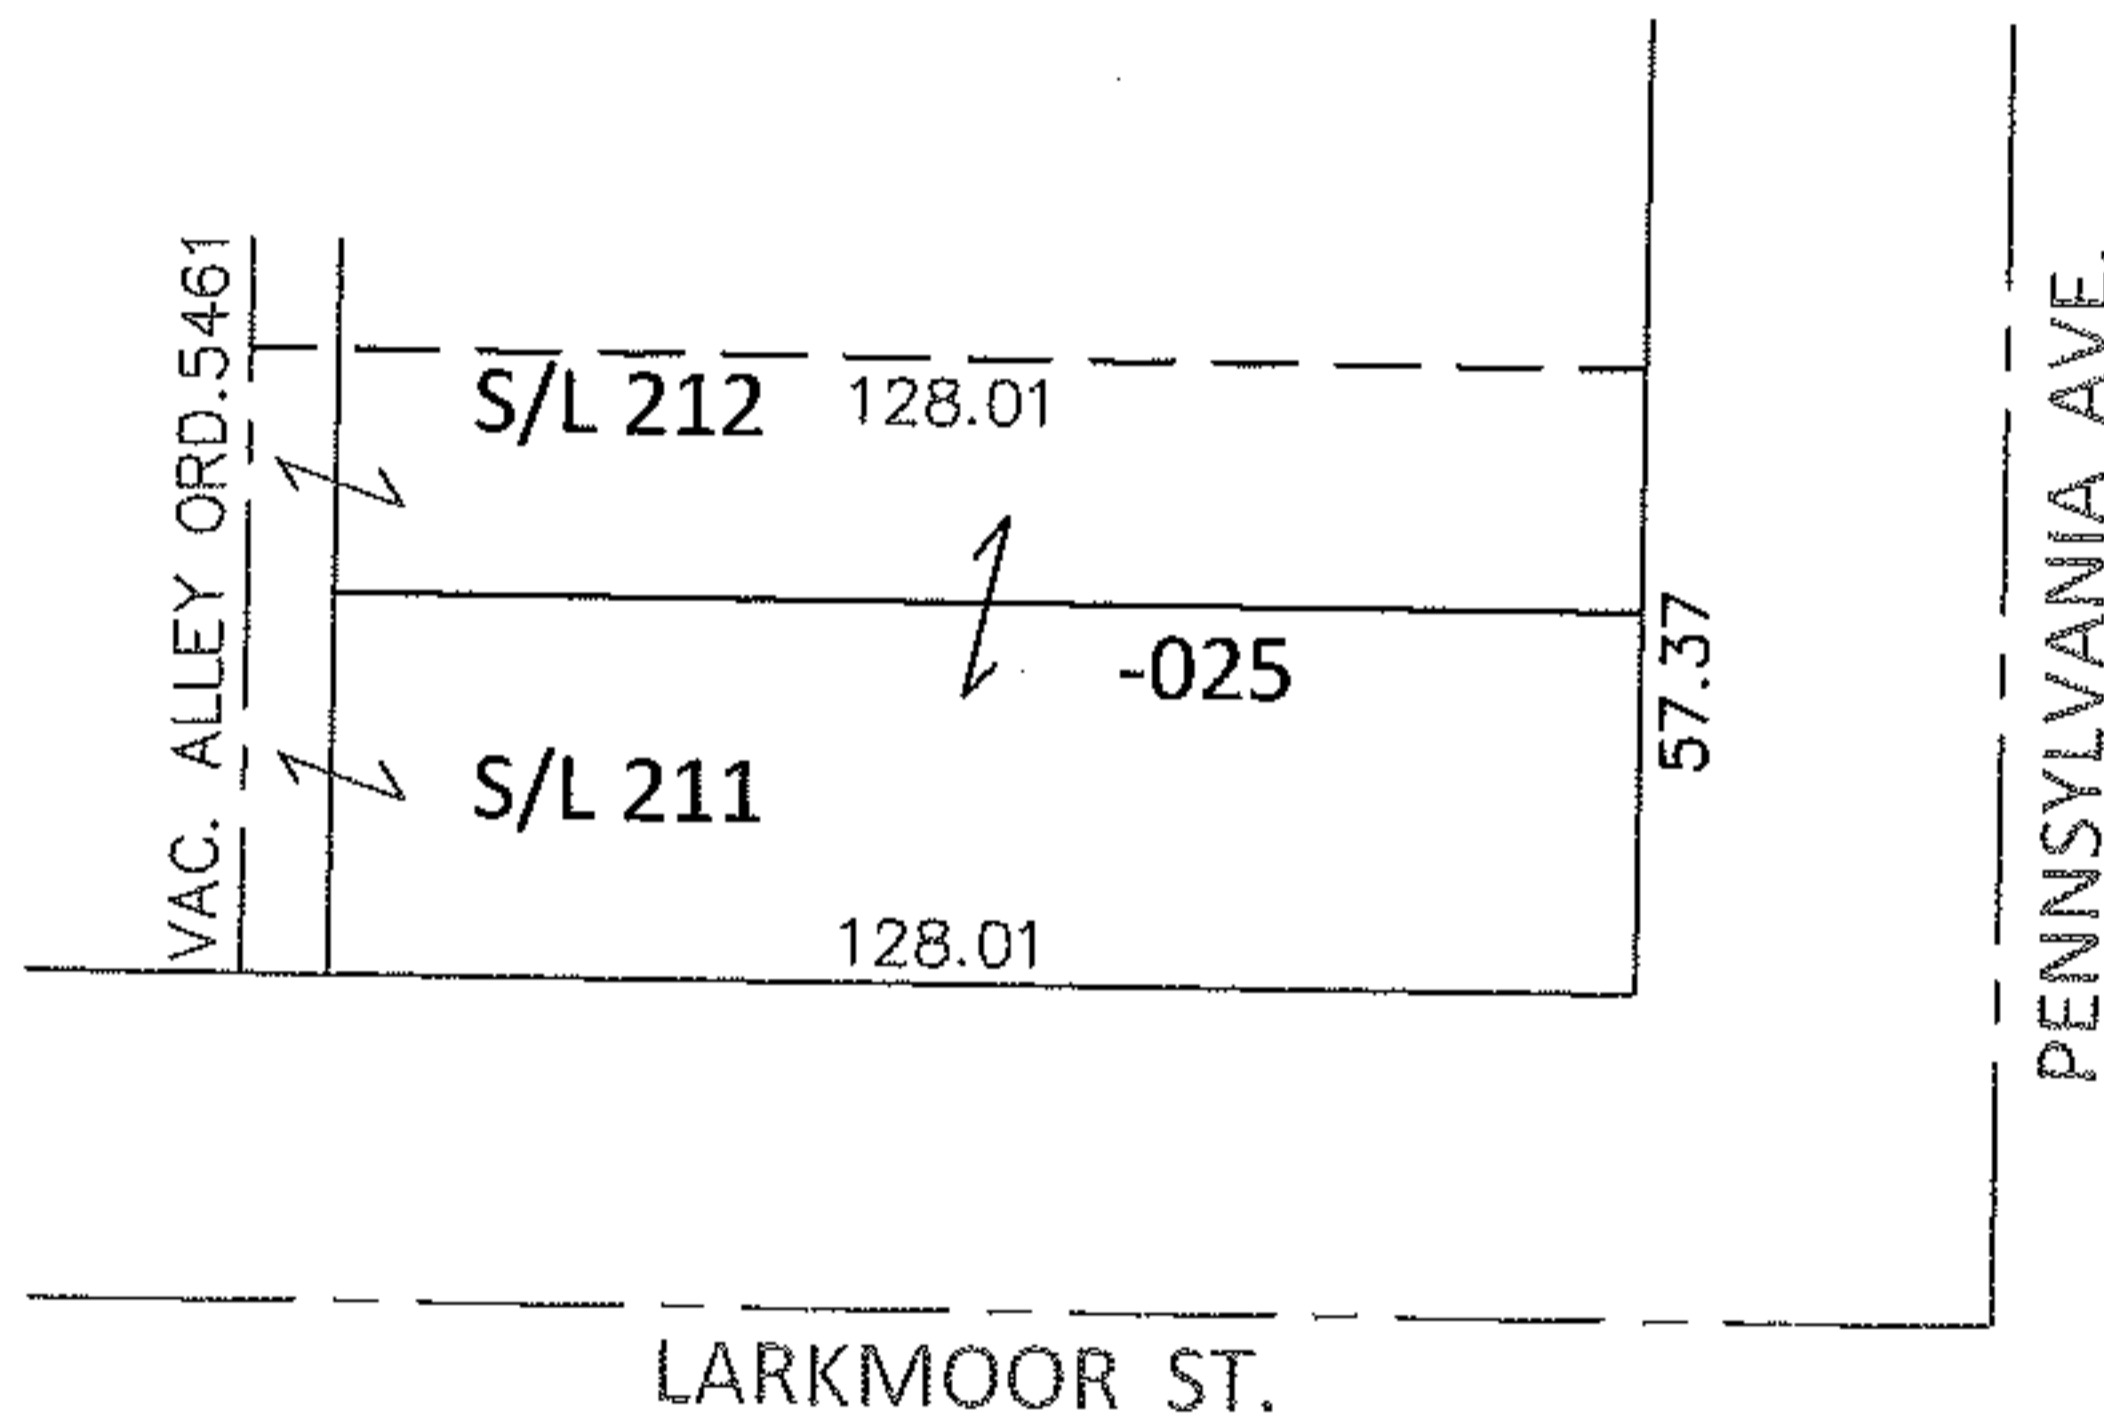


PARENT PARCEL: 03-00-056-104-025

CHILD PARCEL: \_\_\_\_\_

STARTING POINT: S/L 211 AND SOUTHERLY 22.37 FT. OF S/L 212 IN LARKMOOR SUB.(VOL.9 PG.20)

13-02856-A

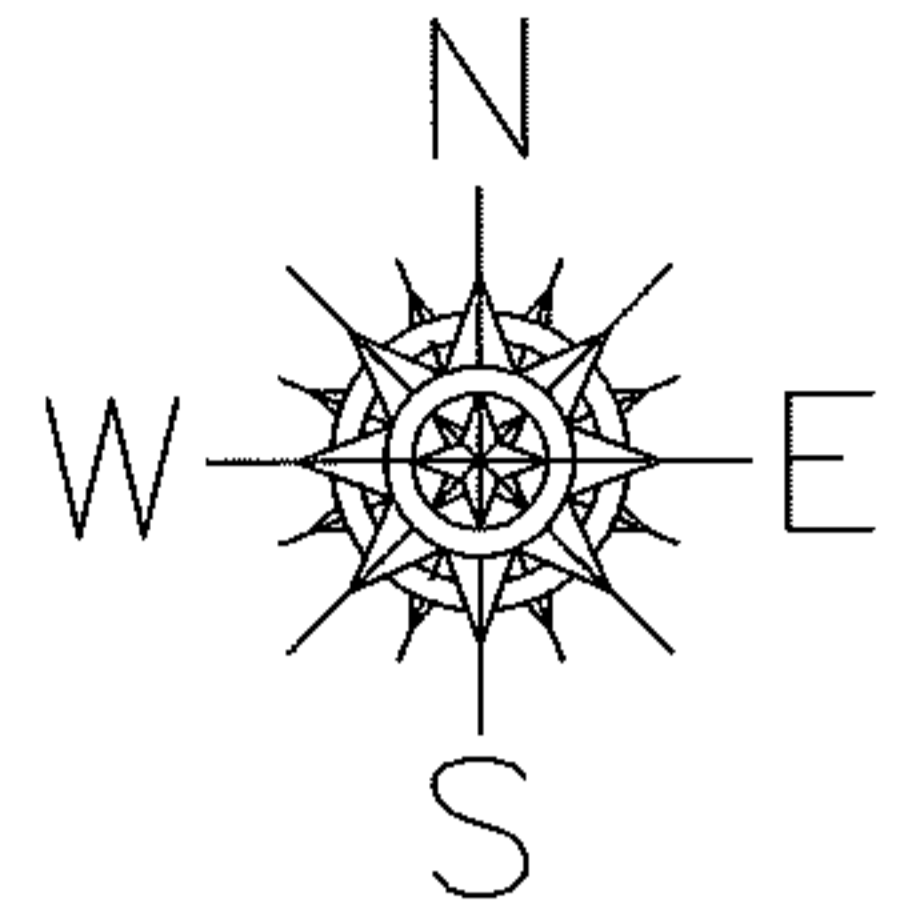


DEPTH CORRECTION

03-00-056-104-025

128.01

57.37 X ~~120.00~~

PER PRIOR DEEDS AND ORD. NO.5461

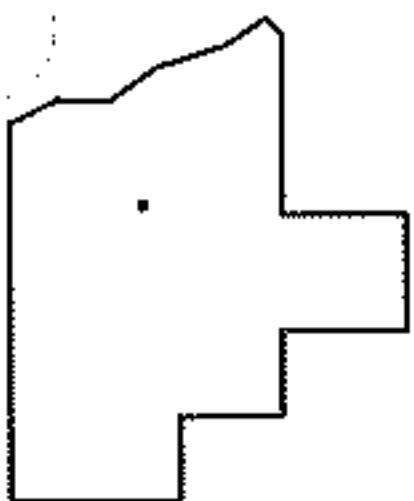

SPLITS/DEEDS PROCESSED

LORAIN COUNTY TAX MAP DEPARTMENT  
226 MIDDLE AVE. ELYRIA, OHIO

SURVEYED BY: N/A

CLOSURE: N/A

MAP PAGE(S): 3-00-056-A

APPROVED BY: RRM DATE: 1-15-14

SCALE: 1" = 50' PRIOR INST.: 20110383567