




RASTER

PARENT PARCEL: 07-00-033-101-012, 07-00-028-101-066 (ST)

CHILD PARCEL: 07-00-033-101-022 THRU -024

STARTING POINT: CENTERLINE OF CENTER RIDGE RD & STONEY RIDGE RD

10-02857

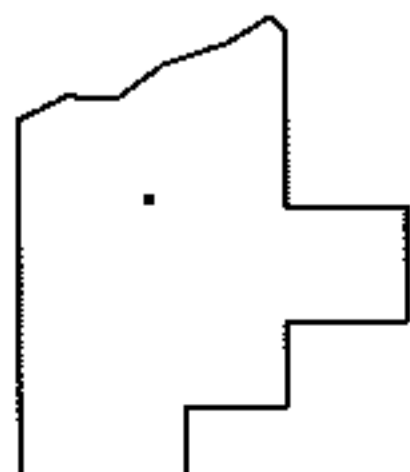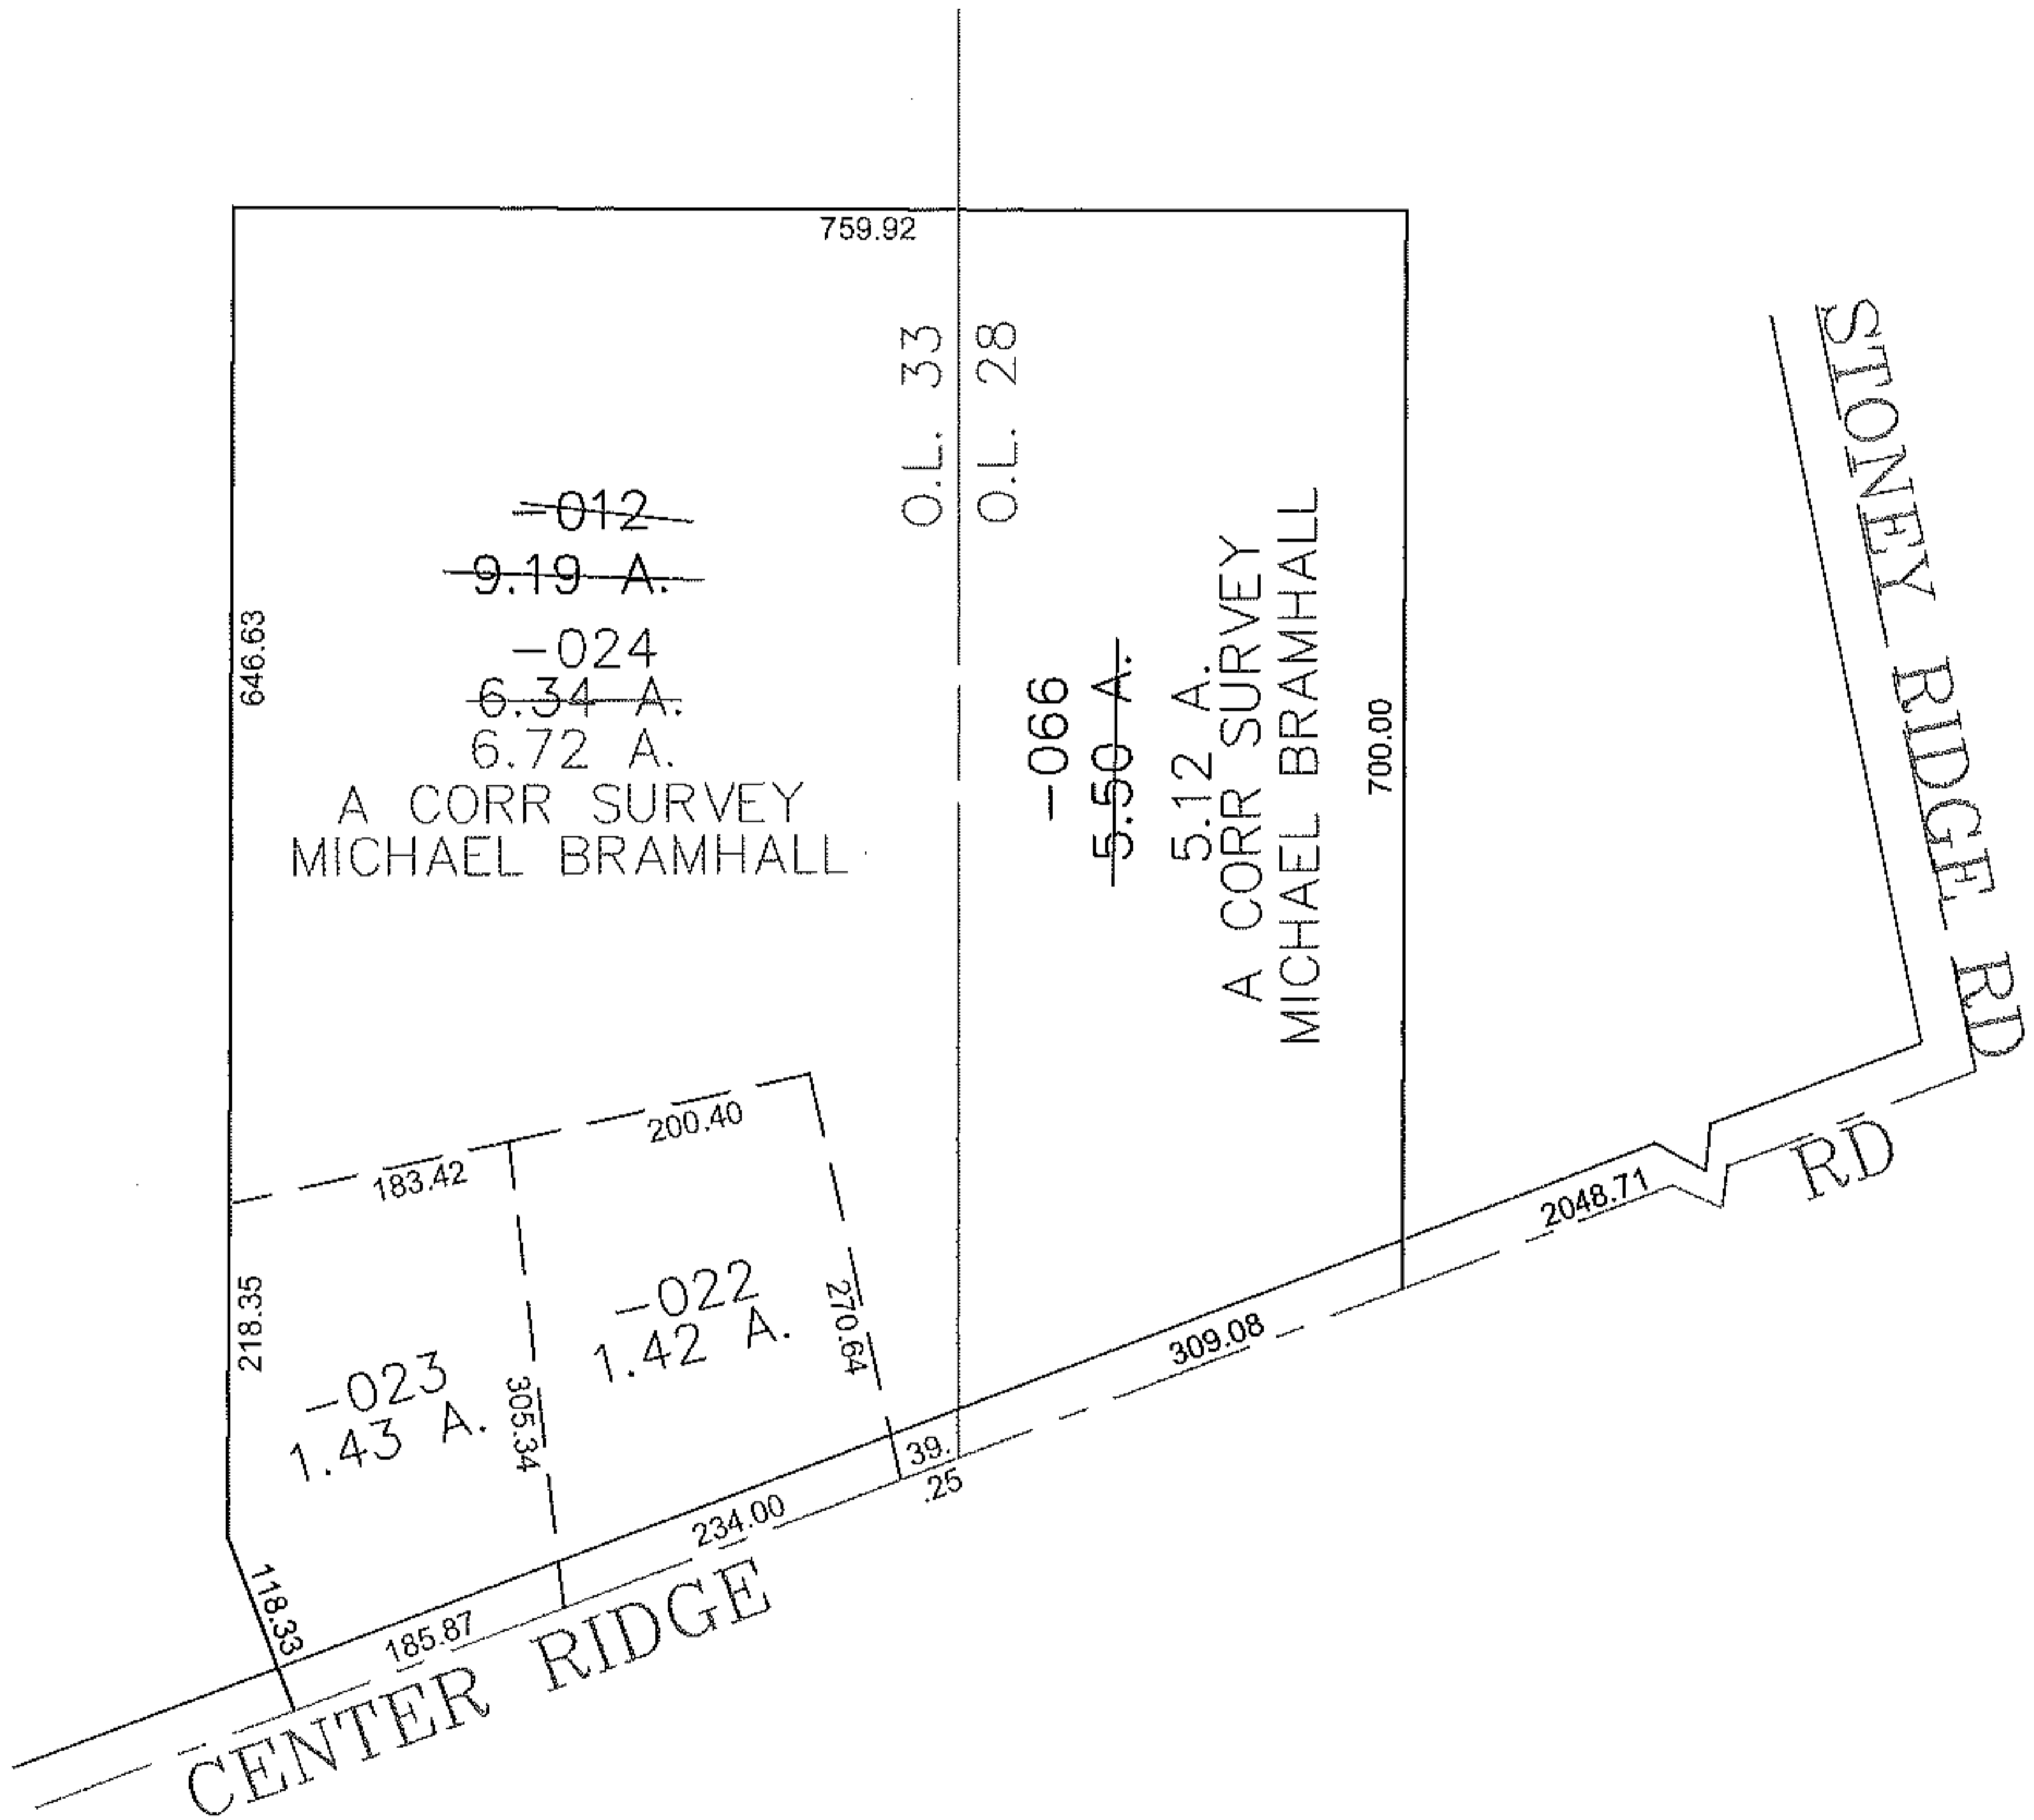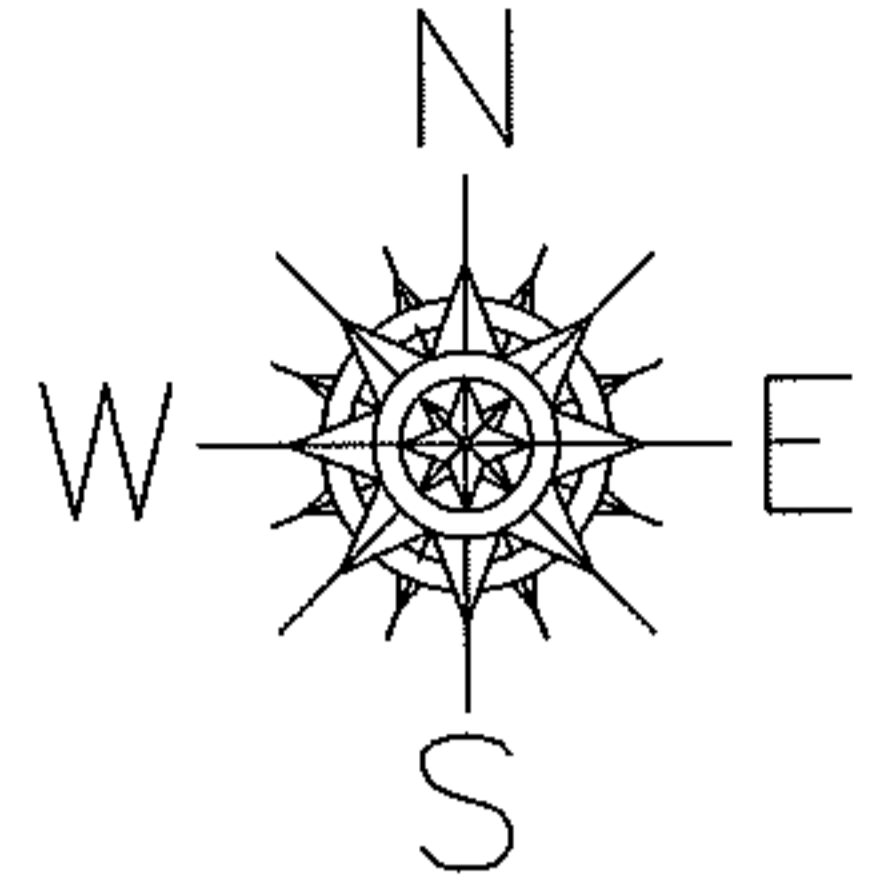

**SPLITS/DEEDS PROCESSED**  
 LORAIN COUNTY TAX MAP DEPARTMENT  
 226 MIDDLE AVE. ELYRIA, OHIO

SURVEYED BY: MICHAEL BRAMHALL  
 CLOSURE: 0.00 : 10.000  
 MAP PAGE(S): 7-B & 7-00-028-C  
 APPROVED BY: JAH DATE: 9-7-2010  
 SCALE: 1" = 200 PRIOR INSTRUMENT: 20070236217