
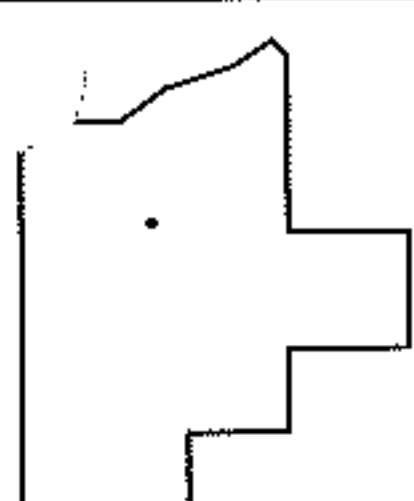
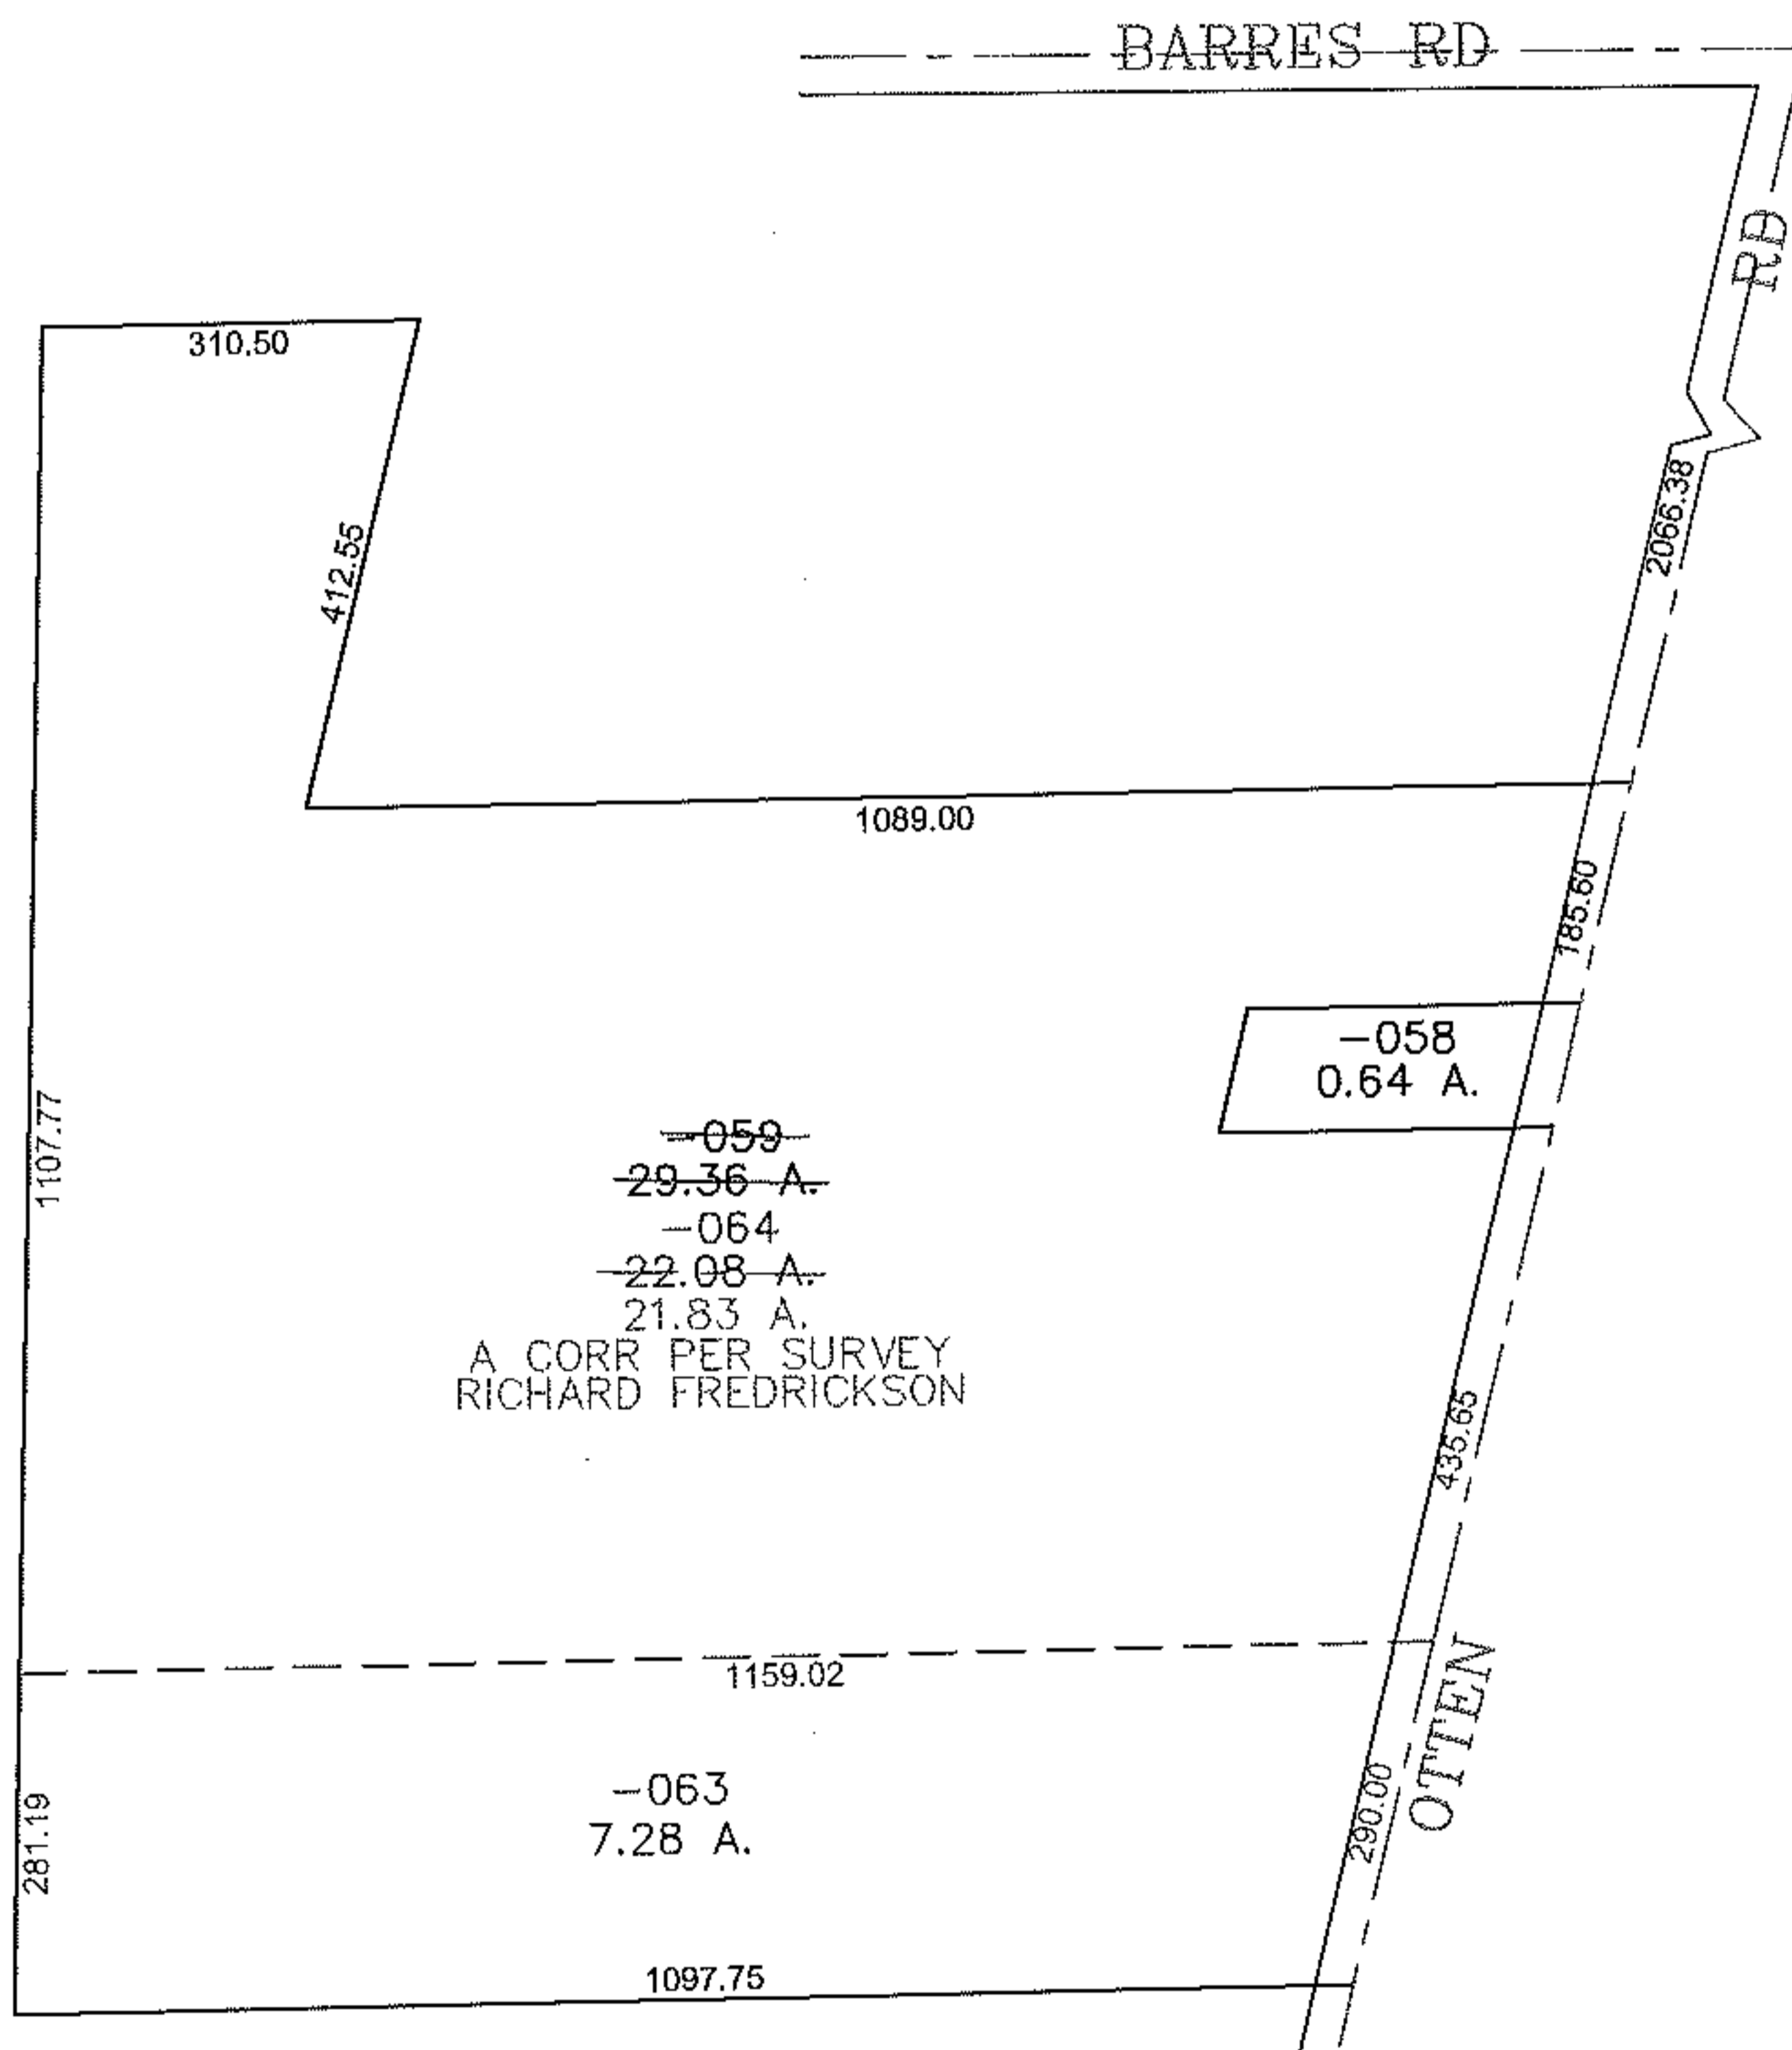


PARENT PARCEL: 07-00-041-000-059

CHILD PARCEL: 07-00-041-000-063, -064

STARTING POINT: CENTERLINE OF BARRES RD & OTTEN RD

10-02859

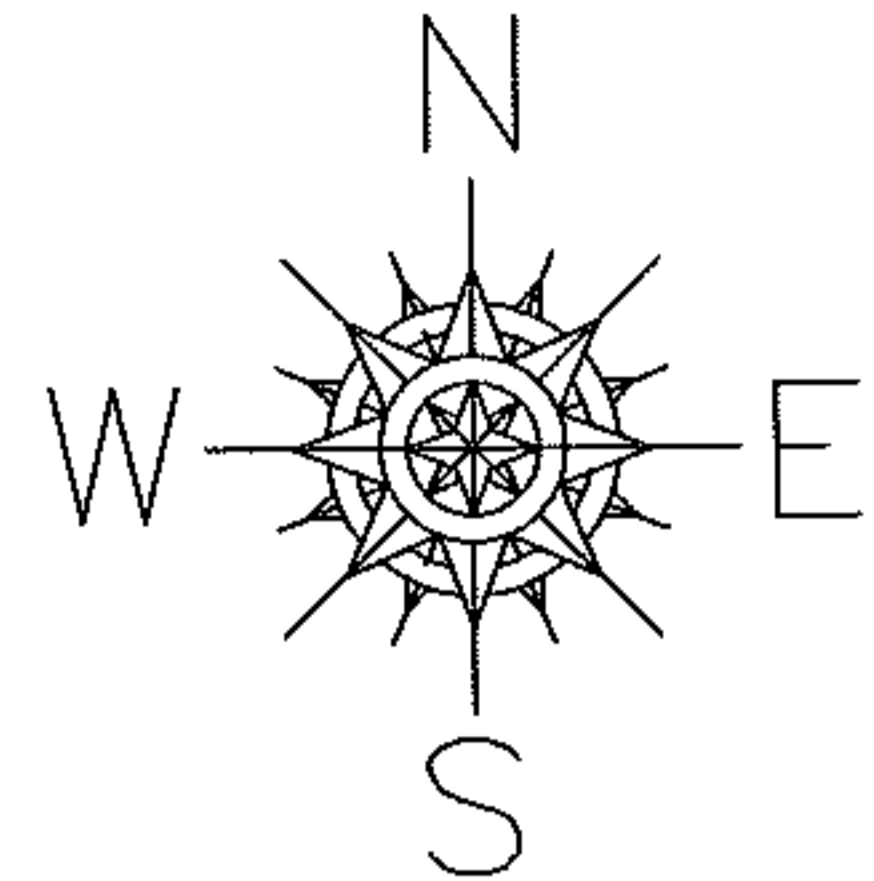

SPLITS/DEEDS PROCESSED
 LORAIN COUNTY TAX MAP DEPARTMENT
 226 MIDDLE AVE. ELYRIA, OHIO

SURVEYED BY: RICHARD FREDRICKSON
 CLOSURE: 0.00 : 10.000
 MAP PAGE(S): 7-A
 APPROVED BY: JAH DATE: 9-21-2010
 SCALE: 1" = 300 PRIOR INSTRUMENT: 20100329433