
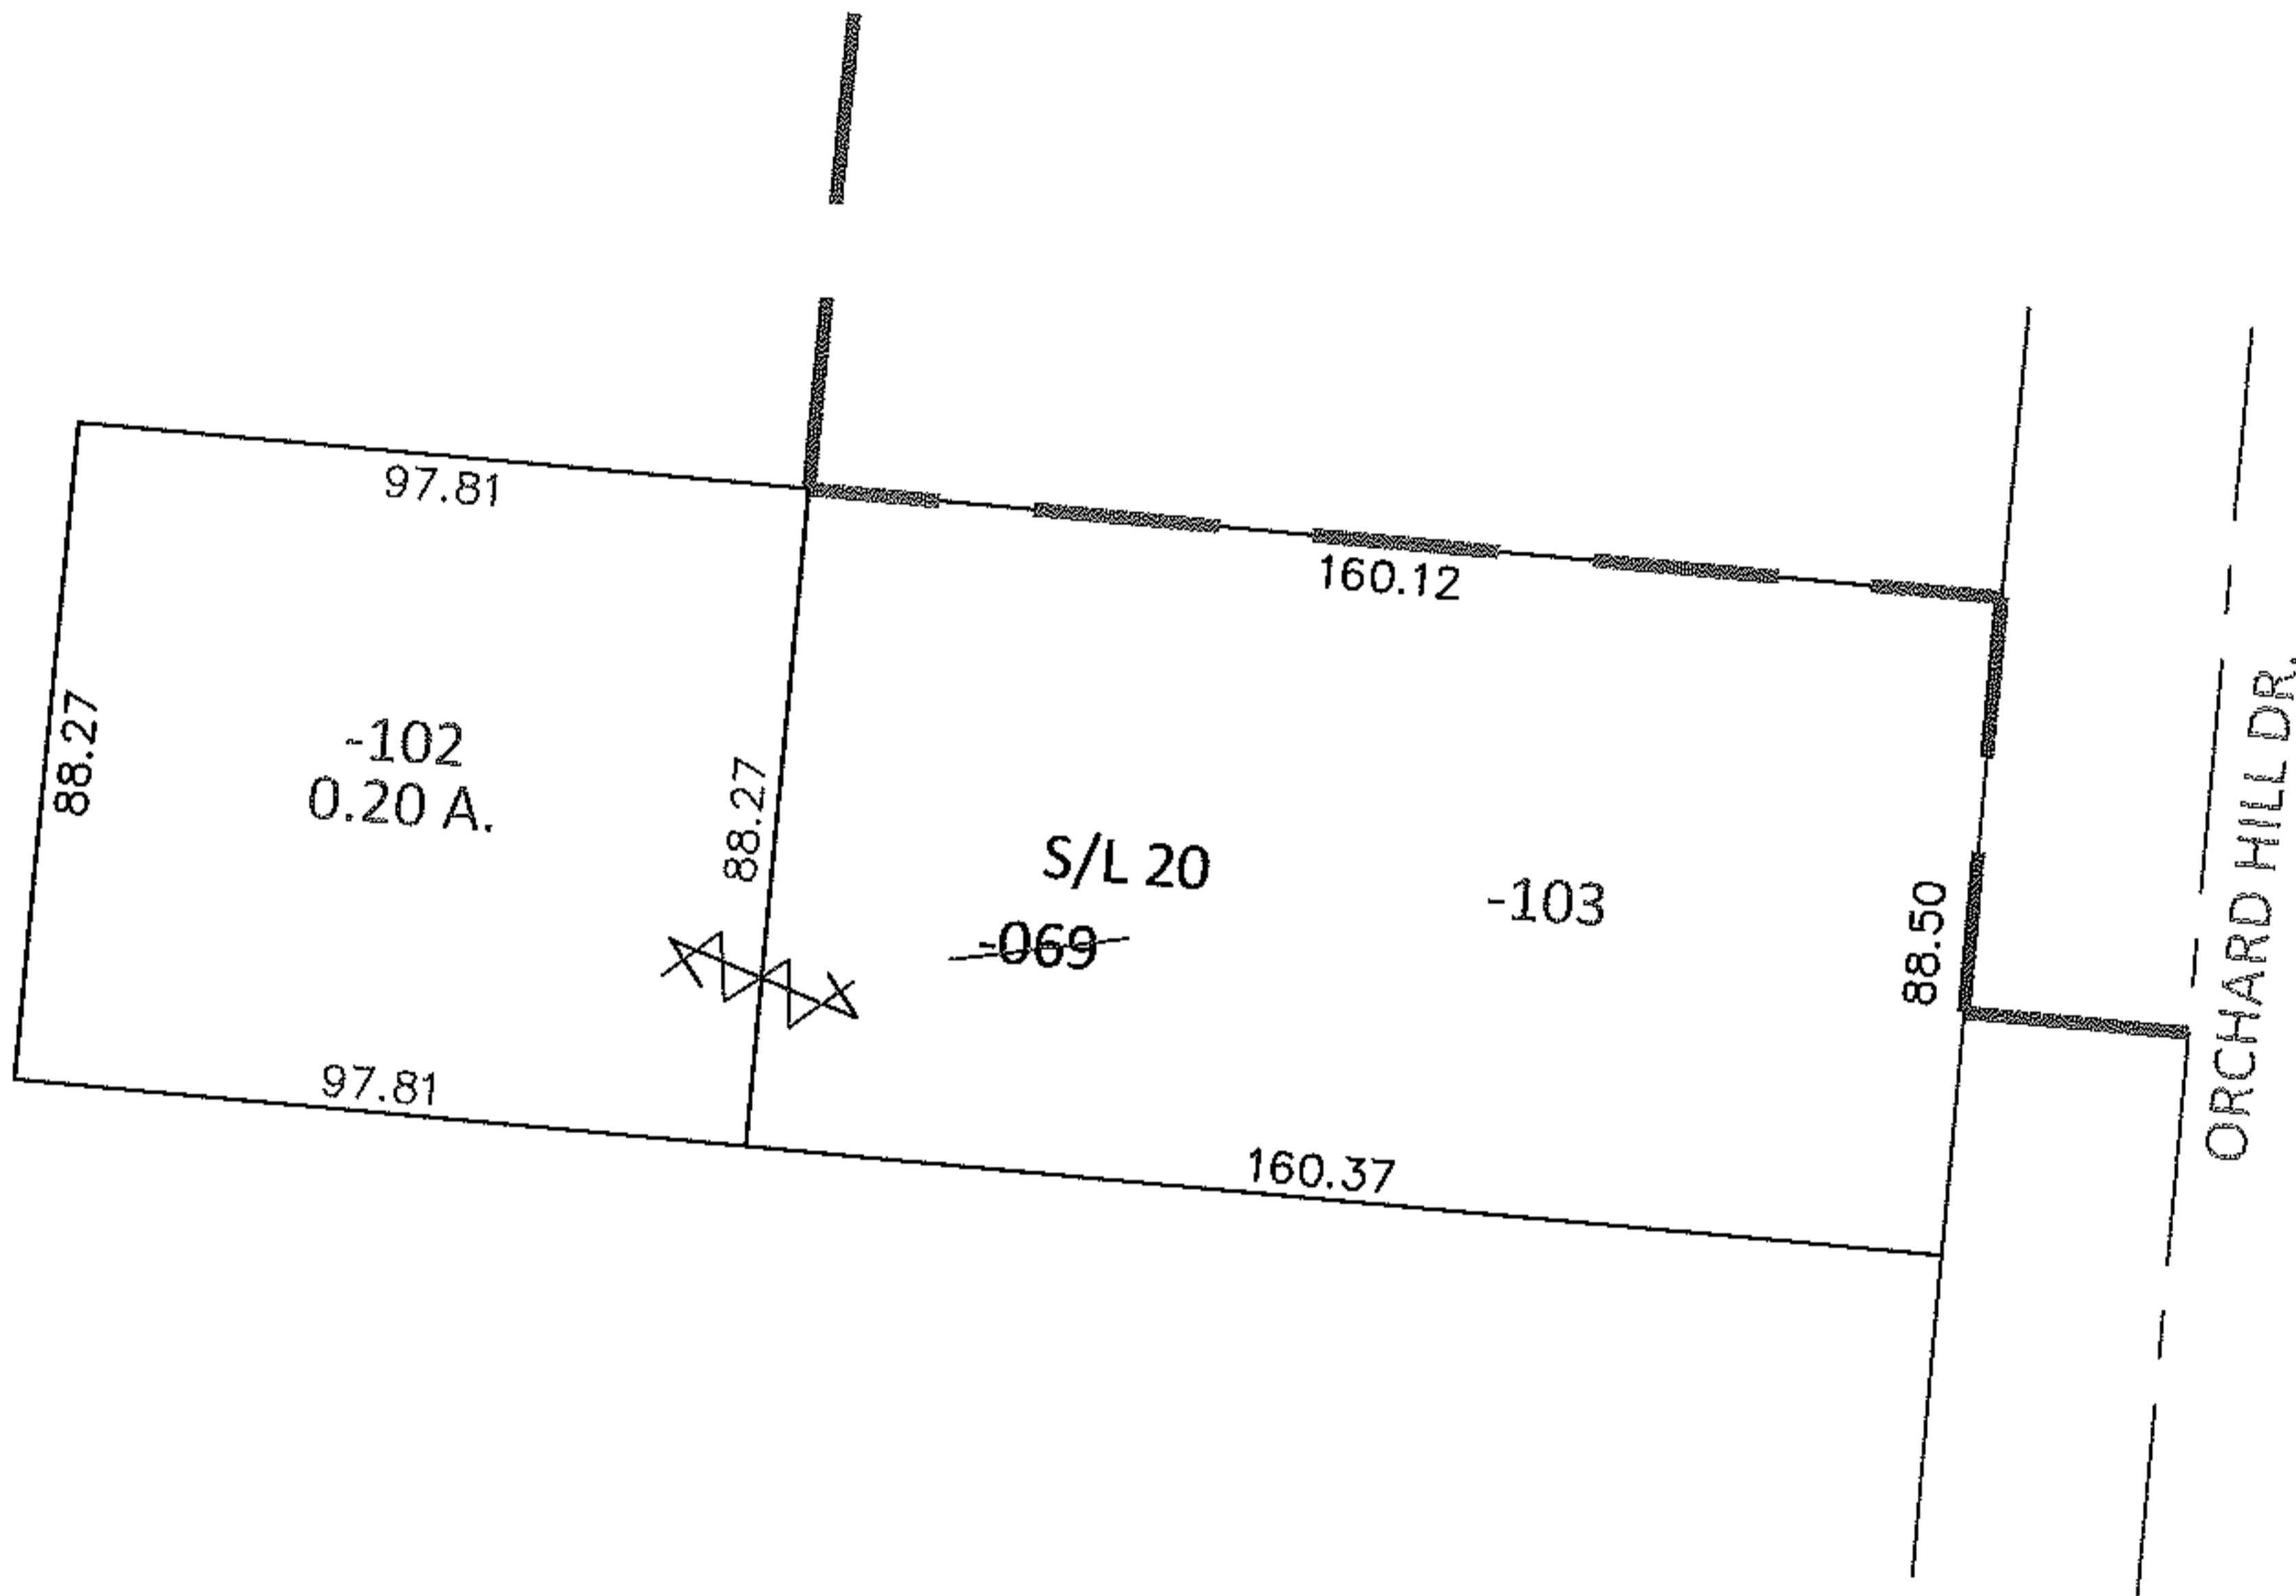


PARENT PARCEL: 05-00-038-106-069

CHILD PARCEL: 05-00-038-106-102, -103

STARTING POINT: SOUTHWEST CORNER OF S/L 18 IN RICE ALLOT. (VOL.20 PG.34)

13-02860-X

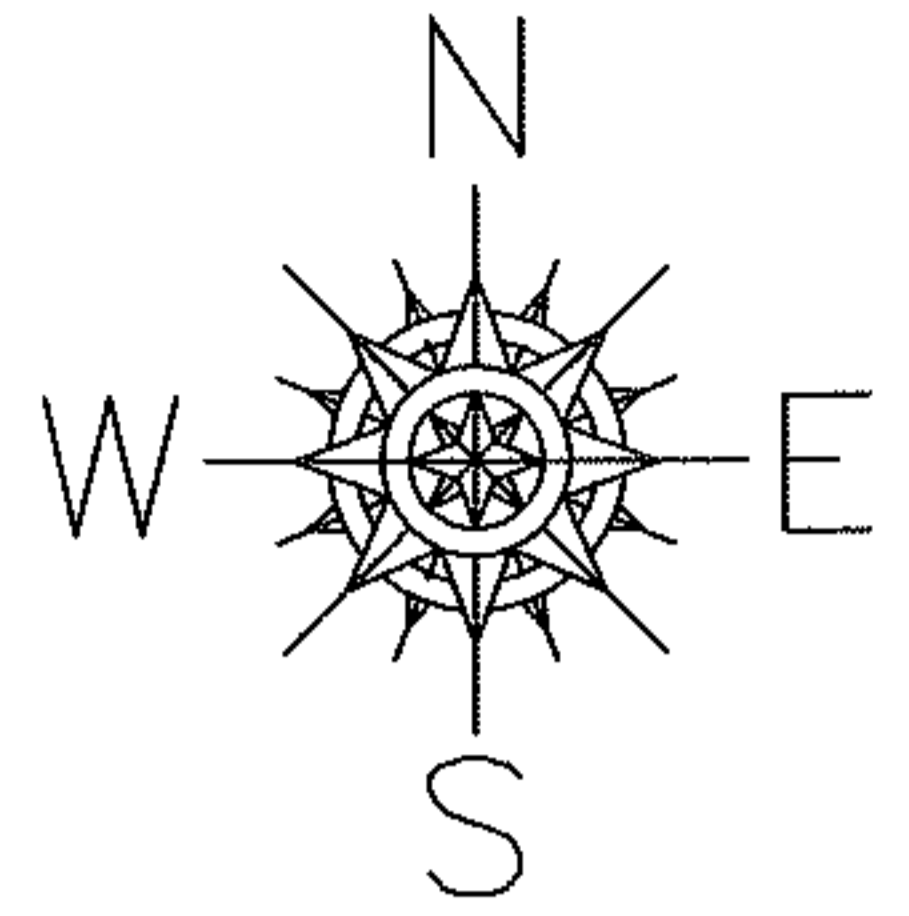


UNCOMBINATION

~~05-00-038-106-069~~

~~88.50 X 258~~

05-00-038-106-102  
0.20 A.

05-00-038-106-103  
88.50 X 160.37

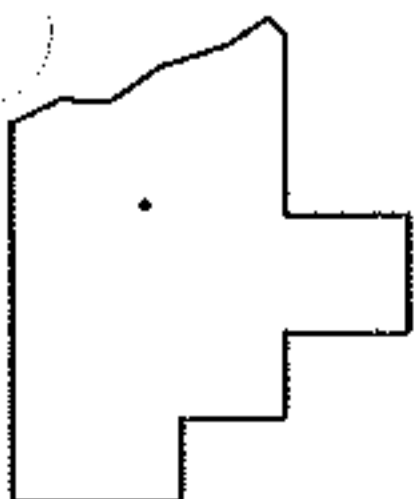

SPLITS/DEEDS PROCESSED

LORAIN COUNTY TAX MAP DEPARTMENT  
226 MIDDLE AVE. ELYRIA, OHIO

SURVEYED BY: N/A

CLOSURE: .00:10,000

MAP PAGE(S): 5-00-038-A

APPROVED BY: RRM DATE: 12-16-13

SCALE: 1" = 50' PRIOR INST.: 20090307308