
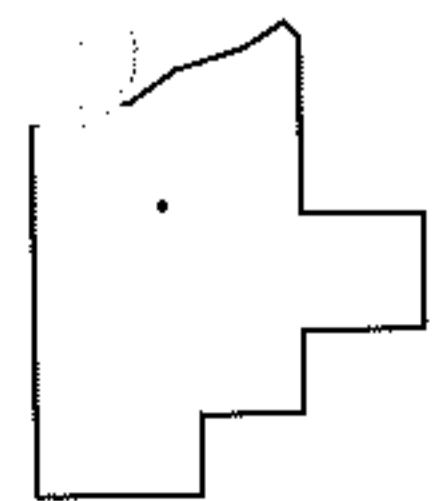
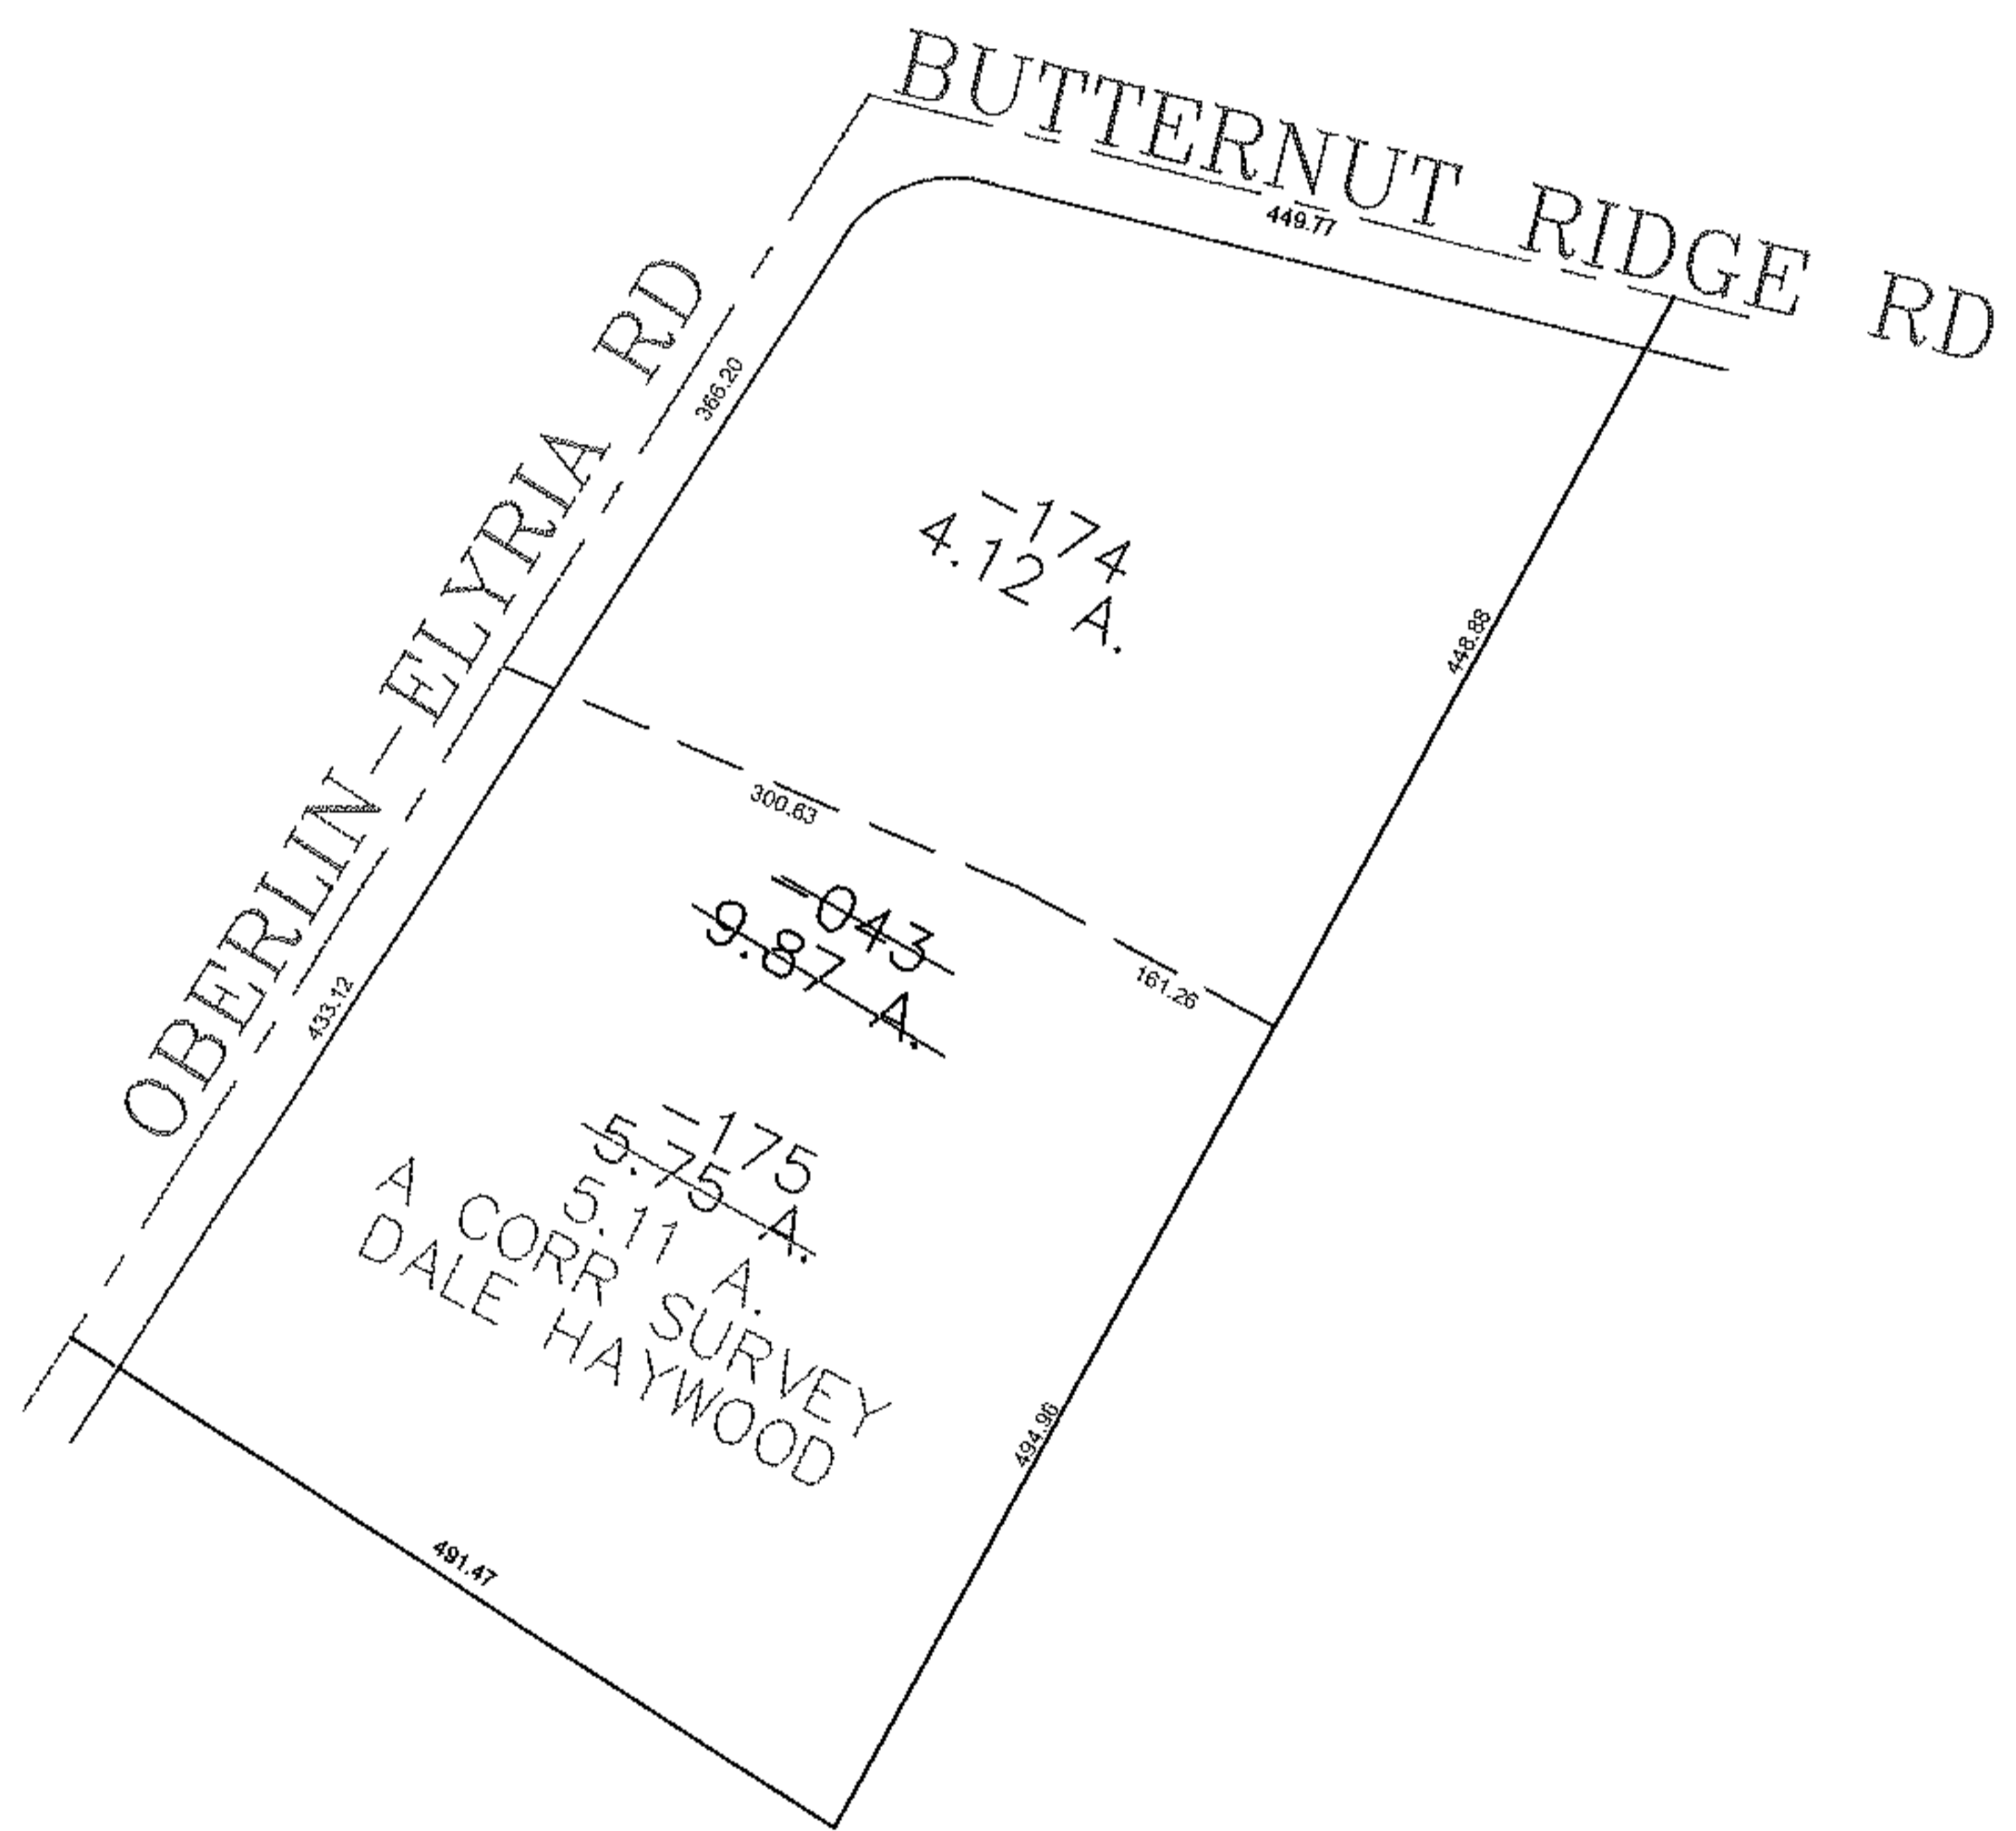


RASTER

PARENT PARCEL: 10-00-012-000-043
CHILD PARCEL: 10-00-012-000-174, & -175
STARTING POINT: CENTERLINE OF BUTTERNUT RIDGE RD & OBERLIN-ELYRIA RD

10-02863

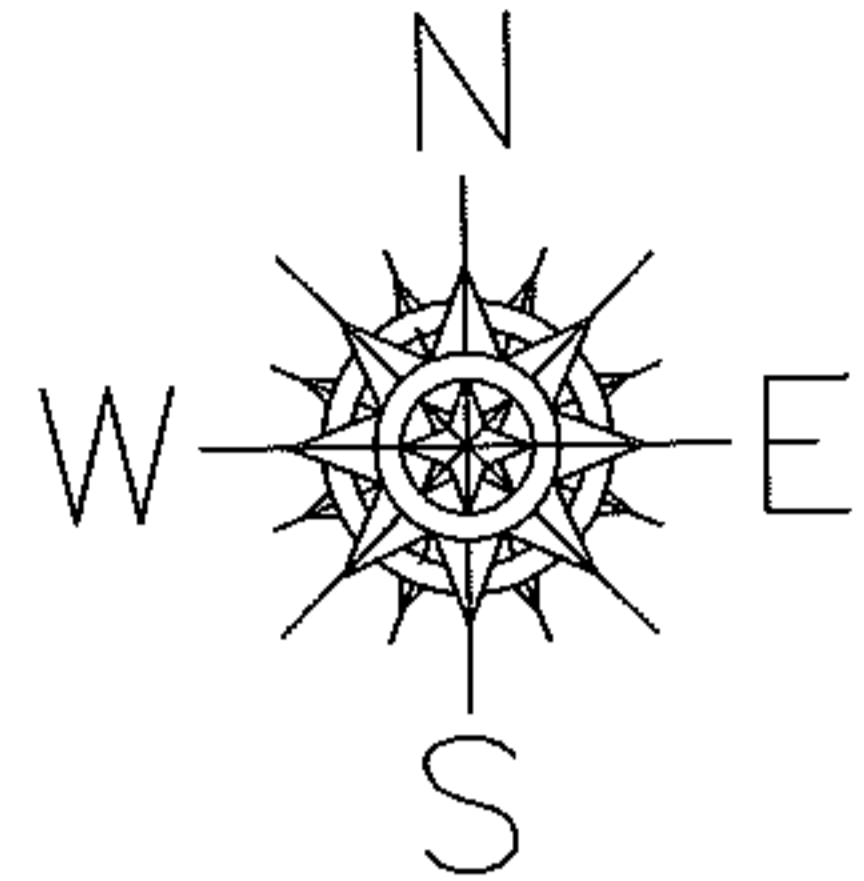

SPLITS/DEEDS PROCESSED

LORAIN COUNTY TAX MAP DEPARTMENT
226 MIDDLE AVE. ELYRIA, OHIO

SURVEYED BY: DALE HAYWOOD
CLOSURE: 0.00 : 10,000
MAP PAGE(S): 10-00-012-E
APPROVED BY: JAH DATE: 10-14-2010
SCALE: 1" = 200 PRIOR INST.: 20050095761