
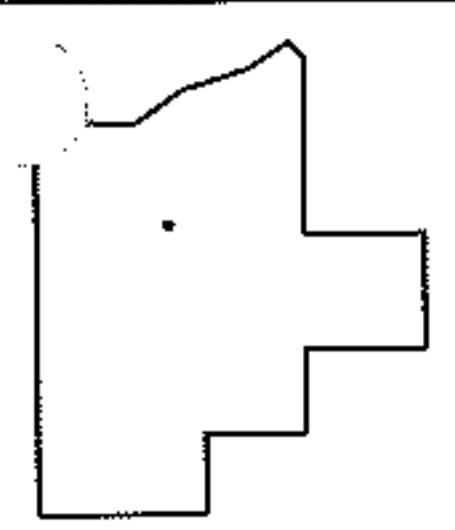
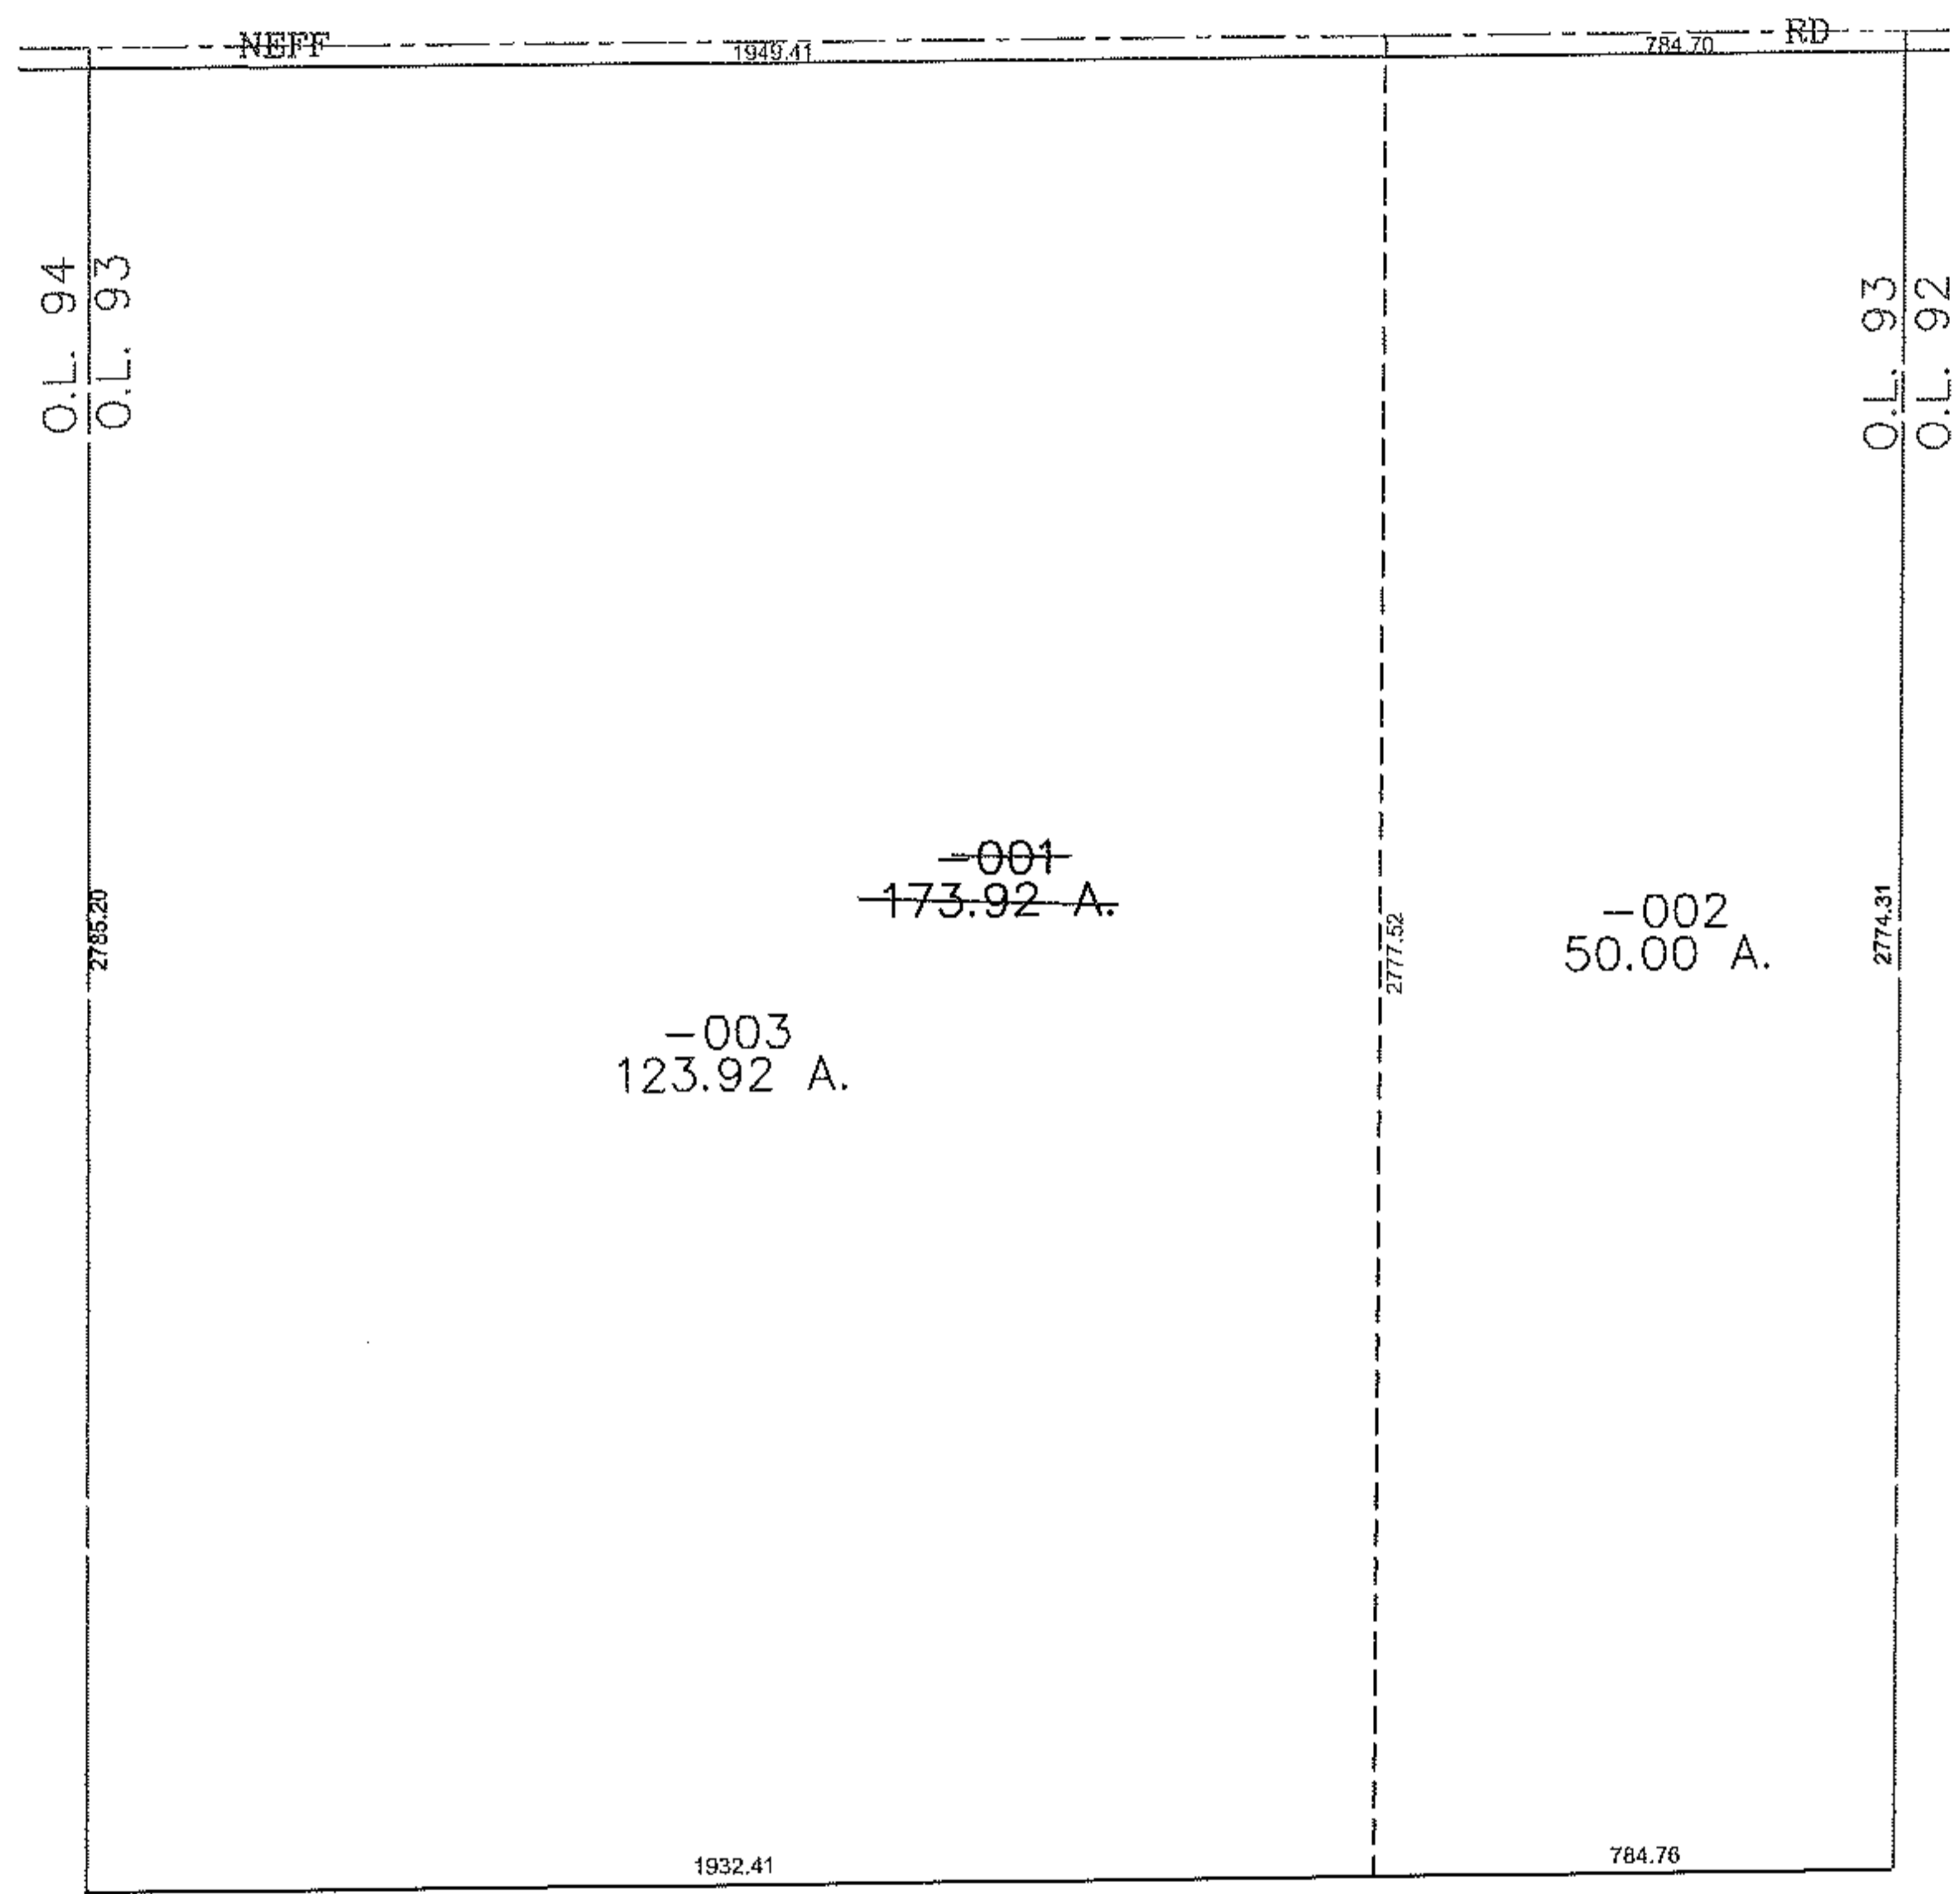


PARENT PARCEL: 16-00-093-000-001  
CHILD PARCEL: 16-00-093-000-002, -003  
STARTING POINT: CENTERLINE OF NEFF RD & O.L. 93

10-02865

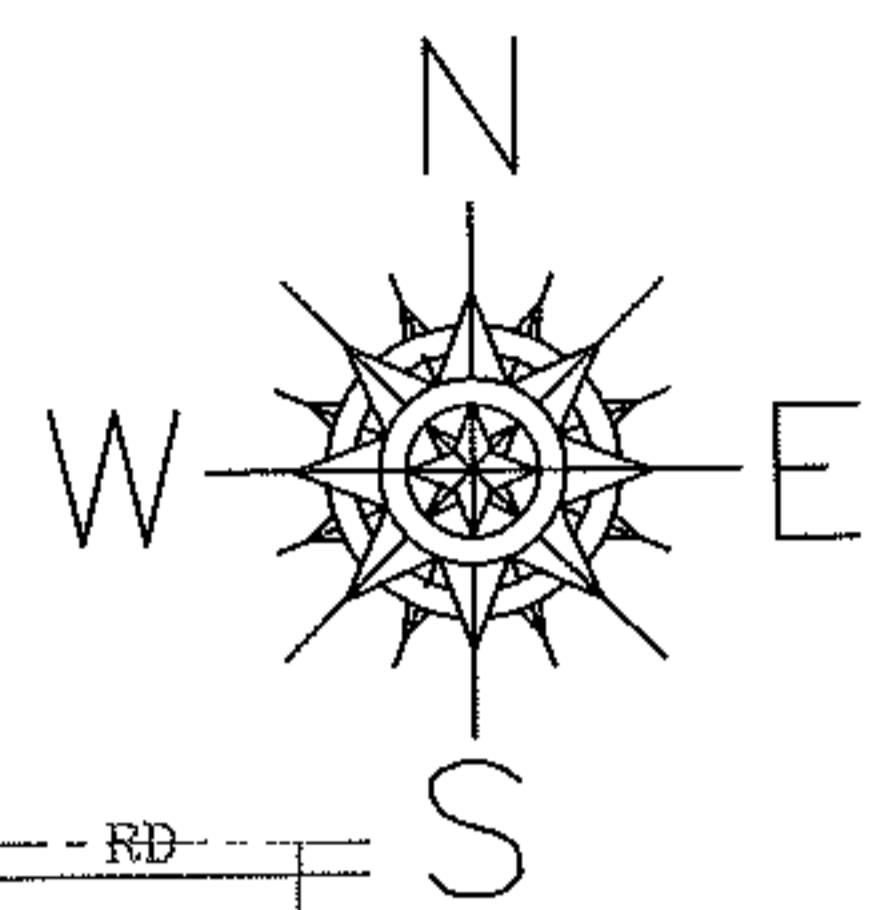

**SPLITS/DEEDS PROCESSED**  
LORAIN COUNTY TAX MAP DEPARTMENT  
226 MIDDLE AVE. ELYRIA, OHIO

SURVEYED BY: MICHAEL BRAMHALL  
CLOSURE: 0.00 : 10,000  
MAP PAGE(S): 16-H  
APPROVED BY: JAH DATE: 10-19-2010  
SCALE: 1"= 500 PRIOR INST.: 20100341627