


PARENT PARCEL: 16-00-020-000-054

CHILD PARCEL: XX-XX-XXX-XXX-XXX

STARTING POINT: I.P. MON. BOX, CL OF CHAMBERLAIN RD. & CL OF CROOK ST.

13-02866-C

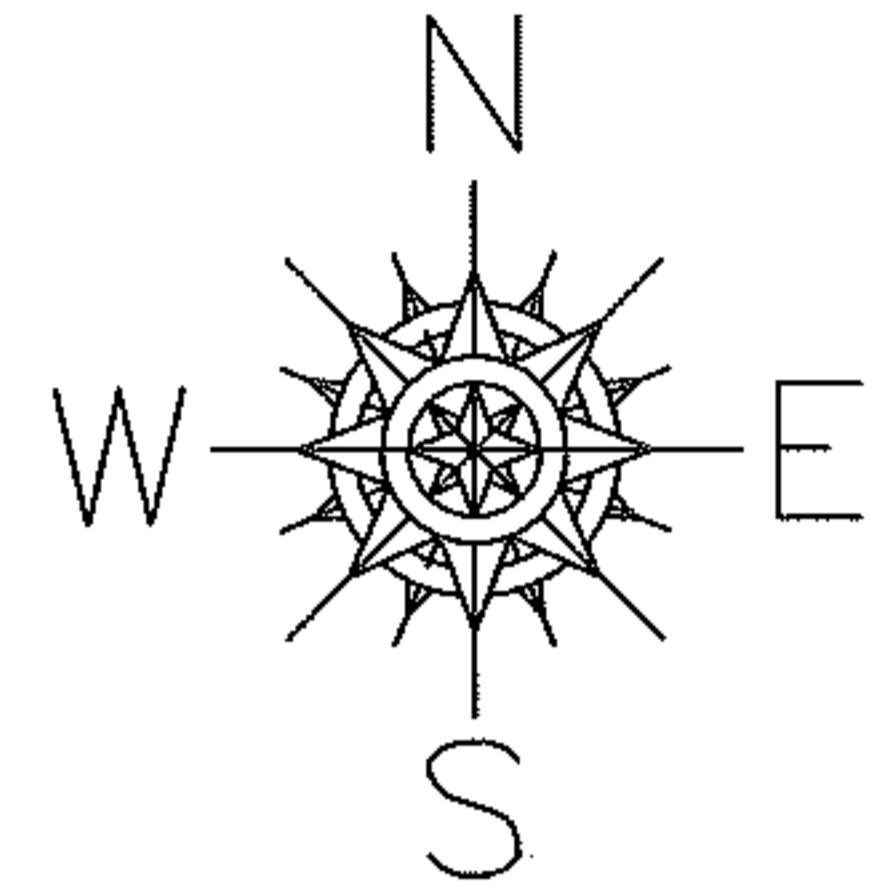



ACREAGE CORRECTION

16-00-020-000-054

~~8.07~~ A.

7.81 A.

CORR. PER SURV.
THOMAS SNEZEK

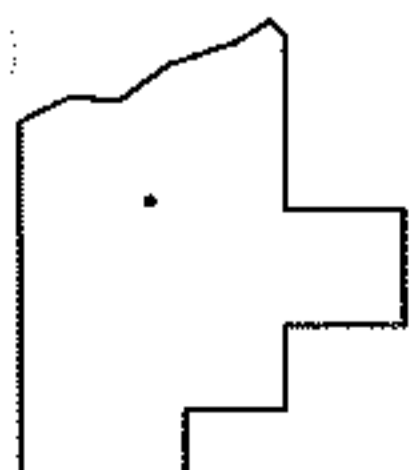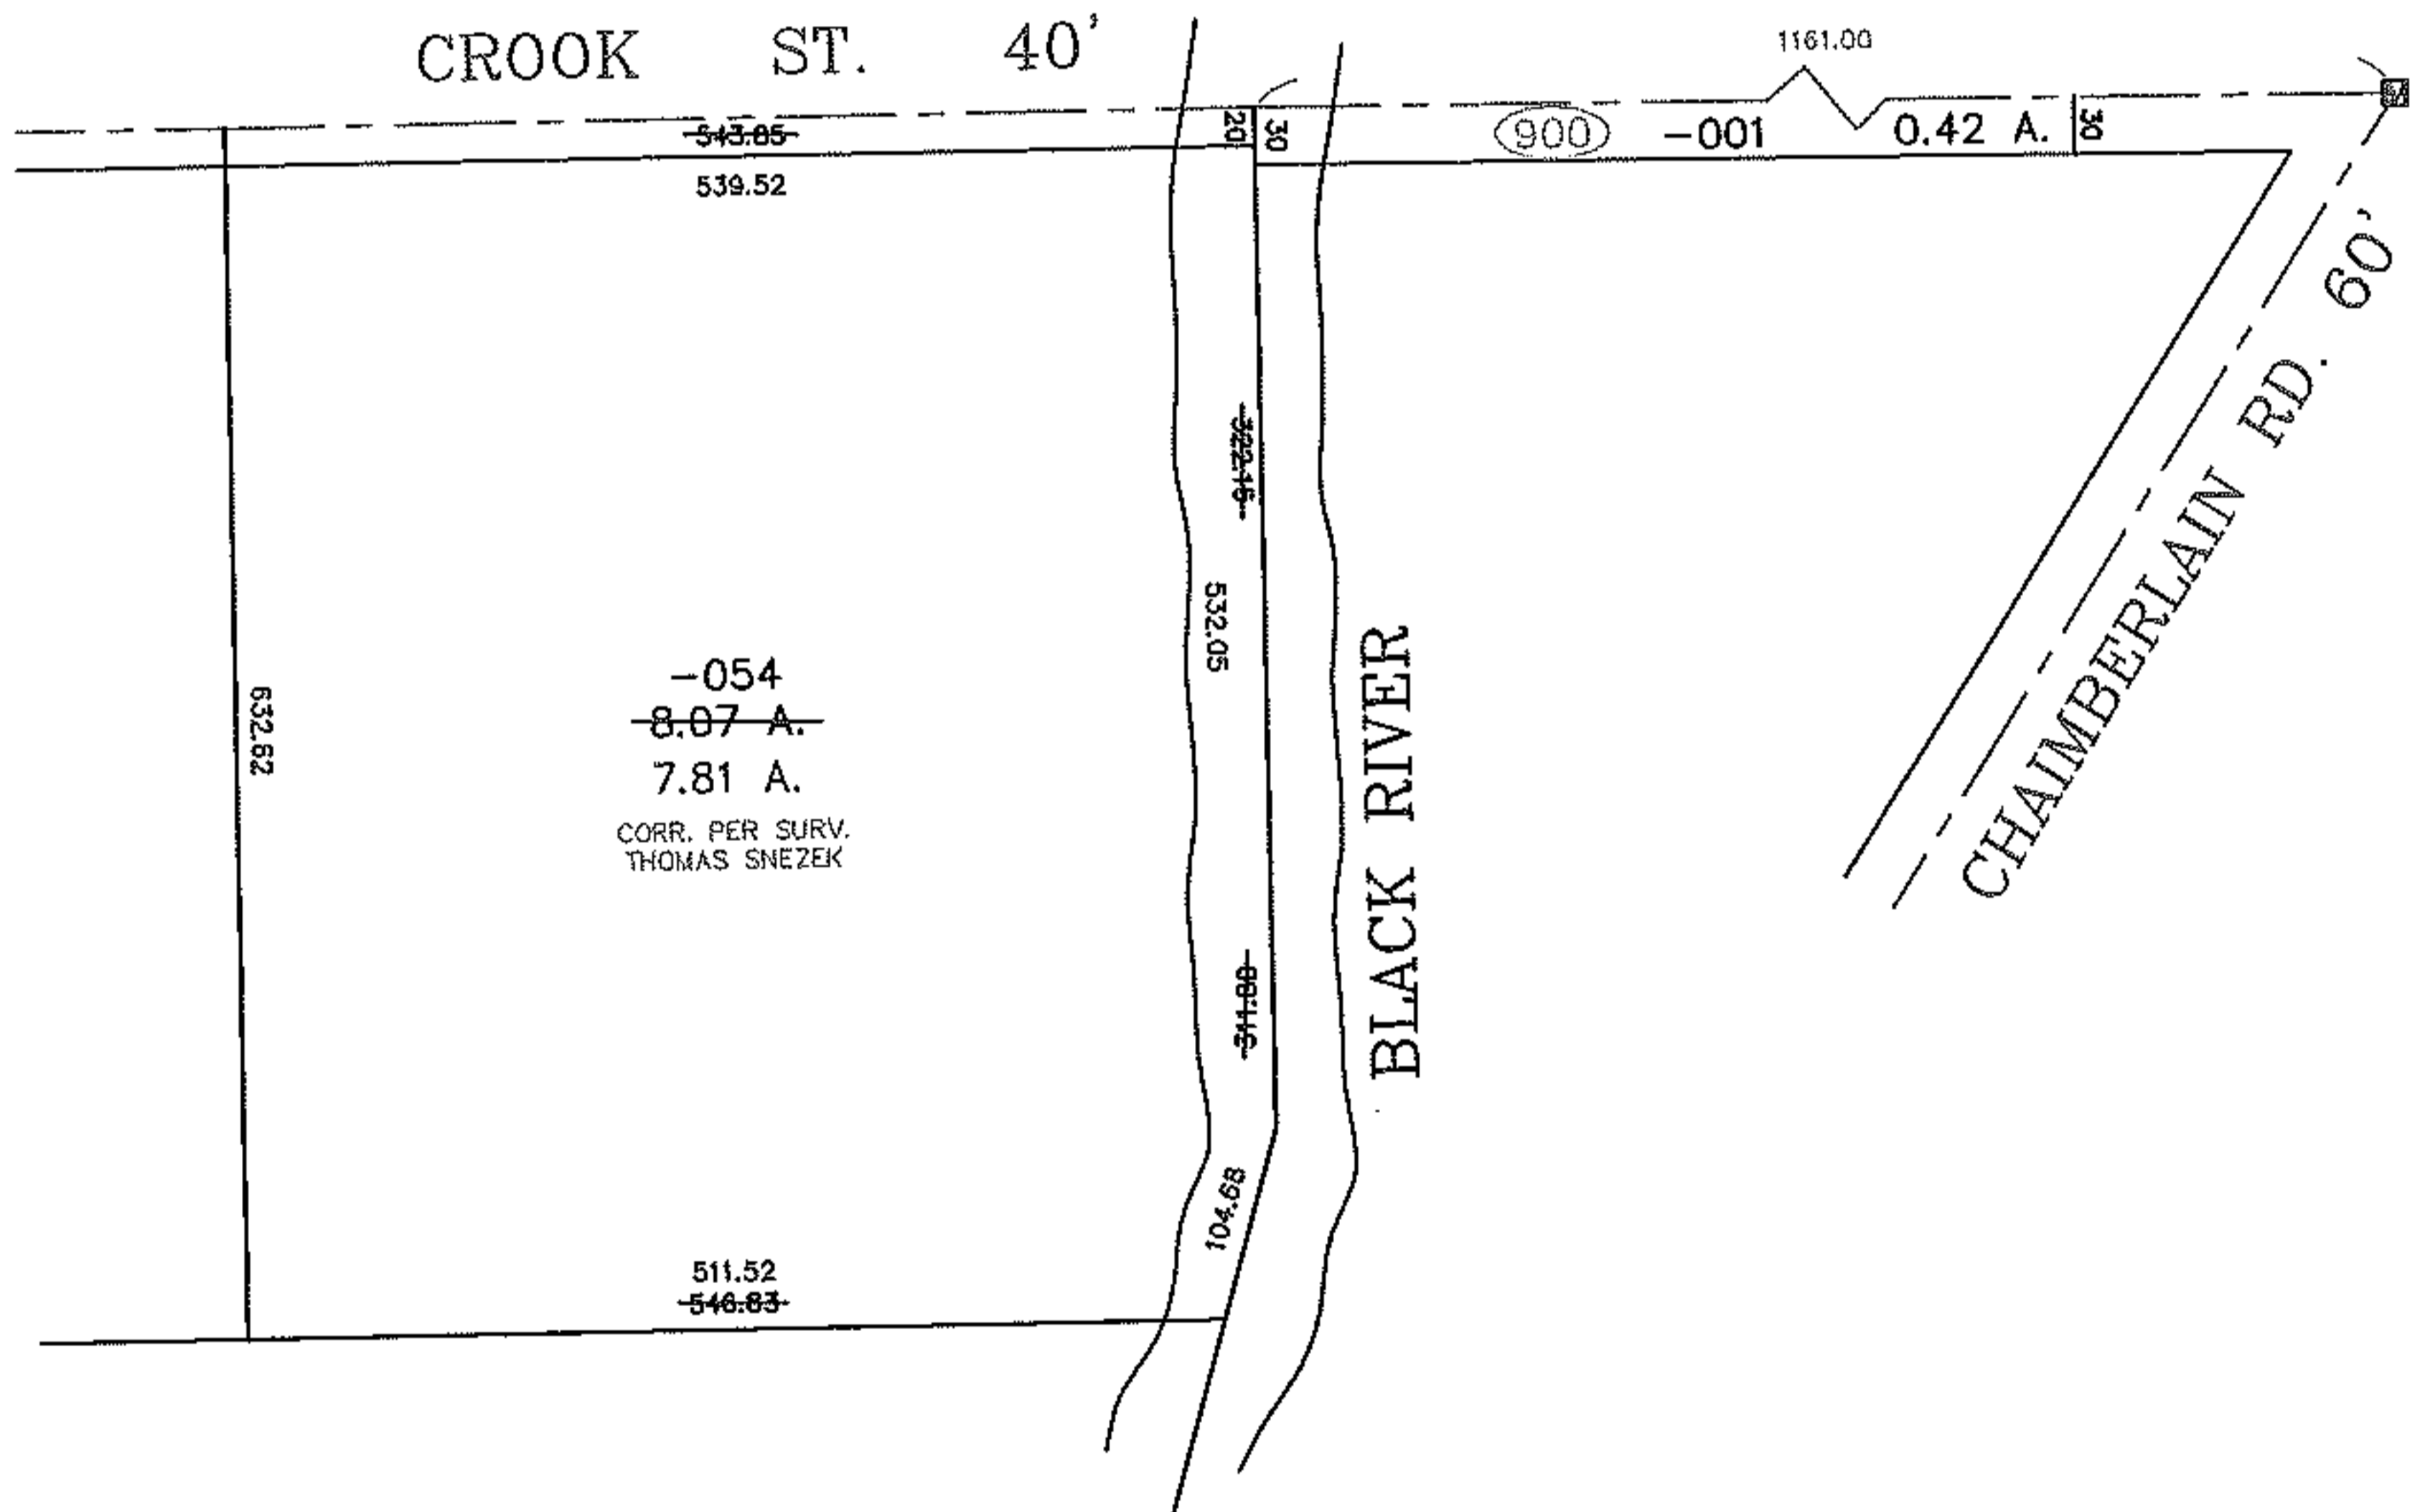

SPLITS/DEEDS PROCESSED
LORAIN COUNTY TAX MAP DEPARTMENT
226 MIDDLE AVE. ELYRIA, OHIO

SURVEYED BY: THOMAS SNEZEK
CLOSURE: 0.01 : 10,000
MAP PAGE(S): 16-A
APPROVED BY: TJS DATE: 12/20/13
SCALE: 1" = 200 PRIOR INSTRUMENT: 20010781020