
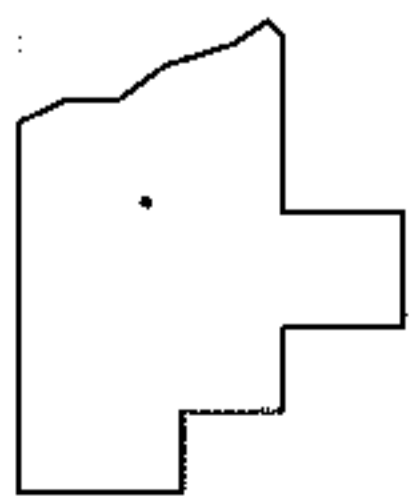
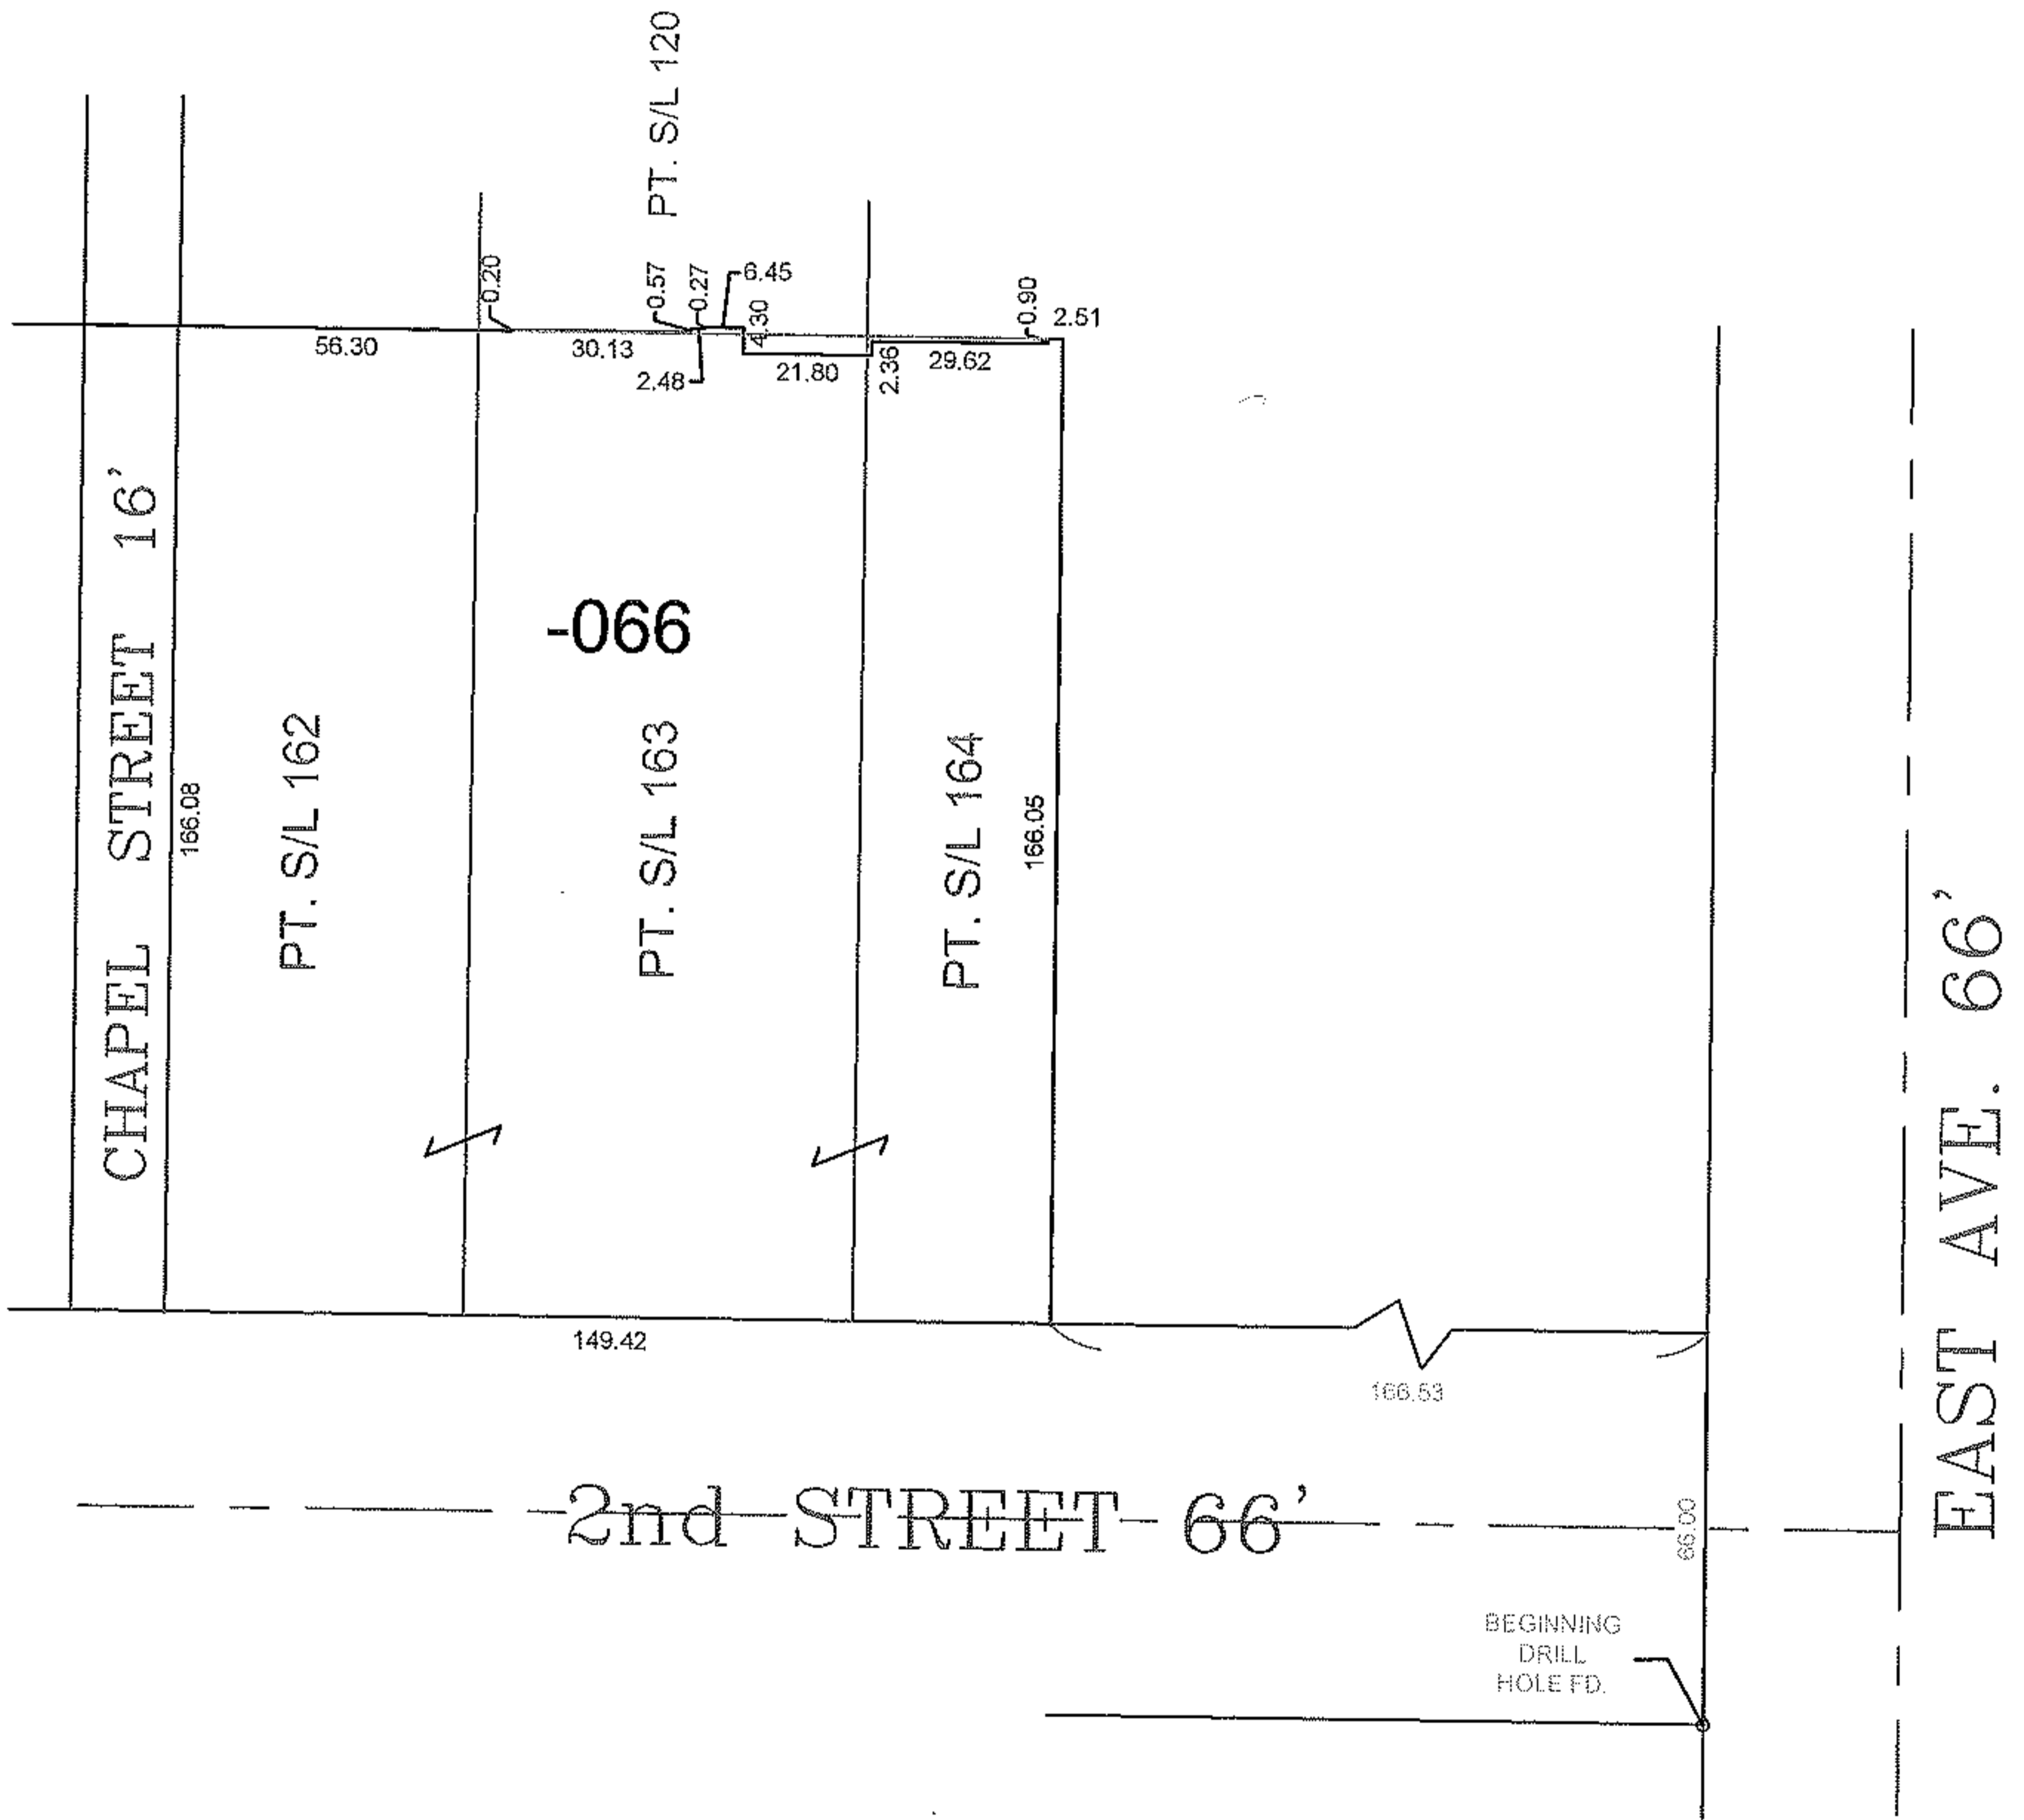


PARENT PARCEL: 06-26-063-000-066
 CHILD PARCEL: XX-XX-XXX-XXX-XXX
 STARTING POINT: DRILL HOLE FD., INT. OF SOUTH R.O.W. OF 2ND ST. &
WEST R.O.W. OF EAST AVE.

13-02867-C

FRONTAGE & DEPTH CORR.

06-26-063-000-066
~~149.45 X 166.05~~
 149.42 X 166.08

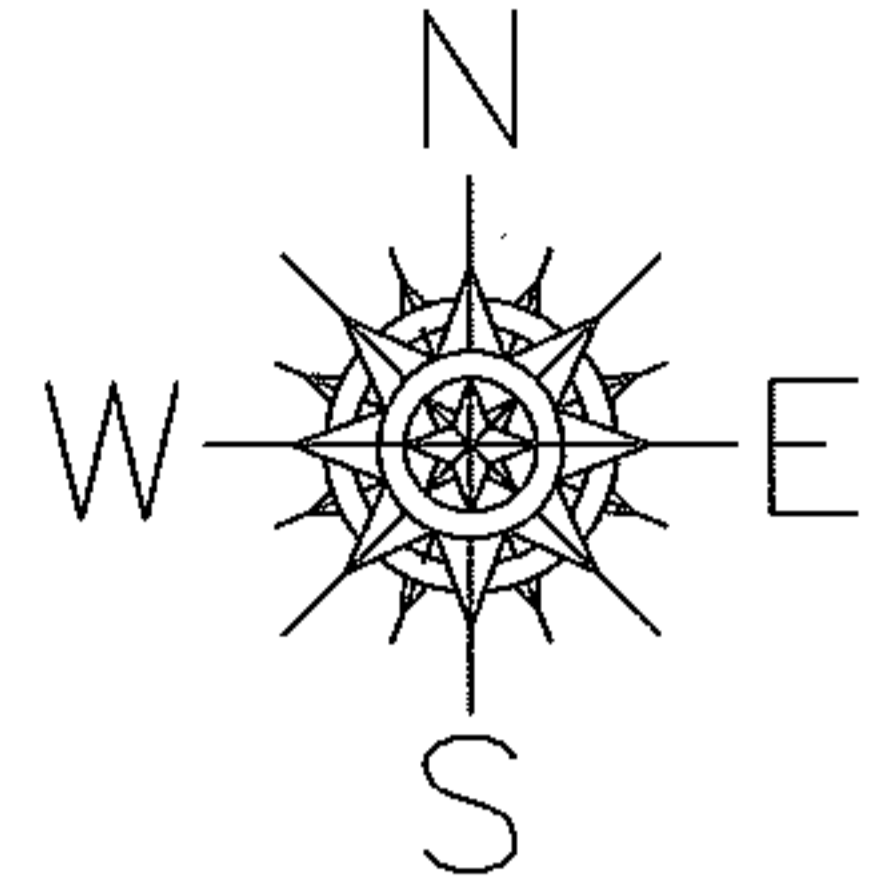

SPLITS/DEEDS PROCESSED
 LORAIN COUNTY TAX MAP DEPARTMENT
 226 MIDDLE AVE. ELYRIA, OHIO

SURVEYED BY: TREVOR BIXLER
 CLOSURE: 0.01 : 10,000
 MAP PAGE(S): 6-120
 APPROVED BY: TJS DATE: 12/27/13
 SCALE: 1" = 50' PRIOR INST.: 20120442403