
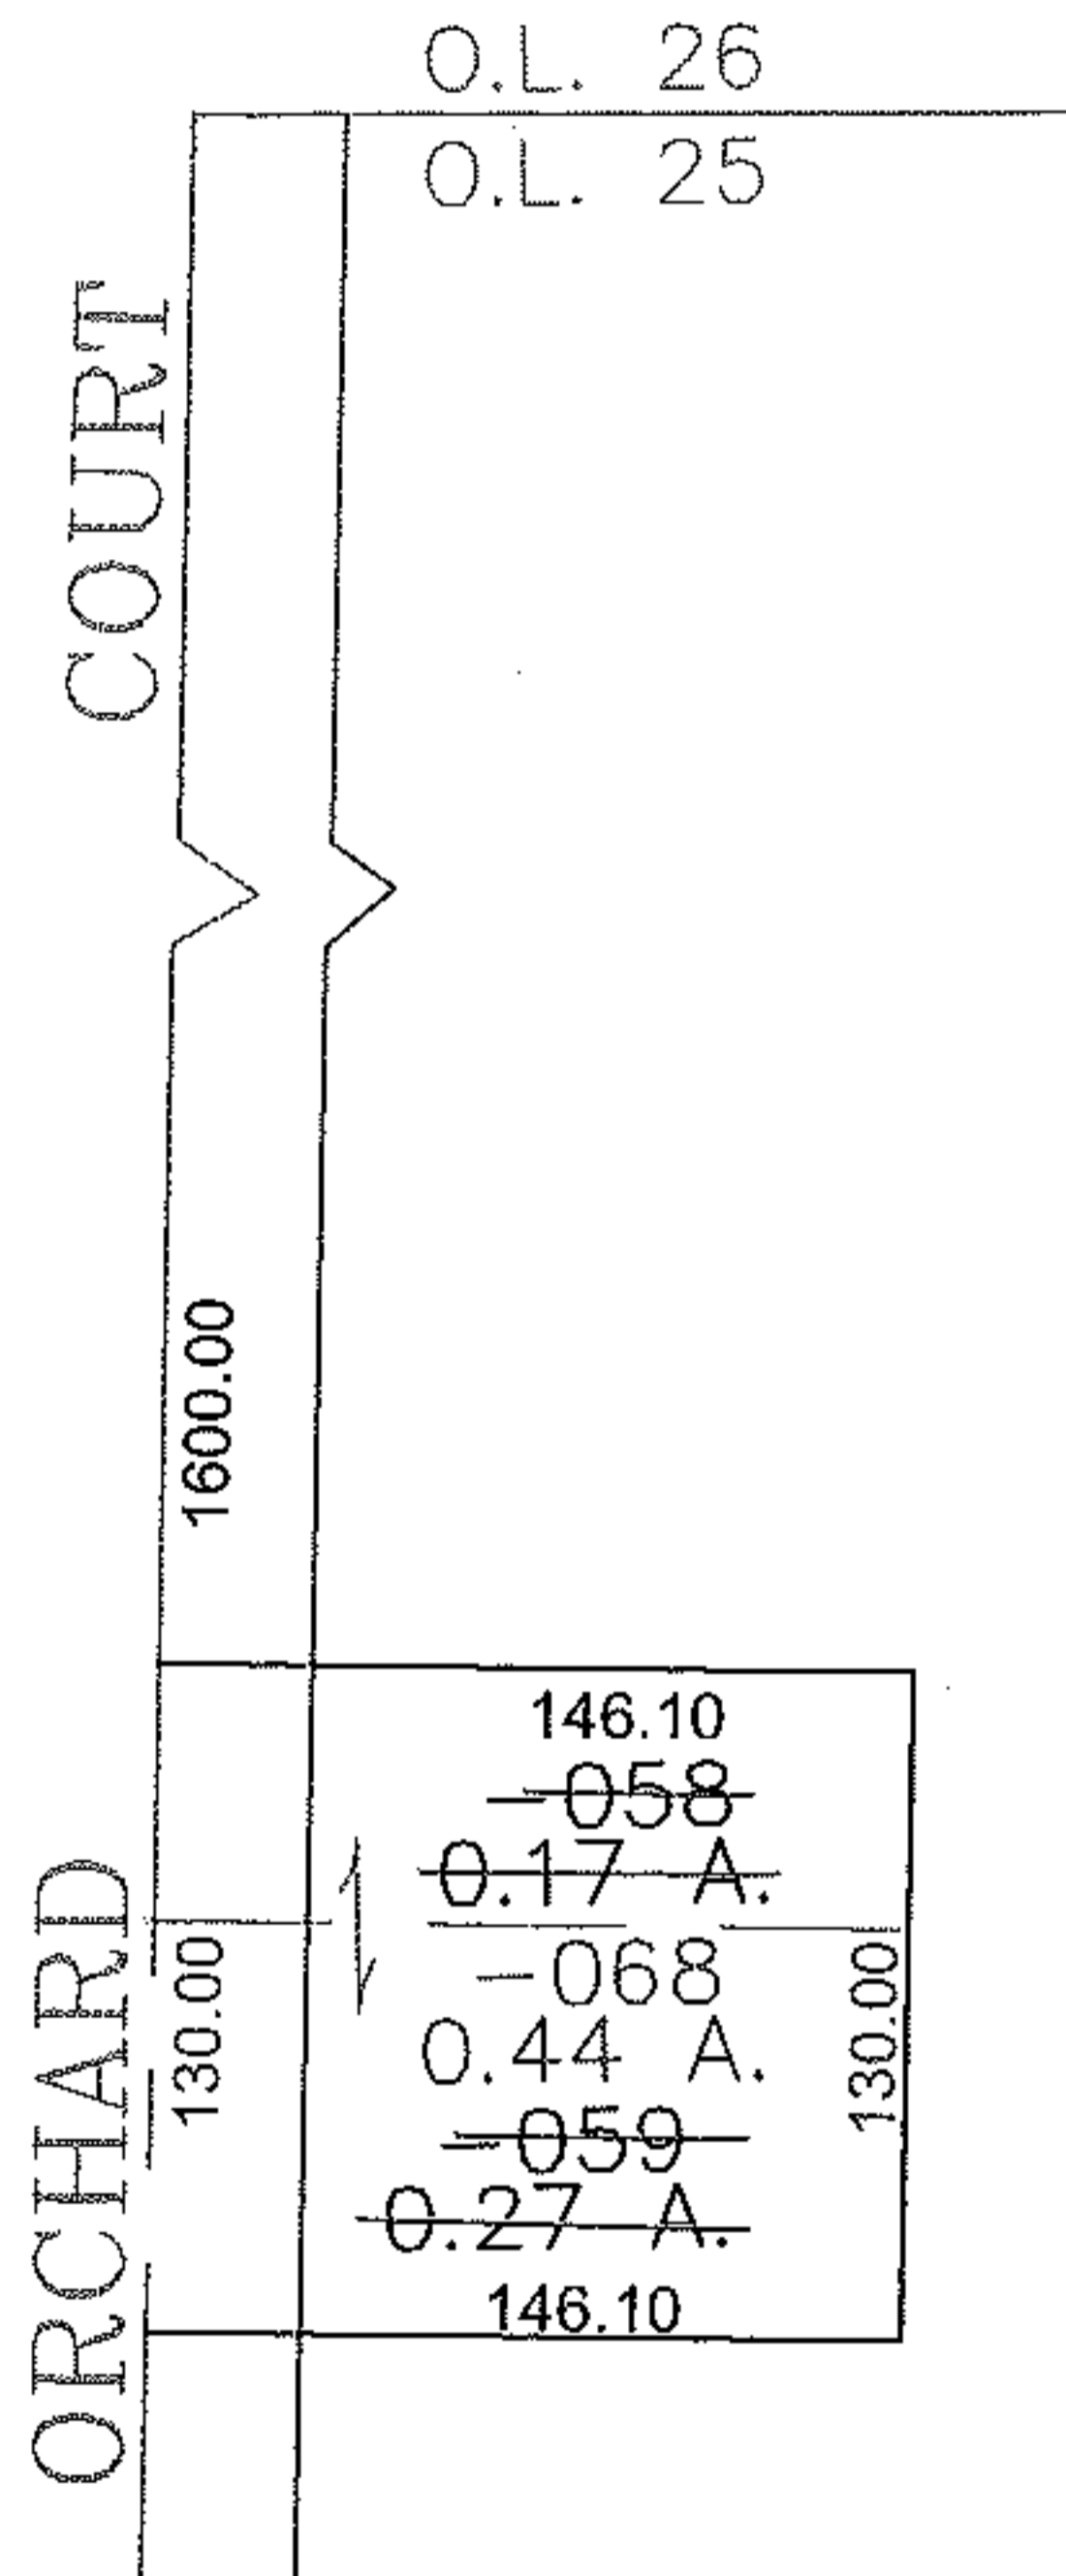


PARENT PARCEL: 03-00-025-000-058, -059

CHILD PARCEL: 03-00-025-000-068

STARTING POINT: CENTERLINE OF ORCHARD COURT & O.L. 25

10-02868

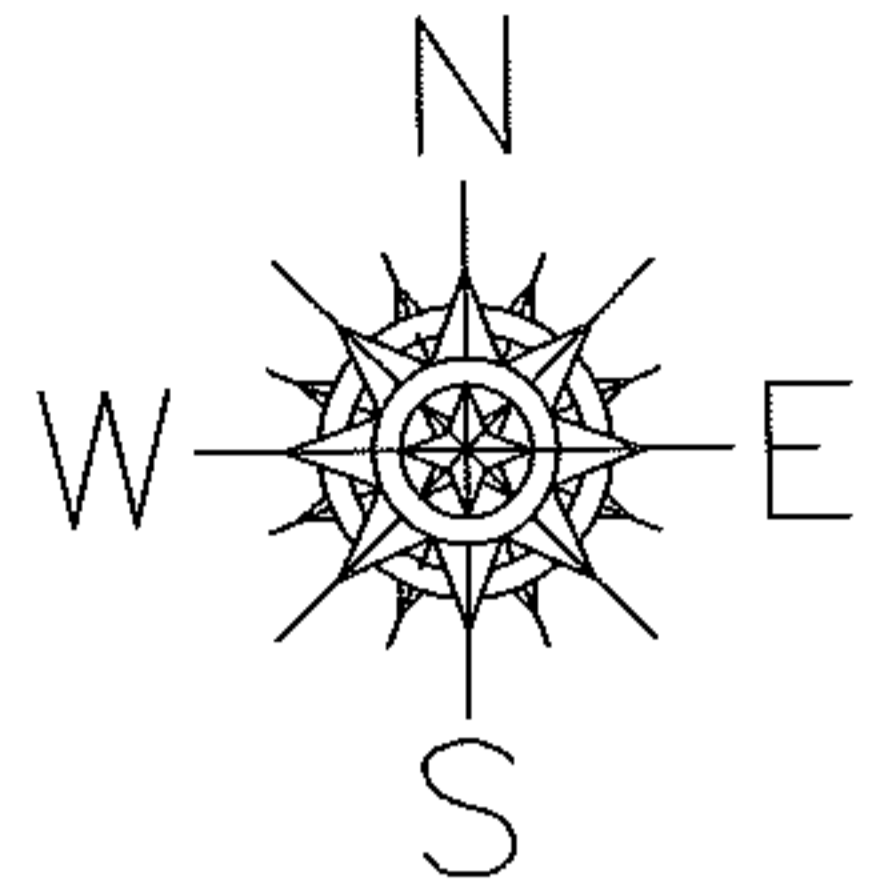

SPLITS/DEEDS PROCESSED

LORAIN COUNTY TAX MAP DEPARTMENT
226 MIDDLE AVE. ELYRIA, OHIO

SURVEYED BY: TREVOR BIXLER

CLOSURE: 0.00 : 10.000

MAP PAGE(S): 03-00-025-A

APPROVED BY: JAH DATE: 10-26-2010

SCALE: 1"=100 PRIOR INSTRUMENT: 20050063591