
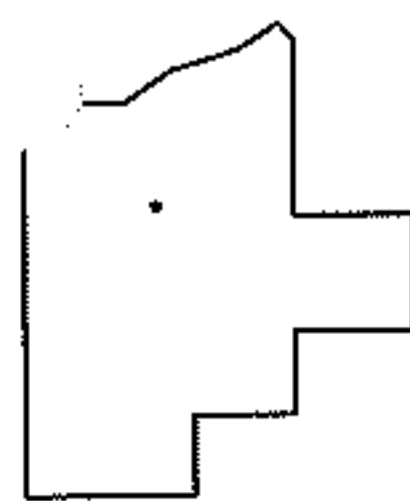
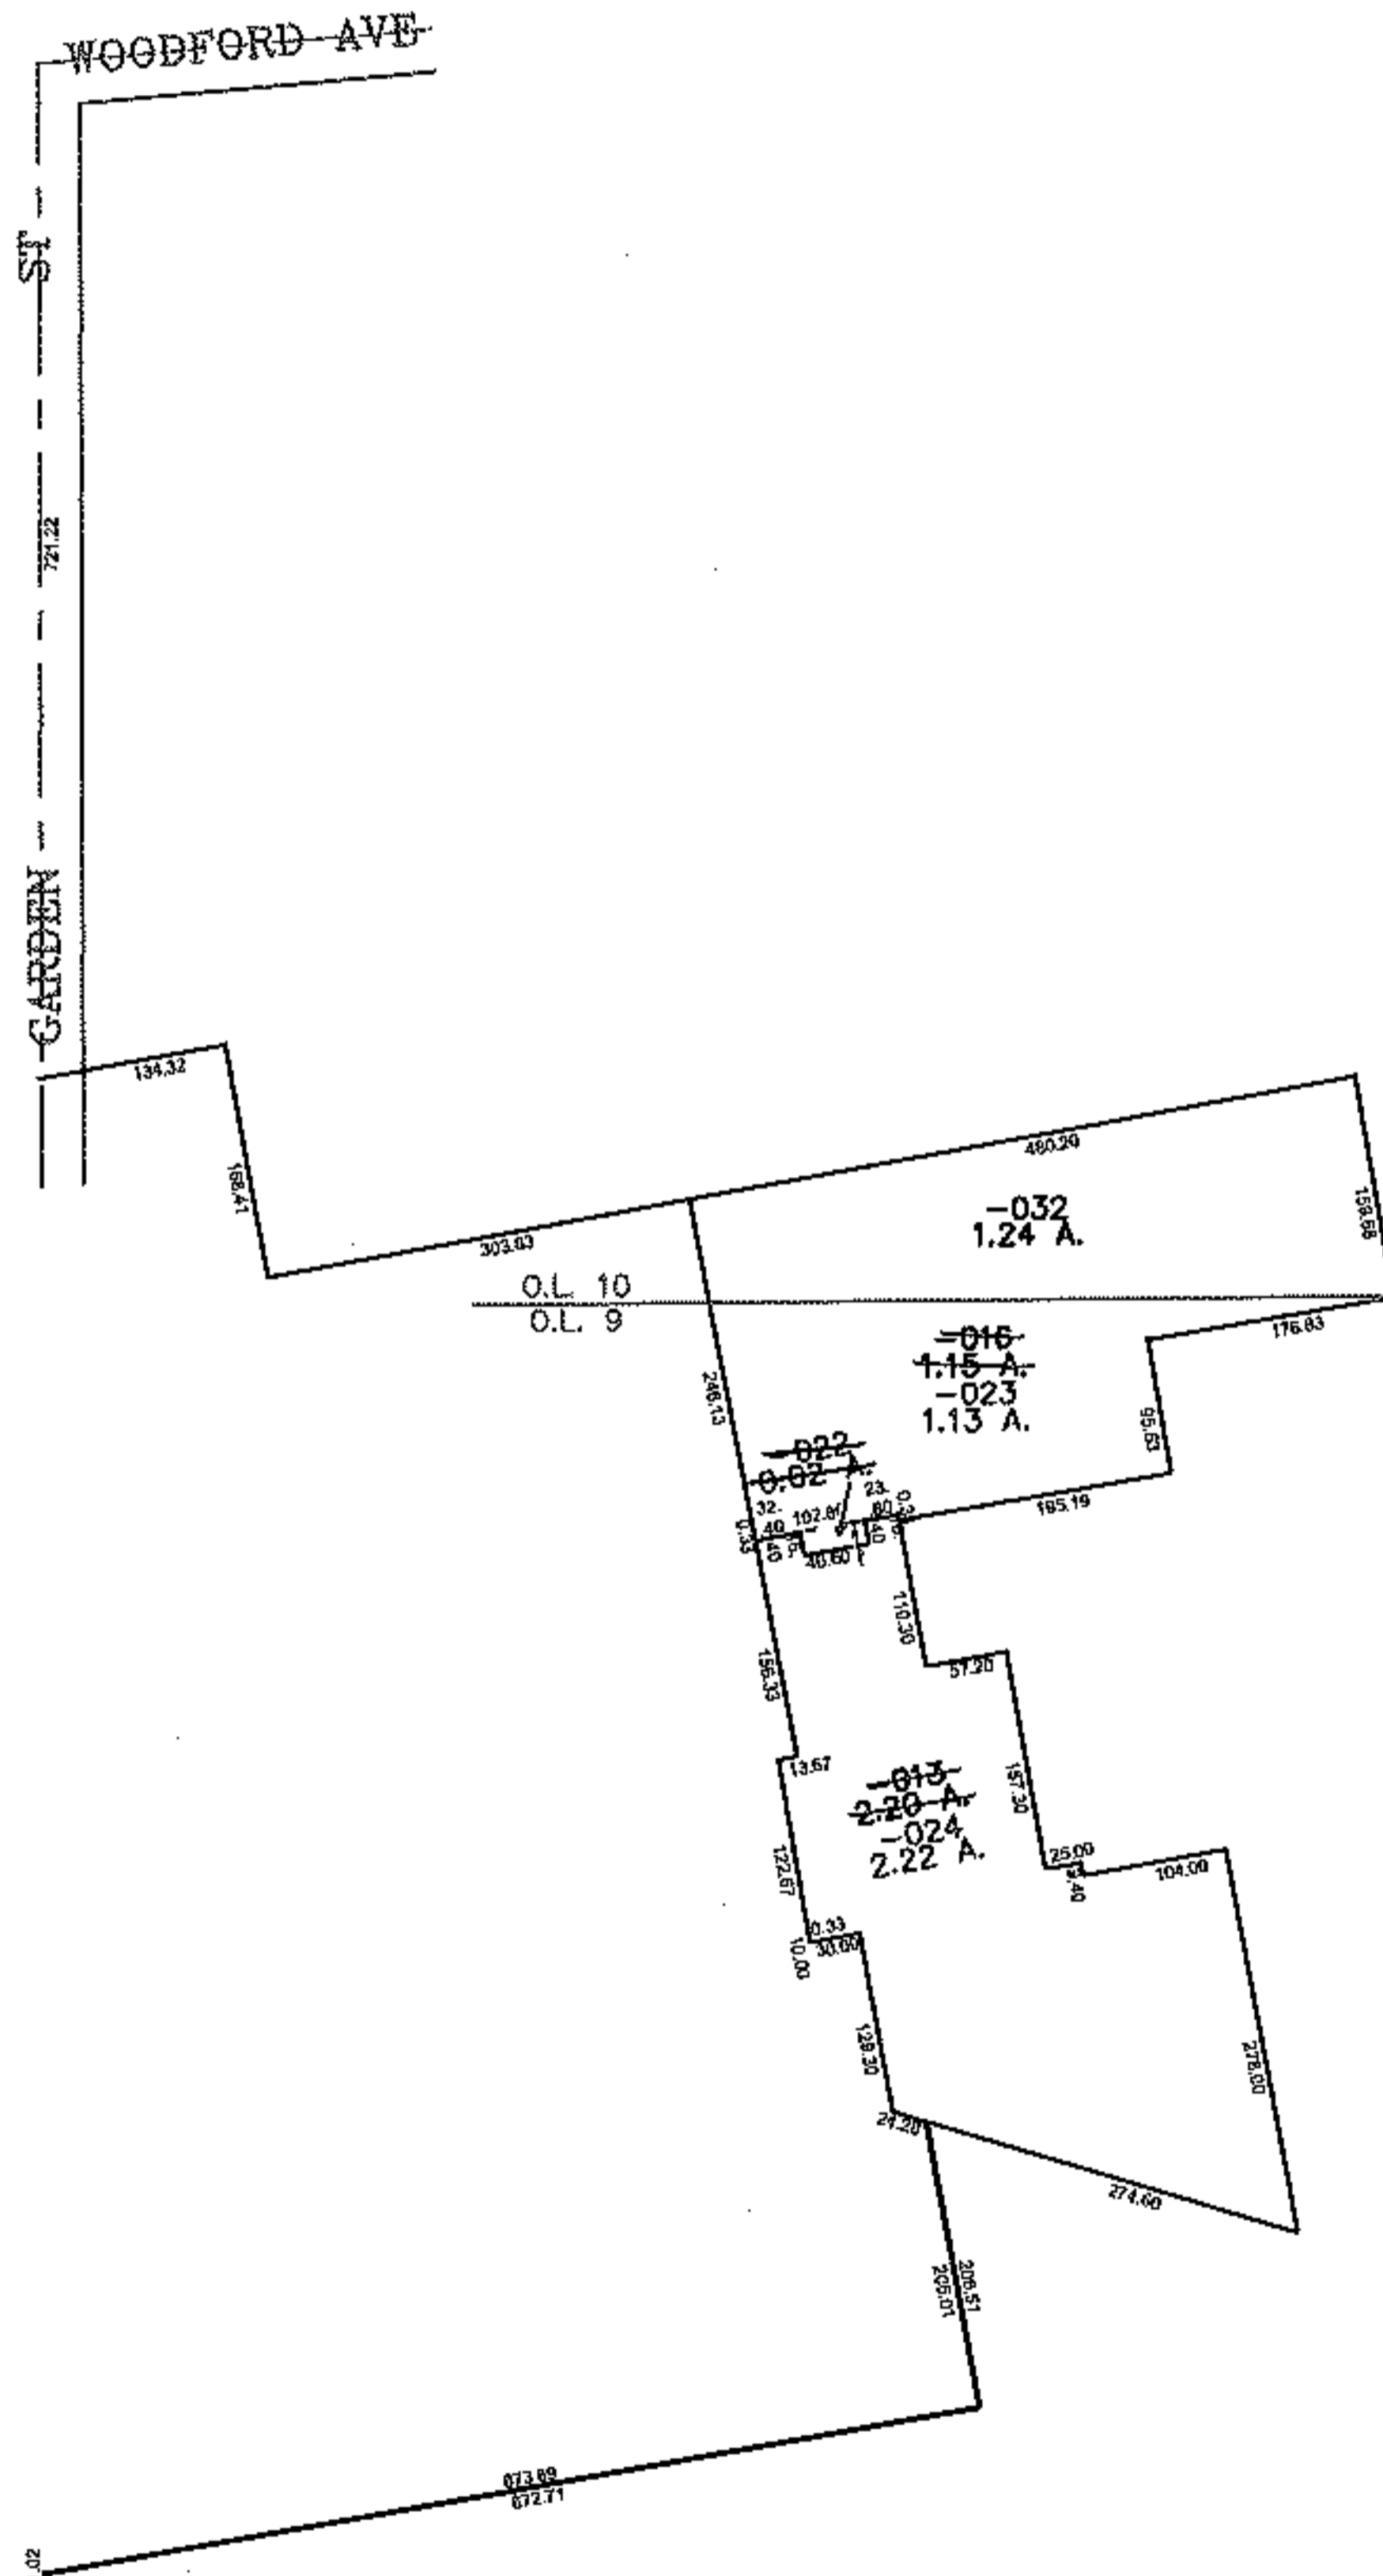


PARENT PARCEL: 06-24-009-102-016, -013

CHILD PARCEL: 06-24-009-102-022 THRU -024

STARTING POINT: CENTERLINE OF WOODFORD AVE & GARDEN ST

10-02870

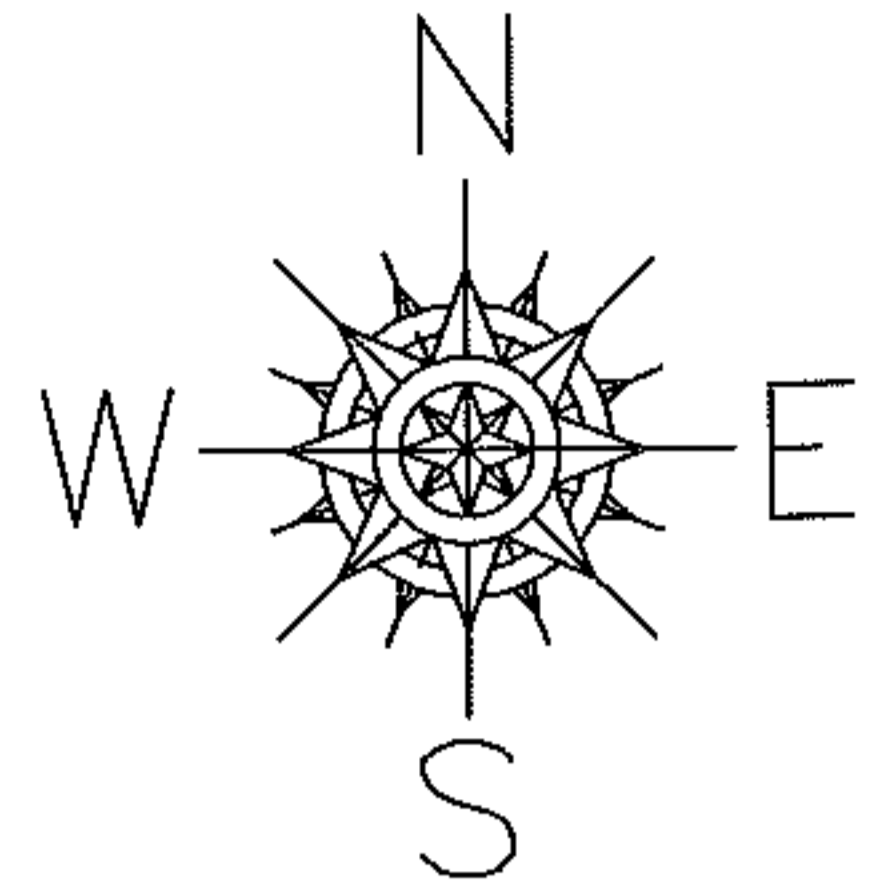

SPLITS/DEEDS PROCESSED
LORAIN COUNTY TAX MAP DEPARTMENT
226 MIDDLE AVE. ELYRIA, OHIO

SURVEYED BY: TREVOR BIXLER
CLOSURE: 0.00 : 10.000
MAP PAGE(S): 6-134
APPROVED BY: JAH DATE: 11-1-2010
SCALE: 1" = 300 PRIOR INSTRUMENT: 20070190279