

PARENT PARCEL: 12-00-096-630-001

CHILD PARCEL: 12-00-097-630-001

STARTING POINT: XXXXXX



14-02878-A

DROP FROM DUPLICATE

~~12-00-096-630-001~~
~~10 X 10~~

ADD TO DUPLICATE

12-00-097-630-001
10 X 10
GAS WELL
API# 34093211540

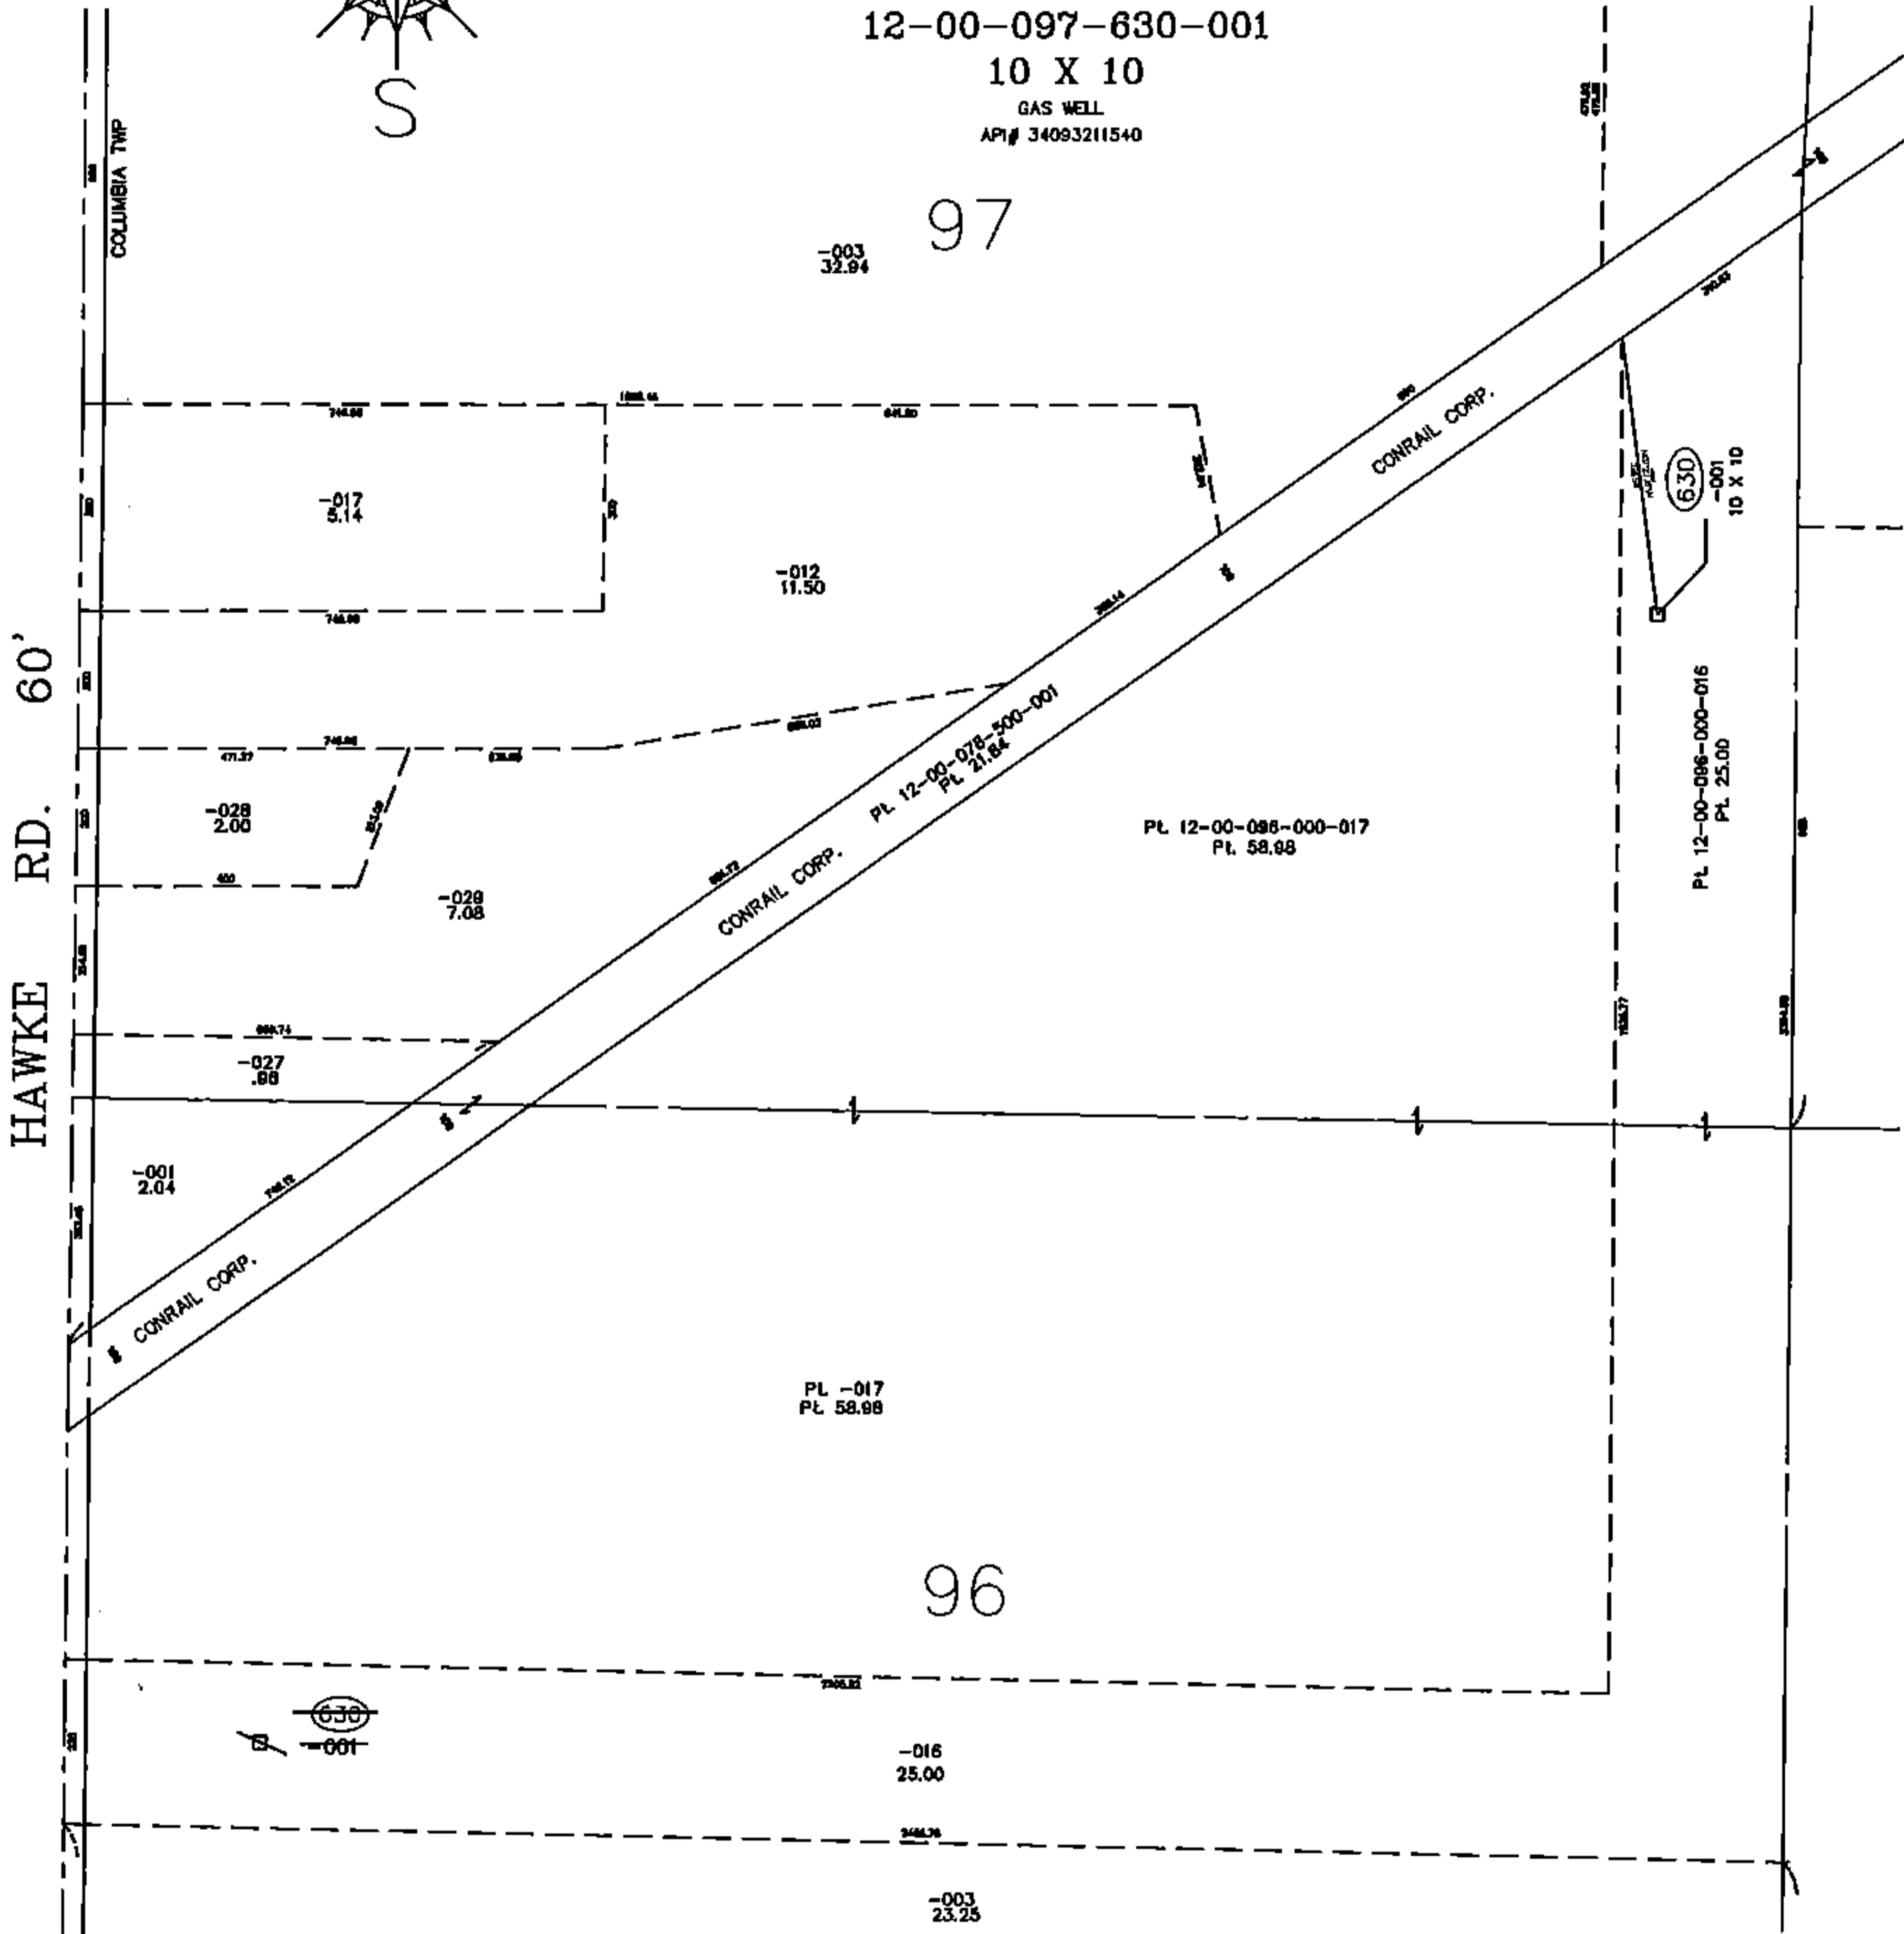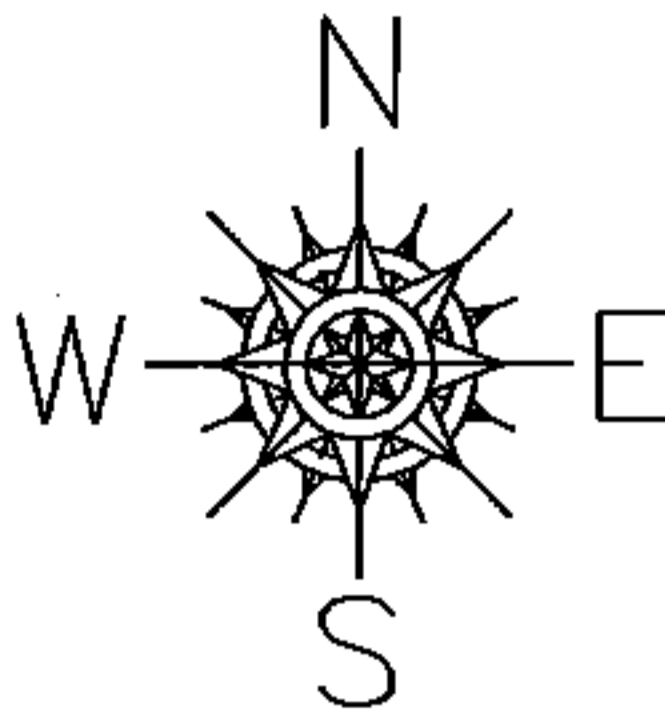

SPLITS/DEEDS PROCESSED

LORAIN COUNTY TAX MAP DEPARTMENT
226 MIDDLE AVE. ELYRIA, OHIO

SURVEYED BY:	NA
CLOSURE:	NA
MAP PAGE(S):	12-00-097
APPROVED BY:	TJS
DATE:	2/3/14
SCALE:	1" = 400
PRIOR INST.:	DV XXXX/XXX