


PARENT PARCEL: 04-00-016-101-024, -025, -073

CHILD PARCEL: 04-00-016-101-204, -205



STARTING POINT: AT A MON BOX AT THE INTERSECTION OF C/L OF S.R. 83 AND C/L OF MAIN ST.

10-02878

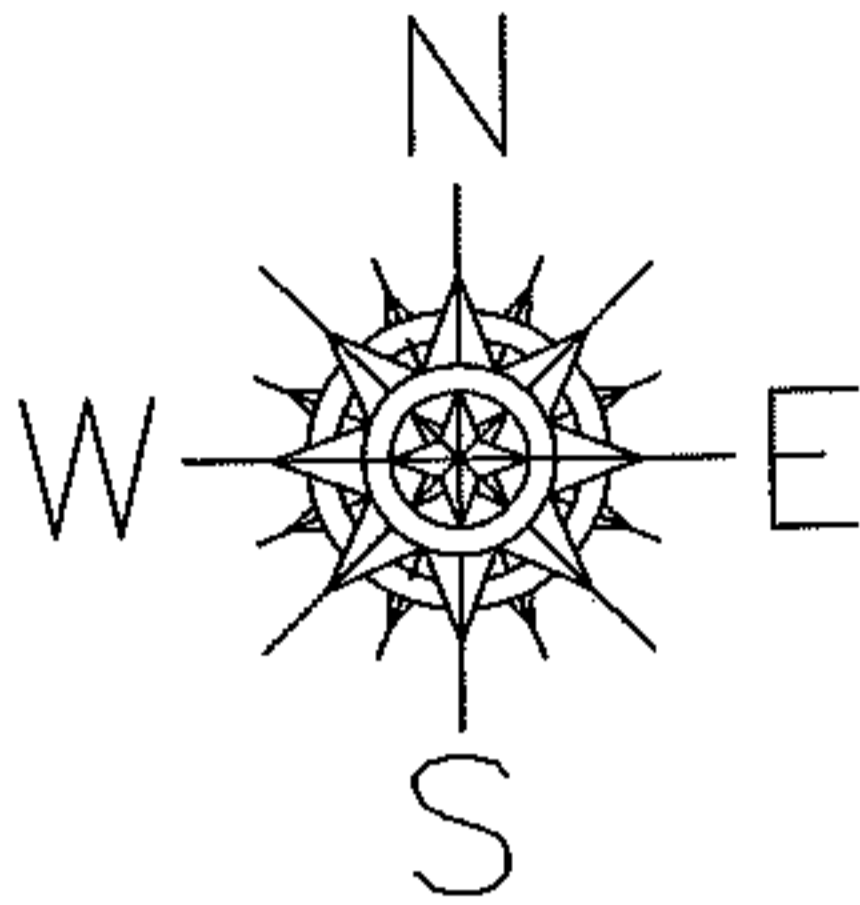

MAIN ST.

MAIN STREET SUB.  
VOL.92 PGS.1-3

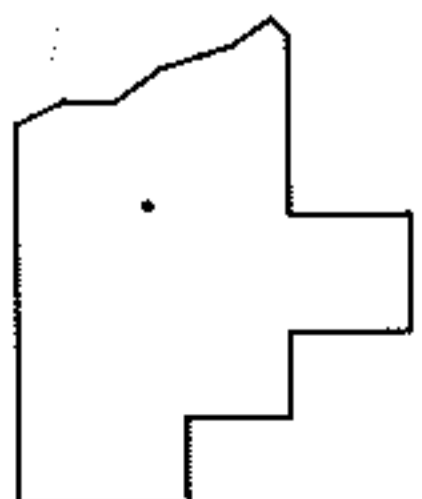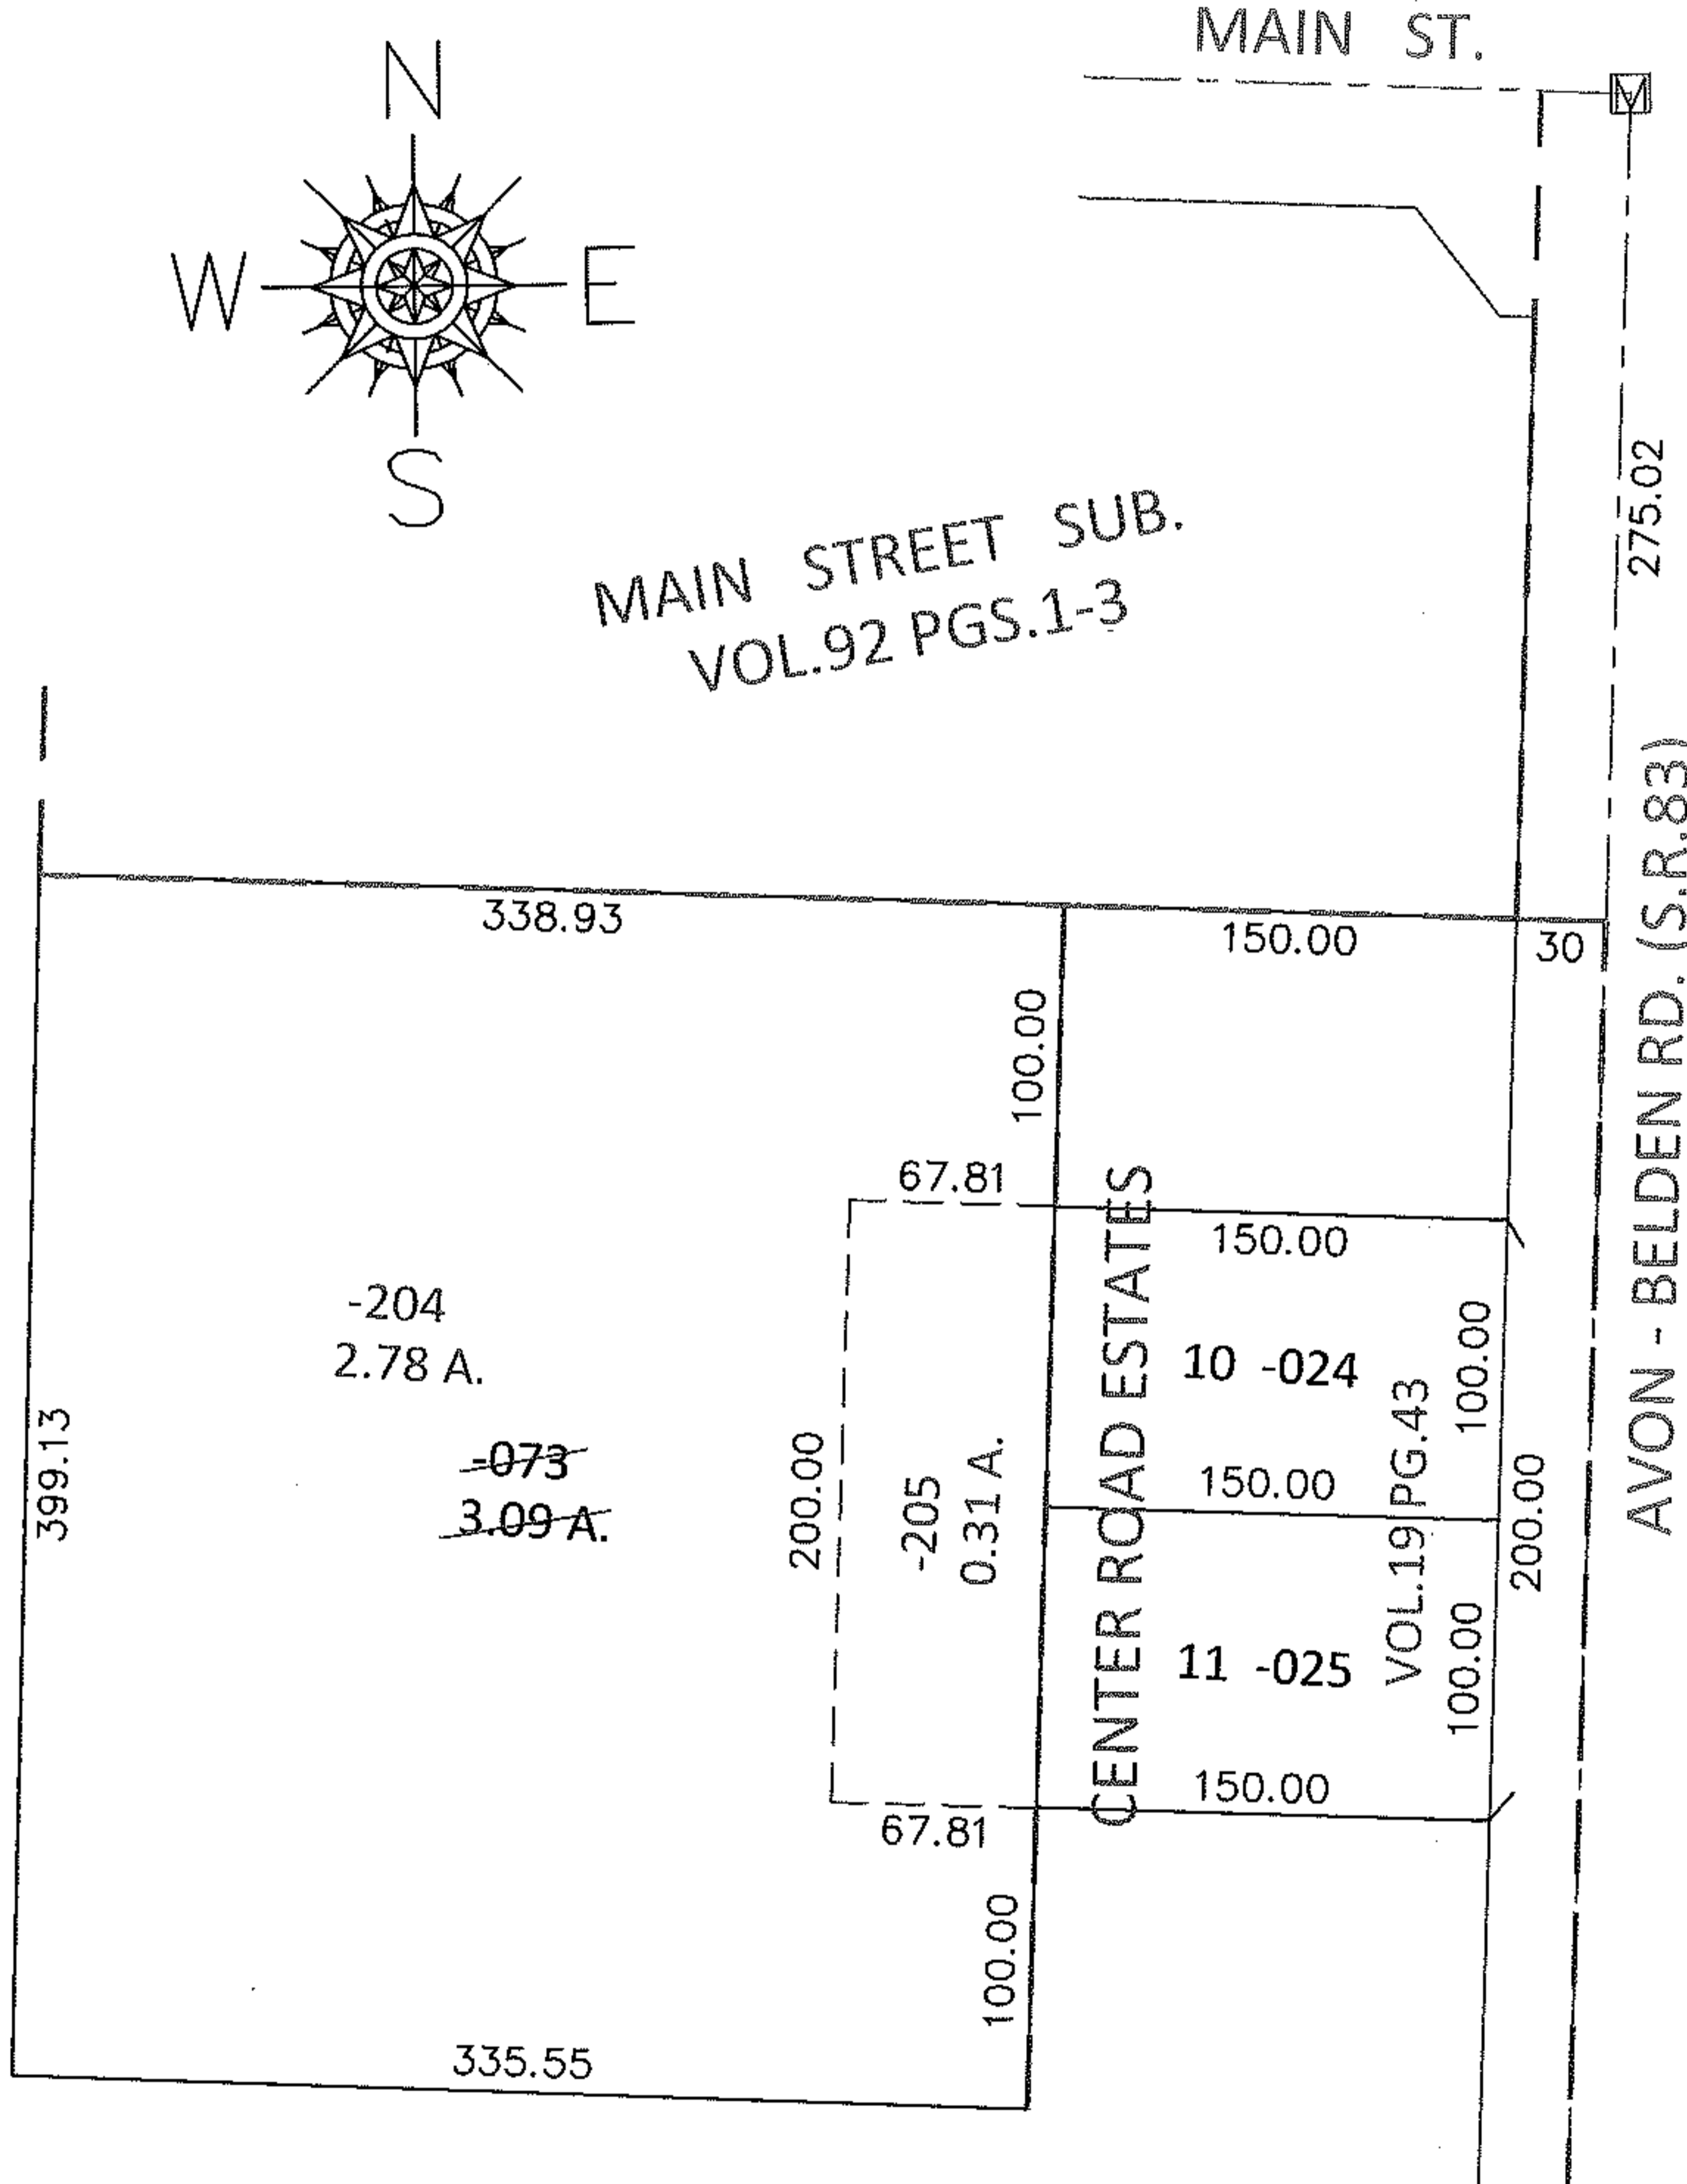

**SPLITS/DEEDS PROCESSED**

LORAIN COUNTY TAX MAP DEPARTMENT  
226 MIDDLE AVE. ELYRIA, OHIO

SURVEYED BY: AMY M. KELLY

CLOSURE: 00:10,000

MAP PAGE(S): 4-00-016-F

APPROVED BY: RRM DATE: 11-24-10

SCALE: 1"= 100 PRIOR INST.: 20030932973