




PARENT PARCEL: 10-00-008-101-011

CHILD PARCEL: XX-XX-XXX-XXX-XXX

STARTING POINT: CL OF OBERLIN -ELYRIA RD. (U.S. 20) & WEST LINE OF CARLISLE SECTION 8

14-02879-X

MAP CORRECTION

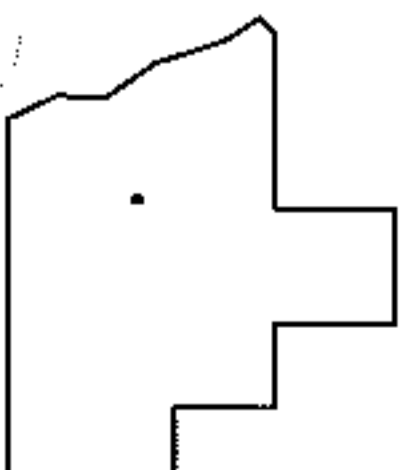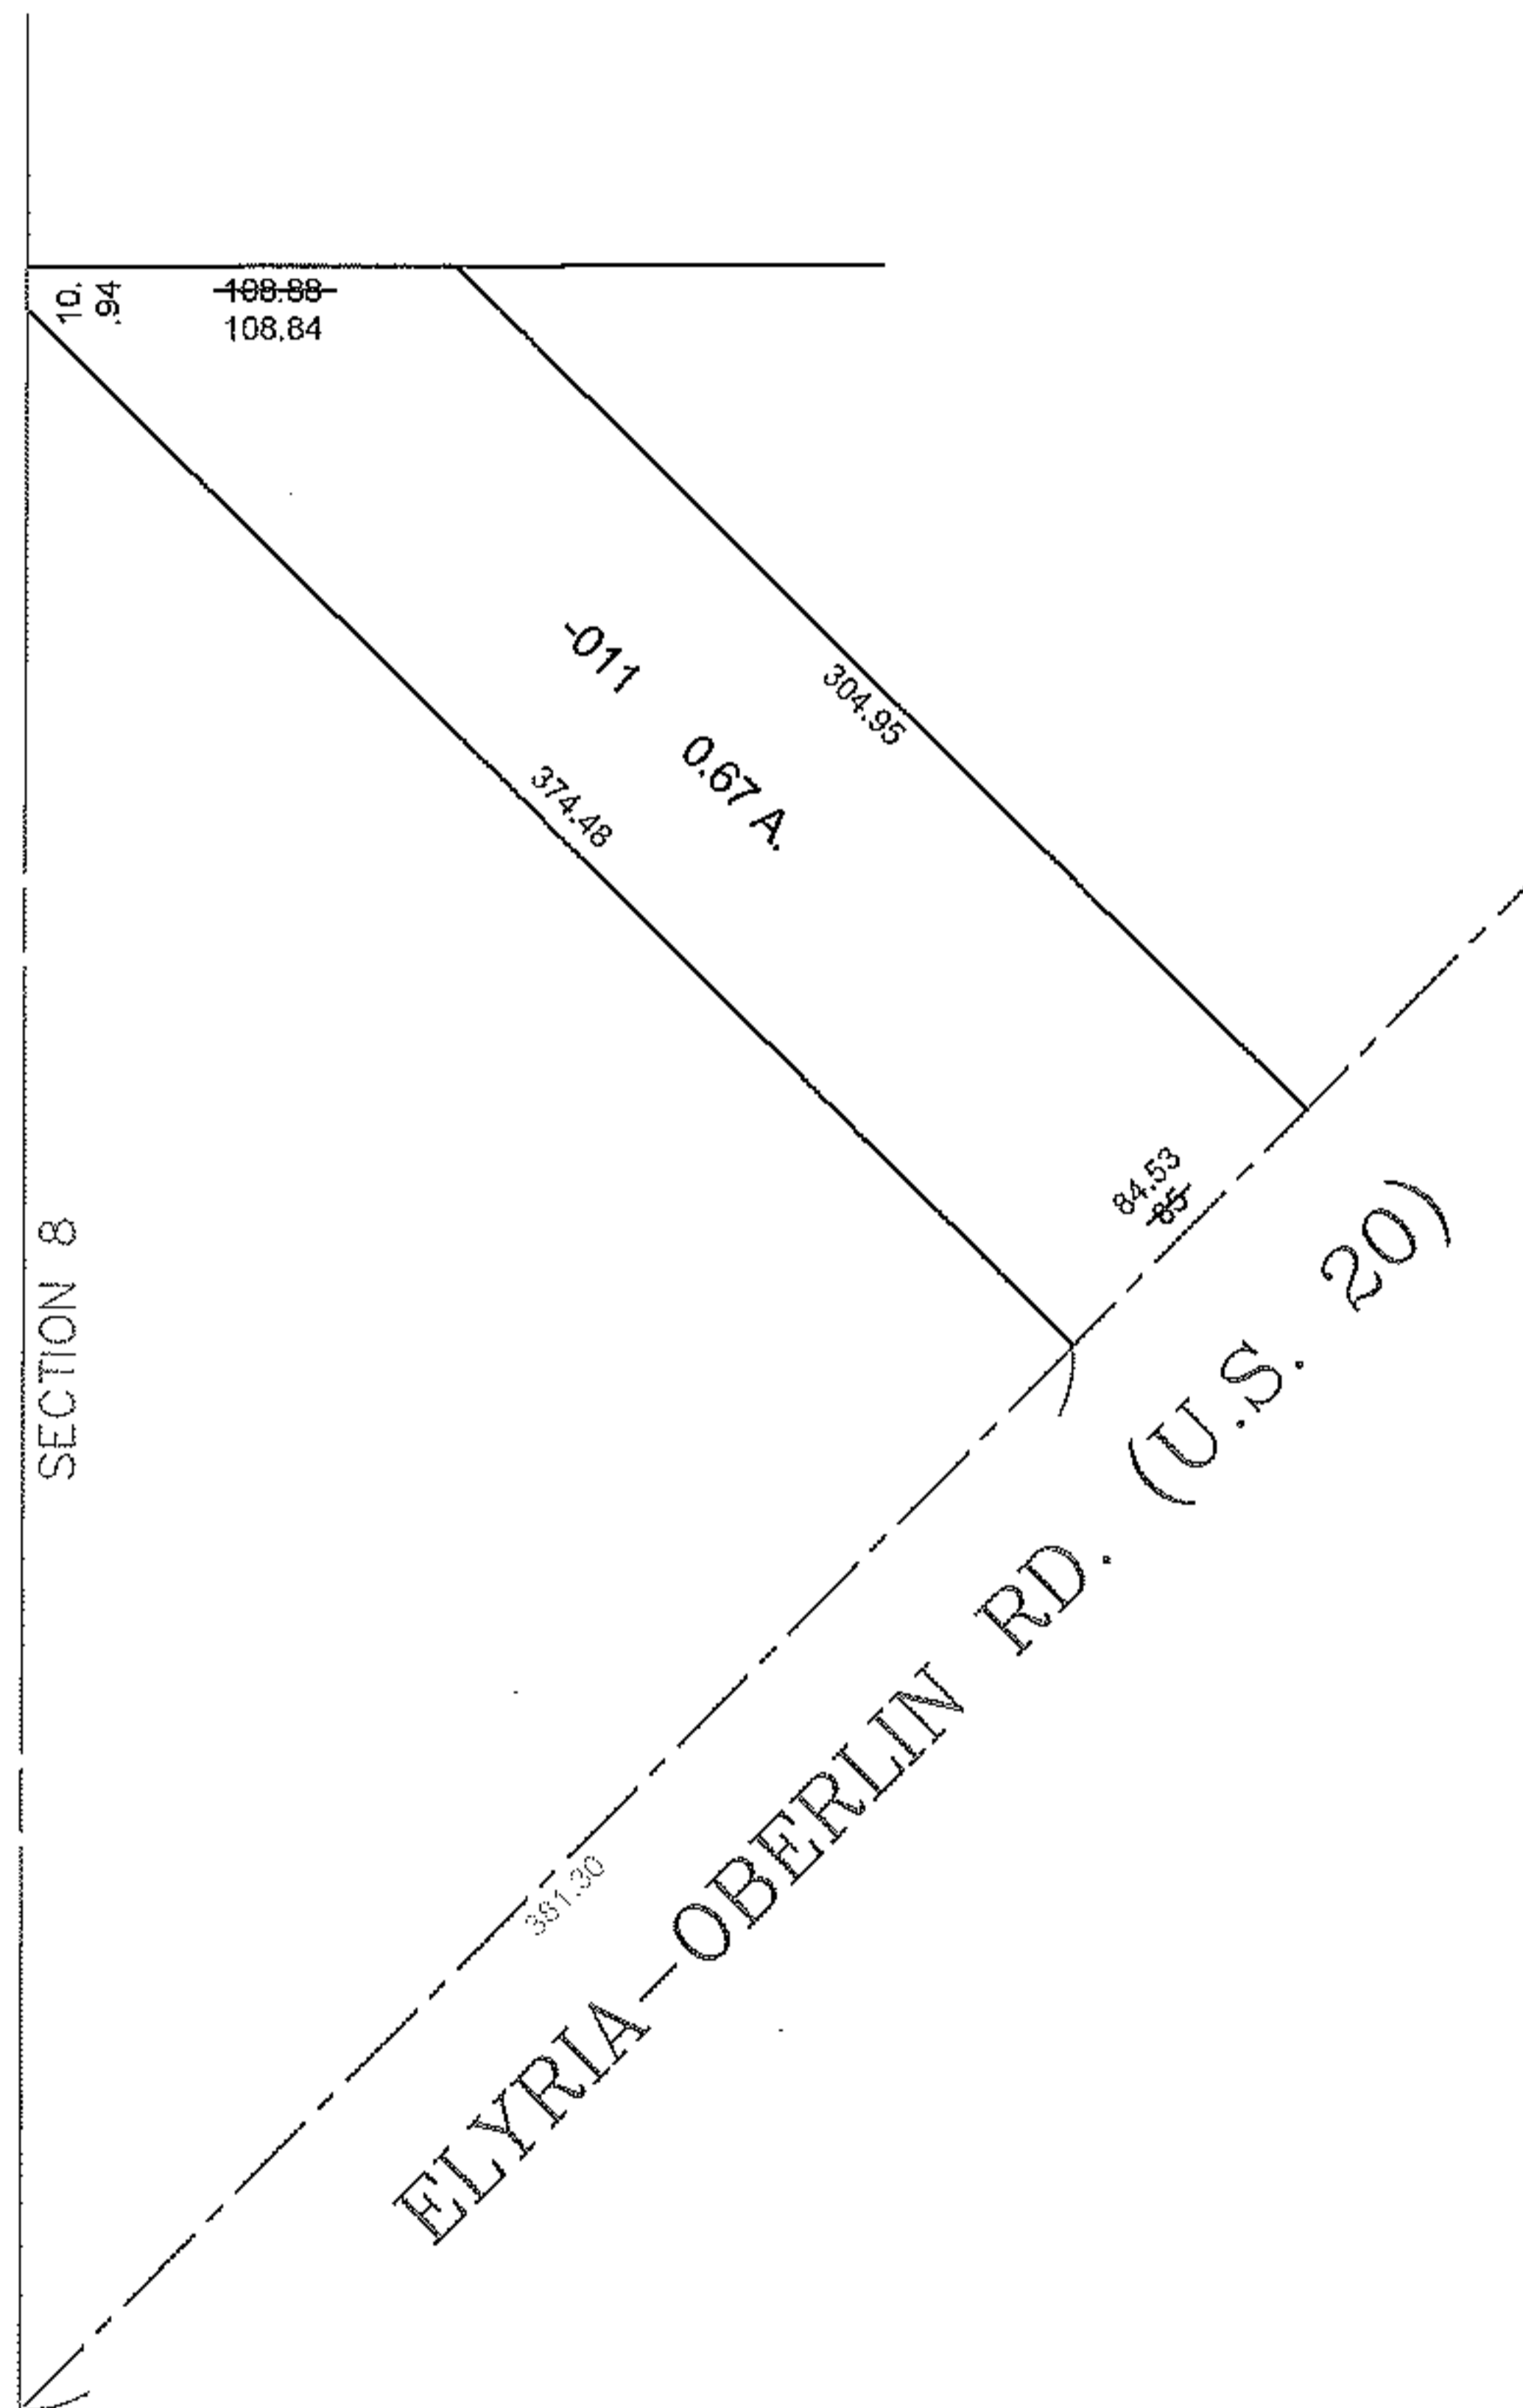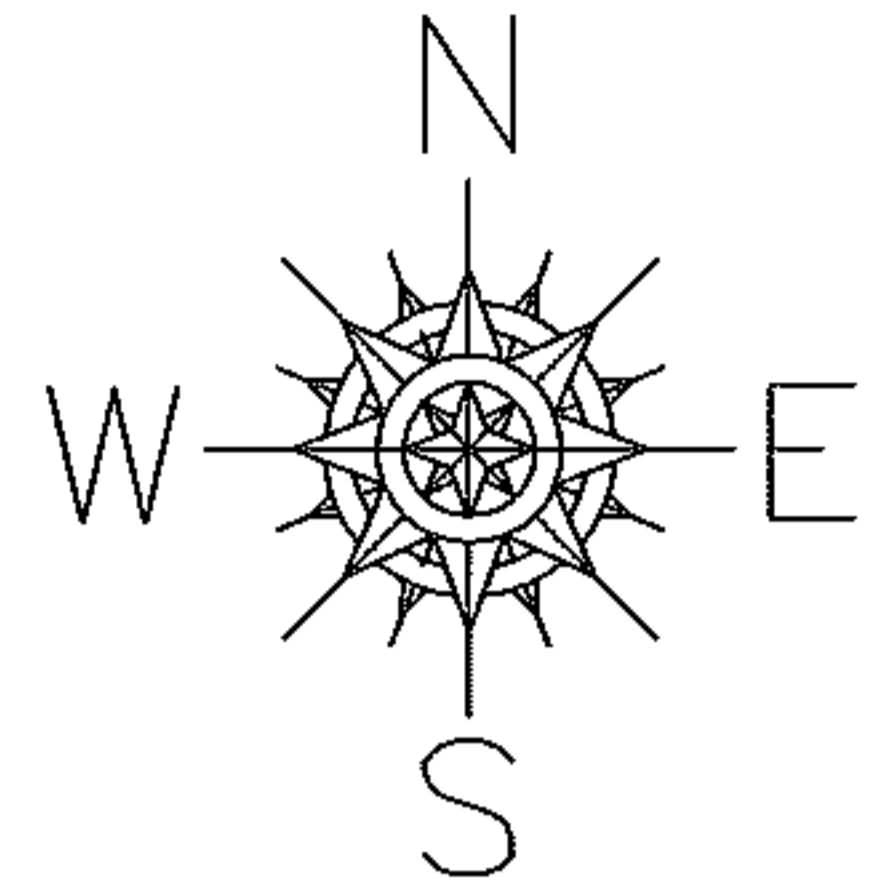

SPLITS/DEEDS PROCESSED

LORAIN COUNTY TAX MAP DEPARTMENT
 226 MIDDLE AVE. ELYRIA, OHIO

SURVEYED BY: DALE R. HAYWOOD
 CLOSURE: 0.01 : 10,000
 MAP PAGE(S): 10-00-008
 APPROVED BY: TJS DATE: 1/27/14
 SCALE: 1" = 100 PRIOR INSTRUMENT: 20130467110