


PARENT PARCEL: 08-12-014-000-005, -007, -008, & -010


CHILD PARCEL: XX-XX-XXX-XXX-XXX

STARTING POINT: XXXXXX

14-02880-C

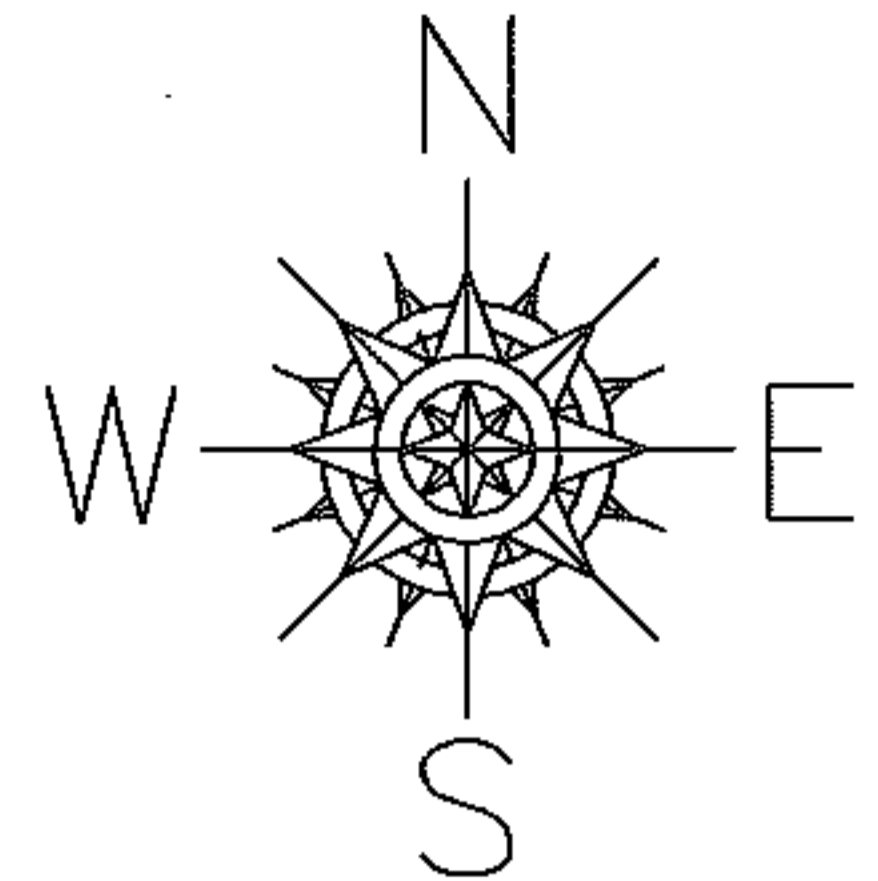

MAP CORRECTION ONLY
BOUNDARY LINES SHOULD FOLLOW
CENTERLINE OF BAIRD RD.

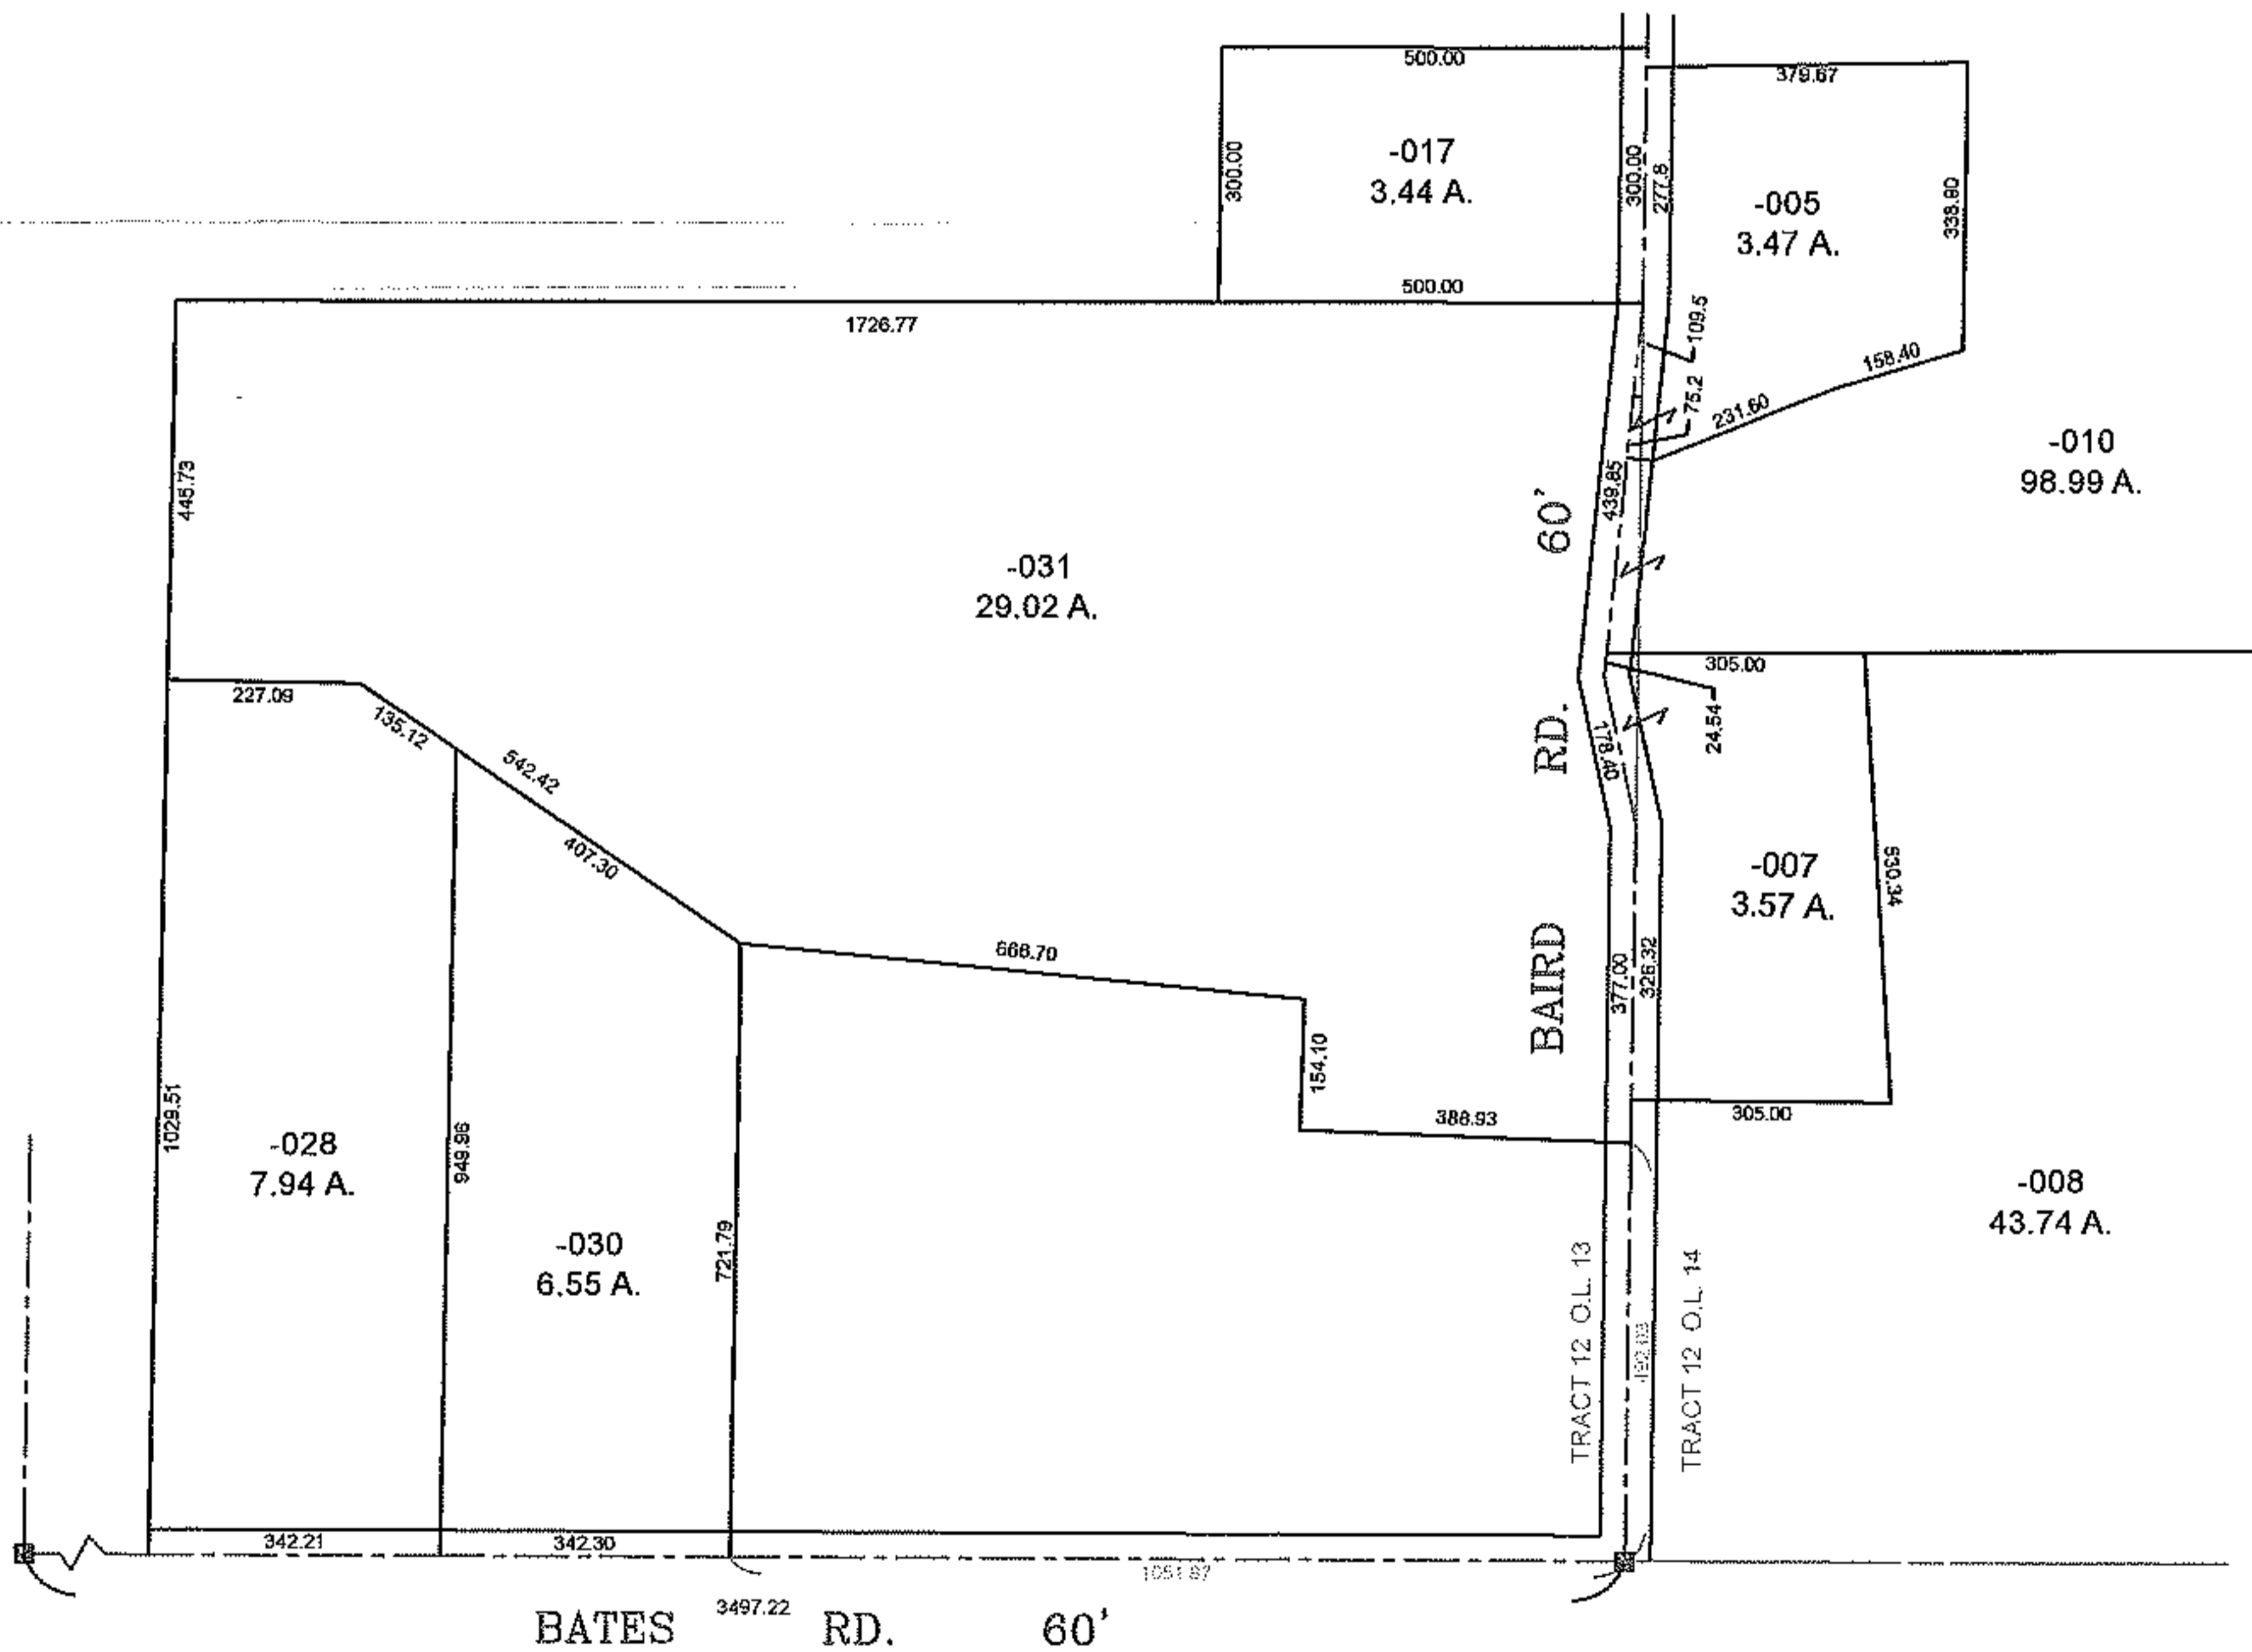

SPLITS/DEEDS PROCESSED

LORAIN COUNTY TAX MAP DEPARTMENT
226 MIDDLE AVE. ELYRIA, OHIO

SURVEYED BY: NA

CLOSURE: NA

MAP PAGE(S): 8-E

APPROVED BY: TJS DATE: 1/30/14

SCALE: 1"=400 PRIOR INST.: NA