
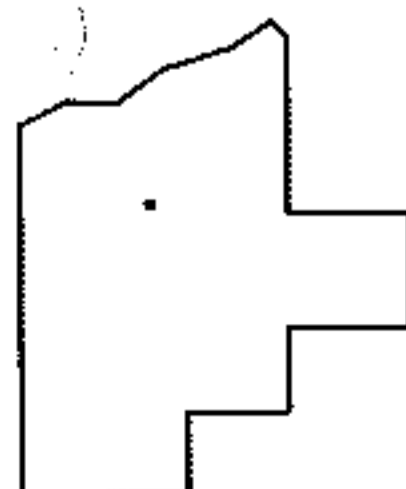
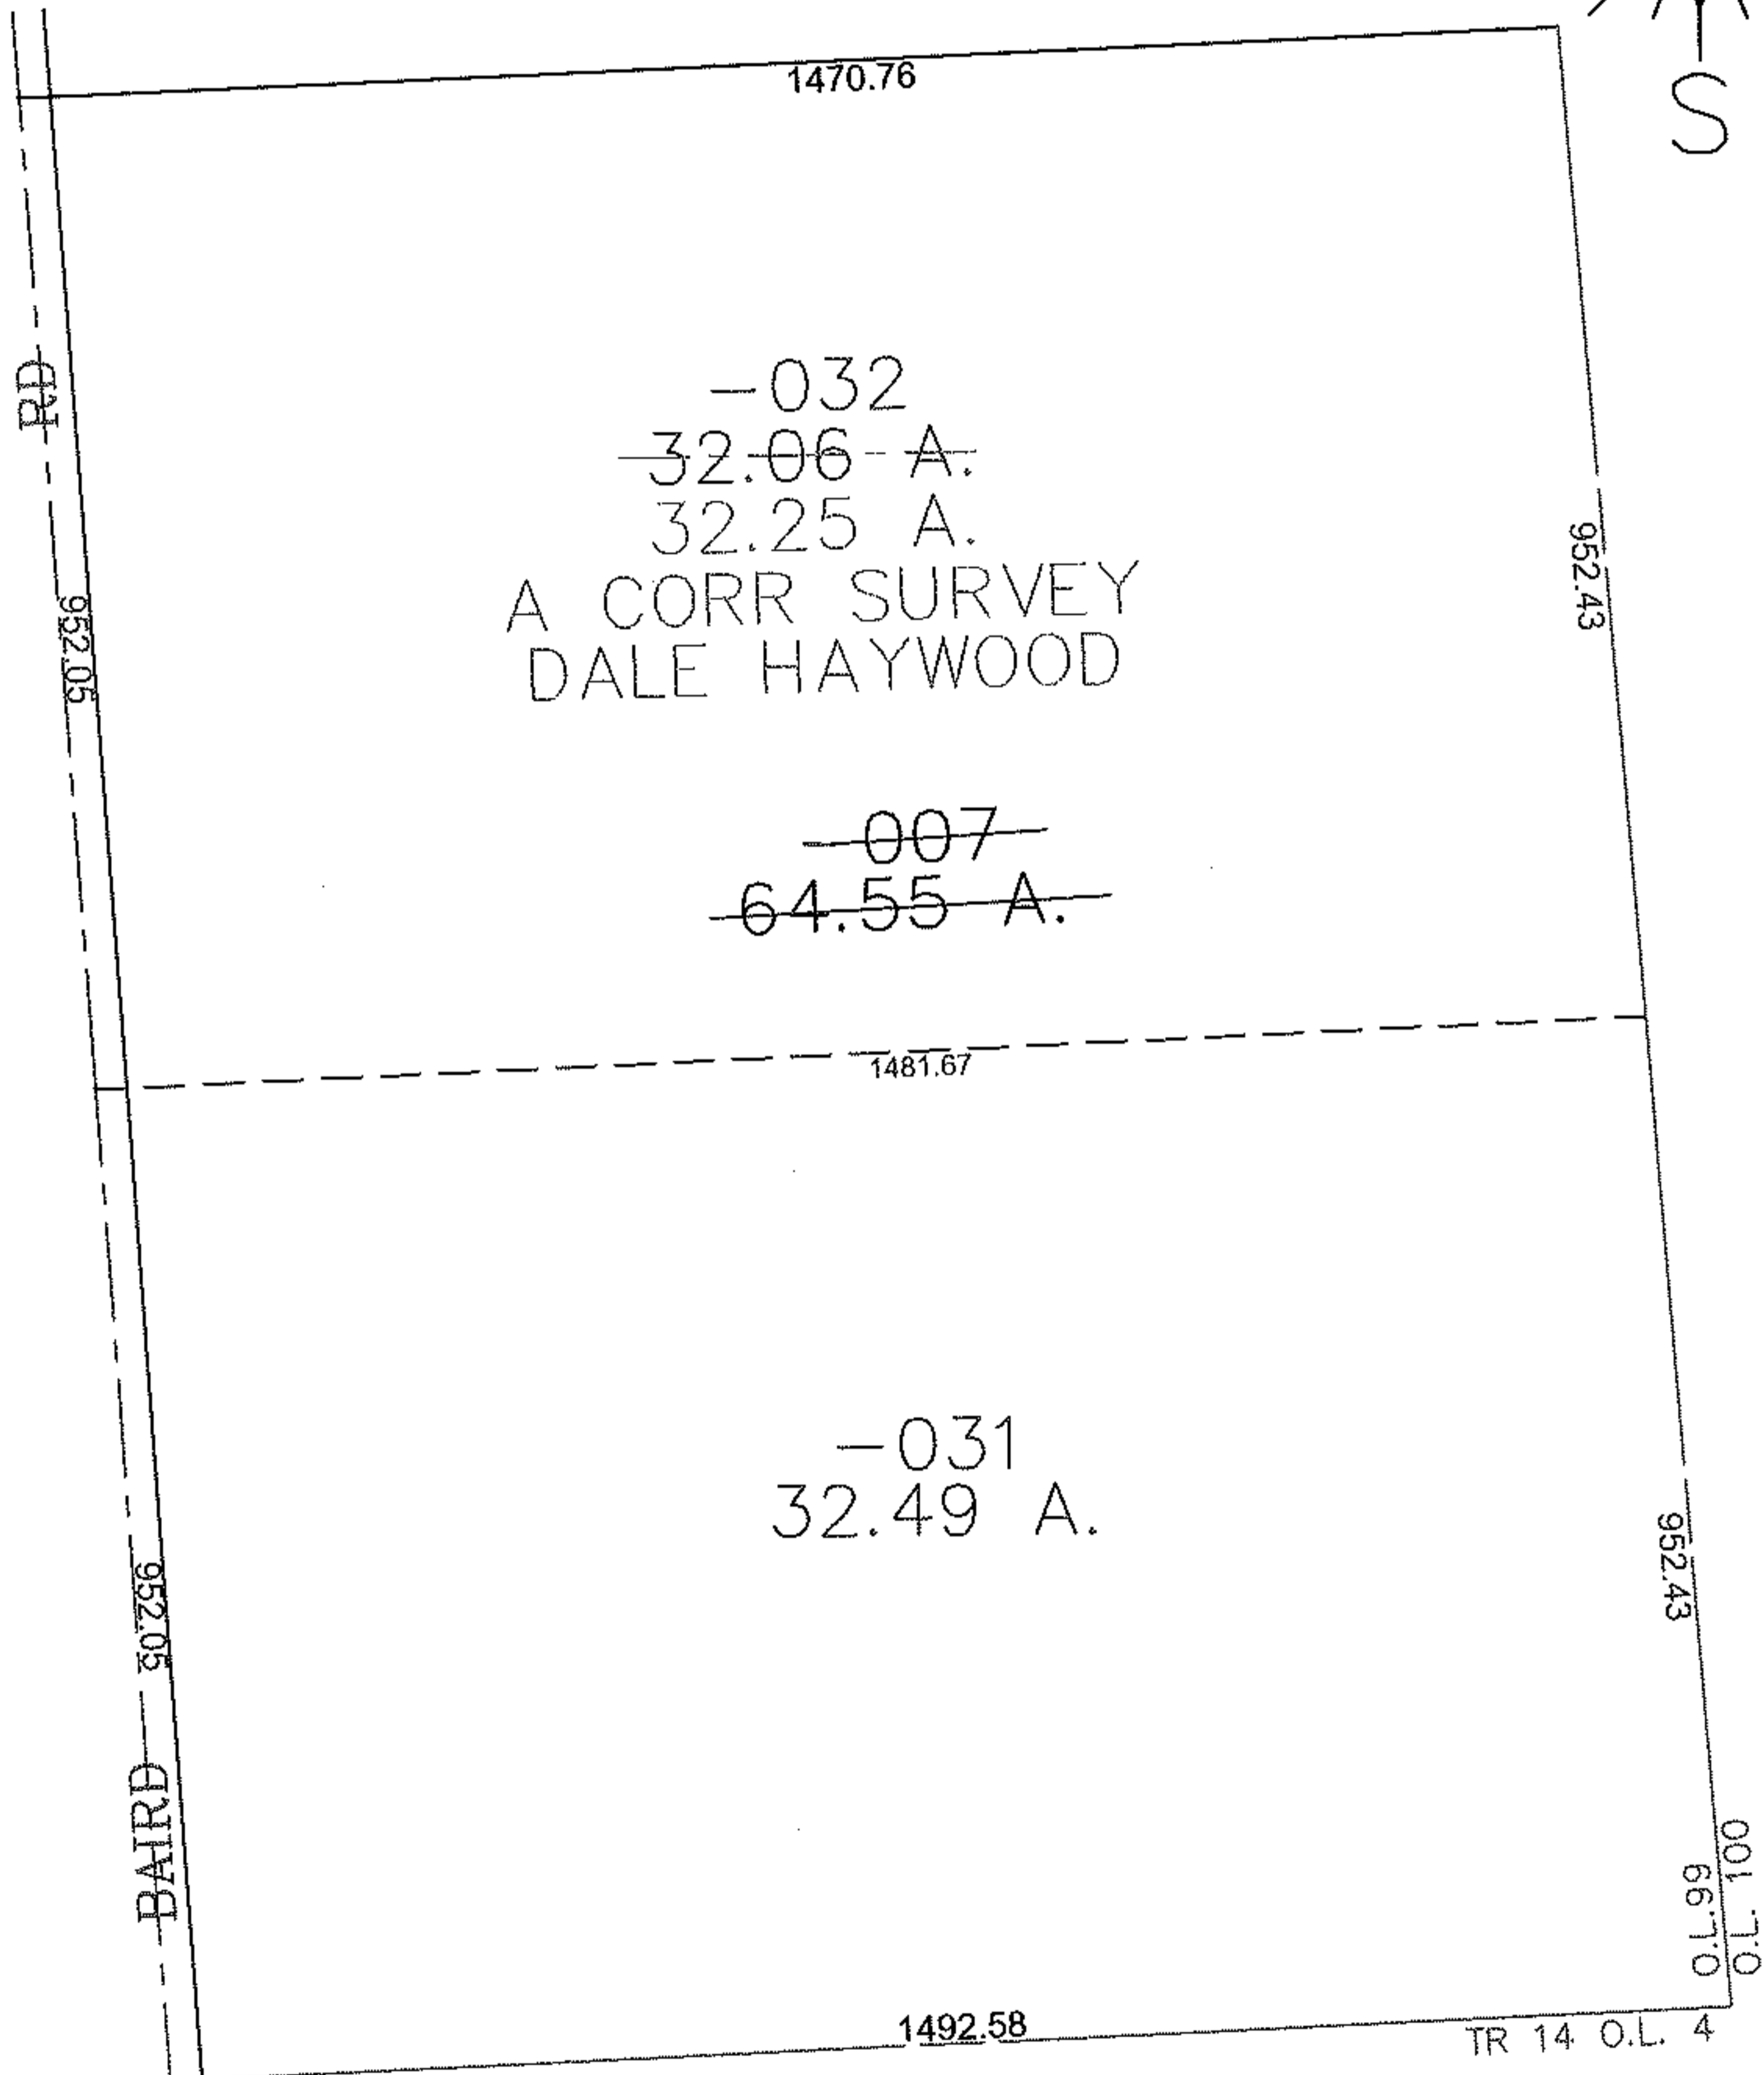


PARENT PARCEL: 08-00-099-000-007

CHILD PARCEL: 08-00-099-000-031, -032

STARTING POINT: CENTERLINE OF BAIRD RD & O.L. 99

10-02881

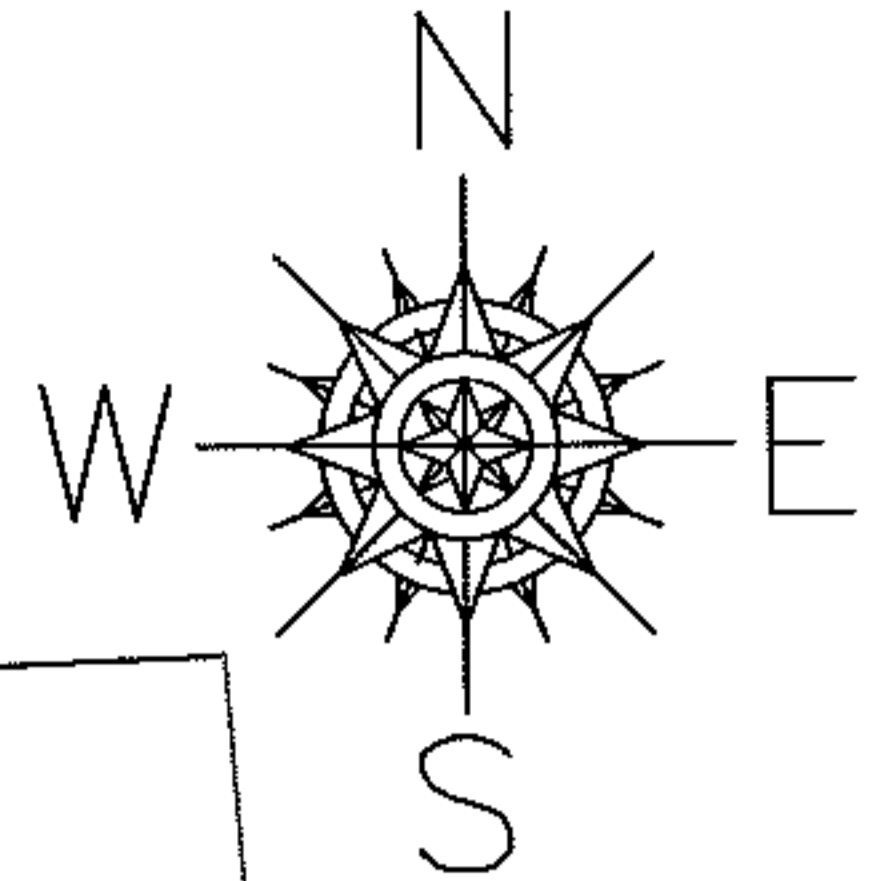

SPLITS/DEEDS PROCESSED
 LORAIN COUNTY TAX MAP DEPARTMENT
 226 MIDDLE AVE. ELYRIA, OHIO

SURVEYED BY: DALE HAYWOOD
 CLOSURE: 0.01 : 10.000
 MAP PAGE(S): 8-B
 APPROVED BY: JAH DATE: 12-6-2010
 SCALE: 1" = 300 PRIOR INSTRUMENT: DV 946/451