
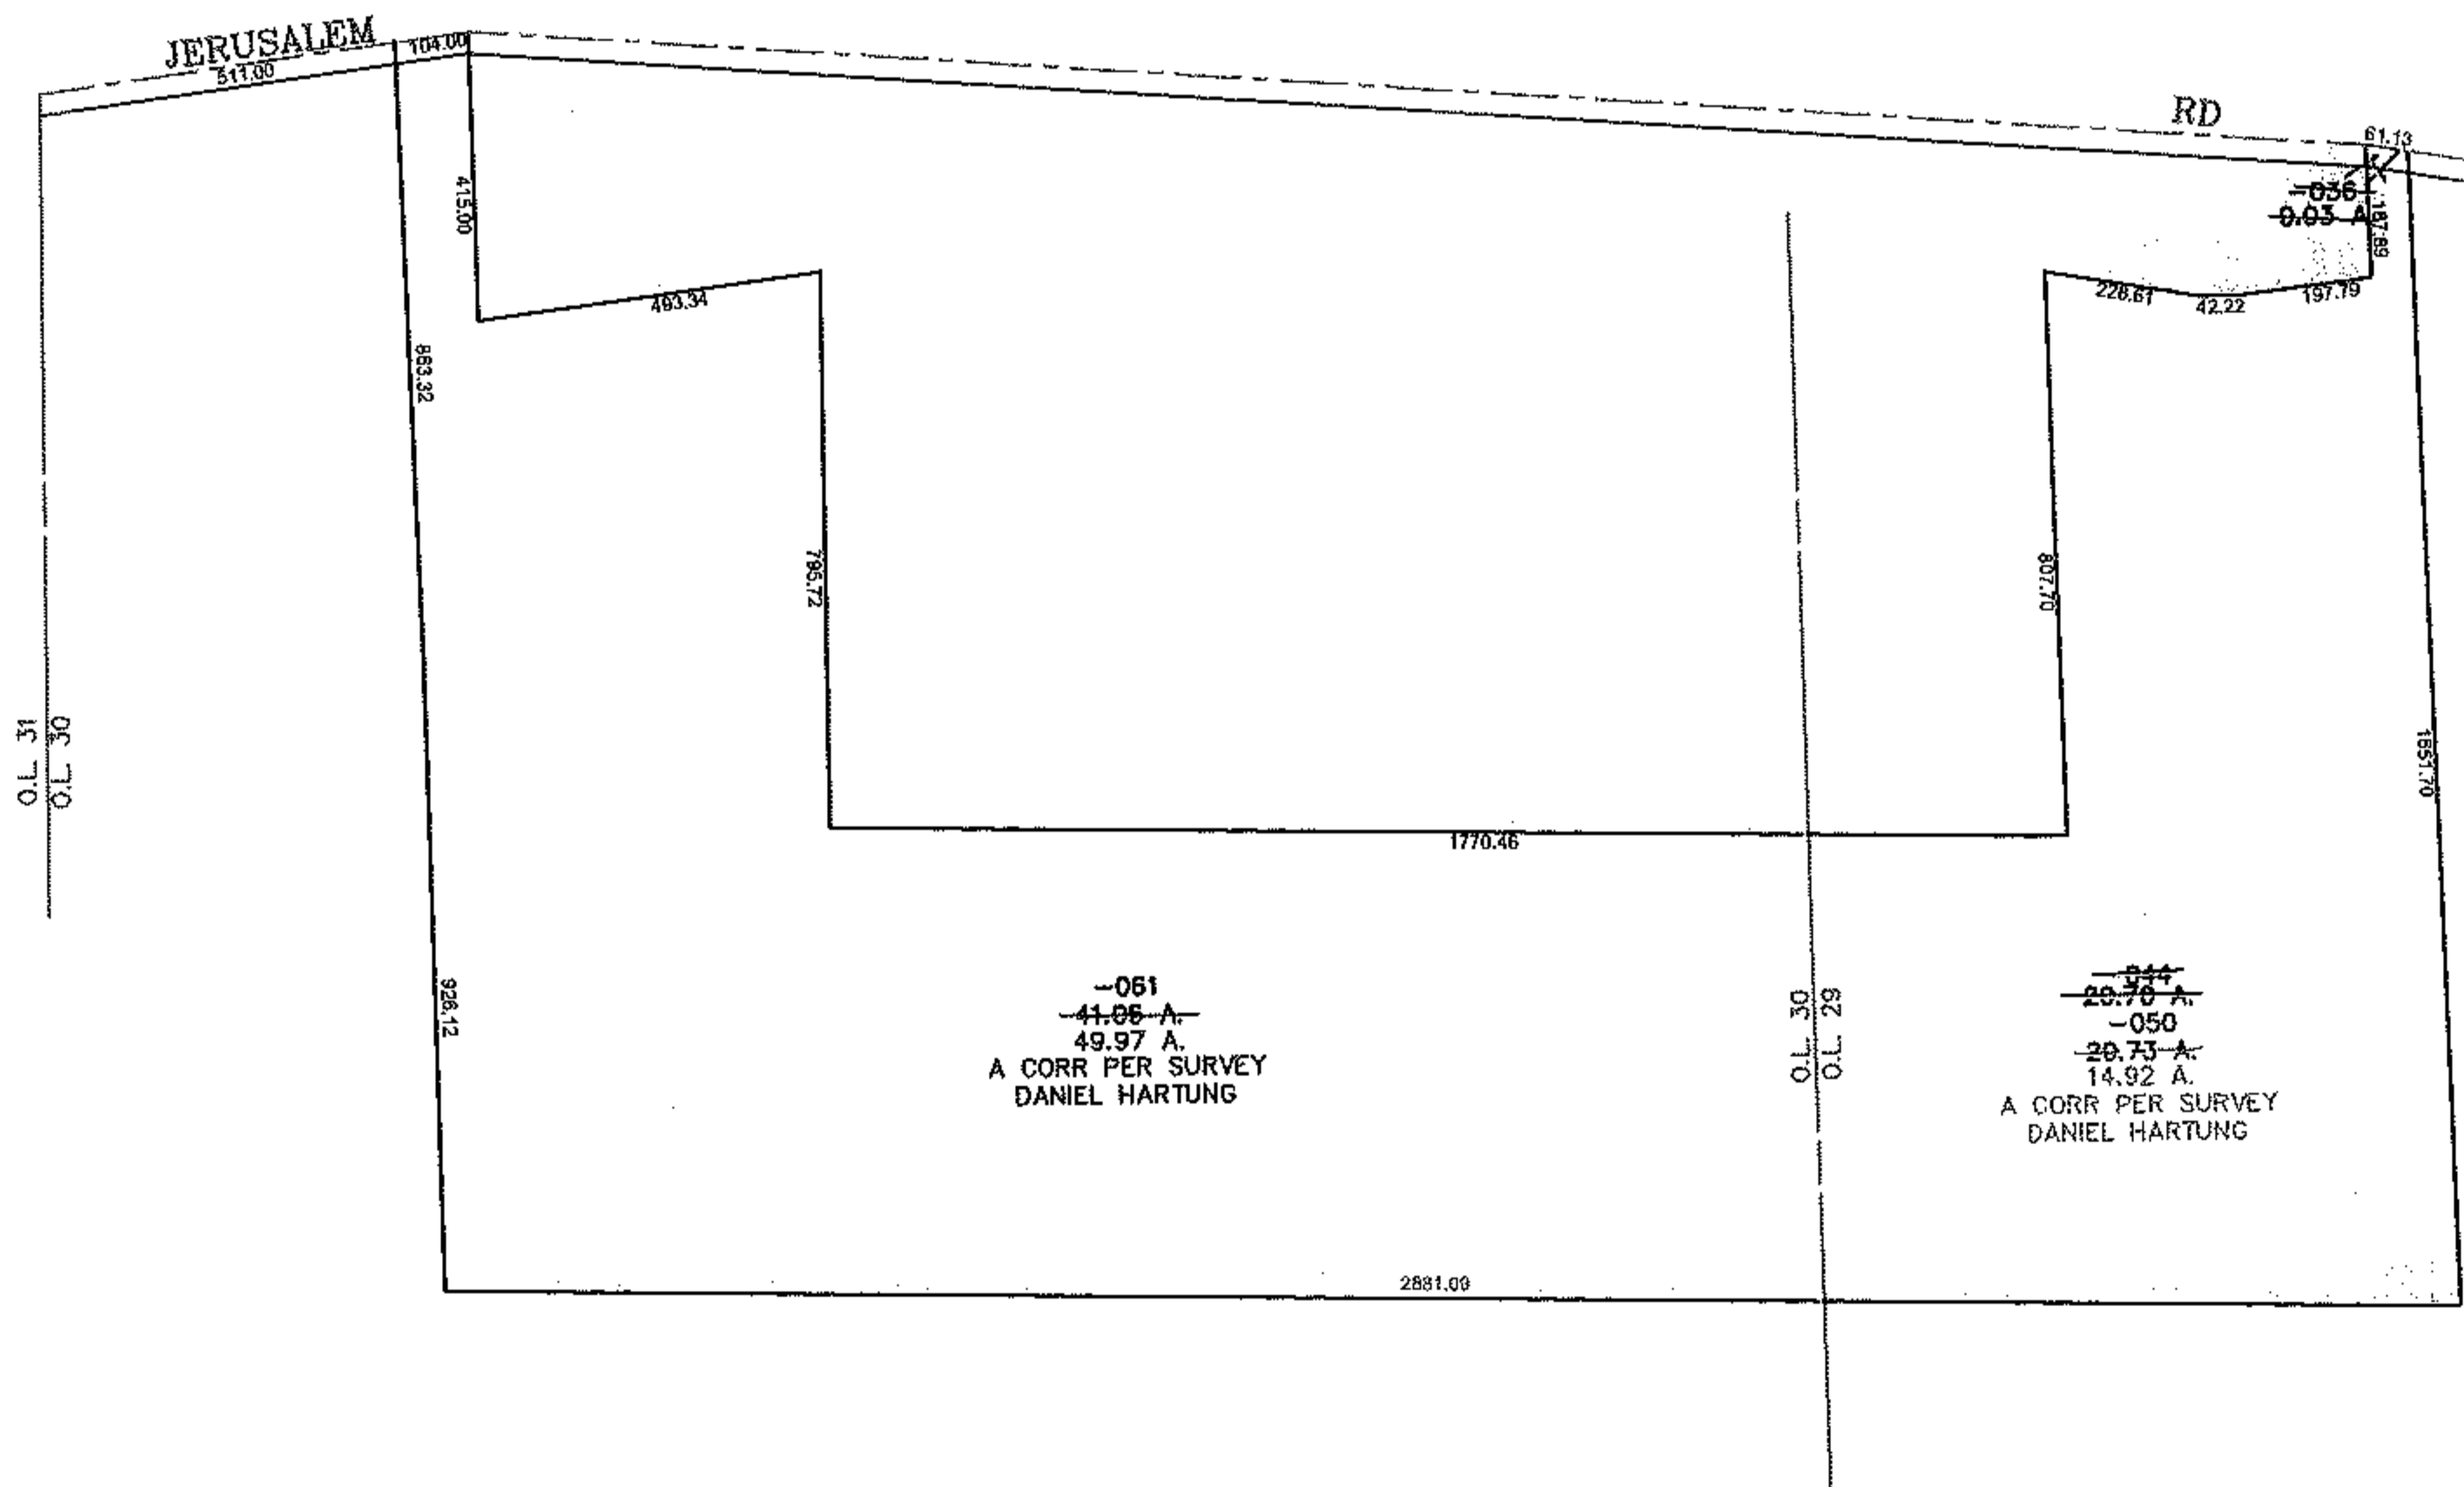


PARENT PARCEL: 01-00-030-000-061, 01-00-029-000-036, -044

CHILD PARCEL: 01-00-030-000-061, 01-00-029-000-050

STARTING POINT: CENERTLINE OF JERUSALEM RD & O.L. 30

10-02884

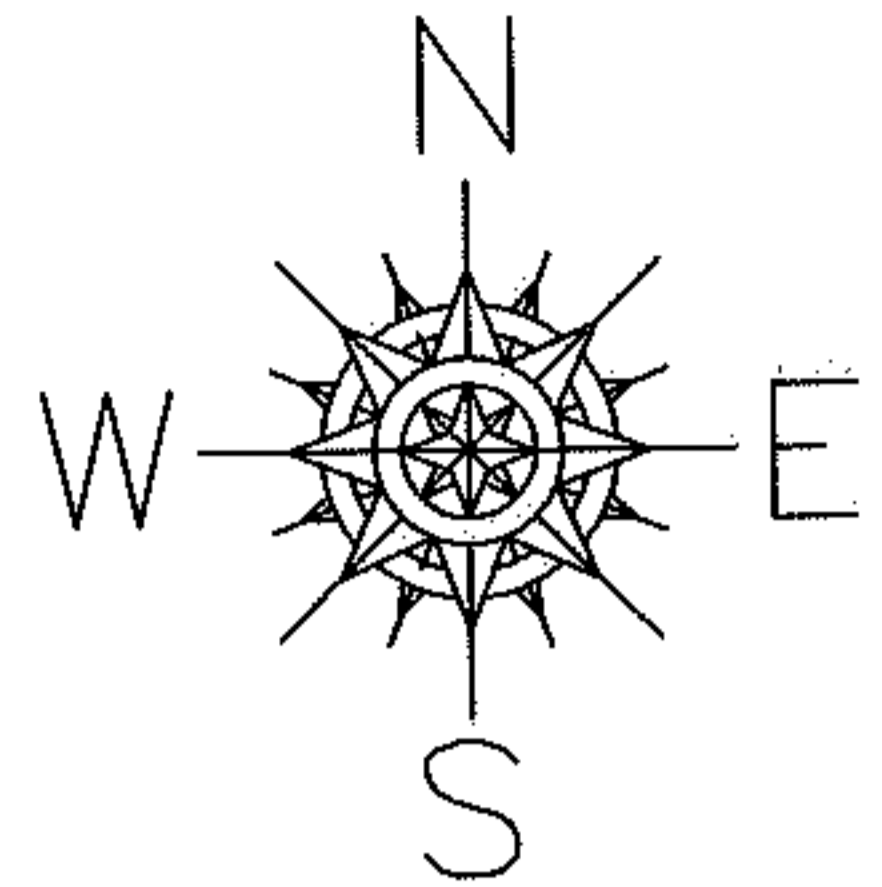

**SPLITS/DEEDS PROCESSED**

LORAIN COUNTY TAX MAP DEPARTMENT  
226 MIDDLE AVE. ELYRIA, OHIO

SURVEYED BY: DANIEL HARTUNG

CLOSURE: 0.00 : 10,000

MAP PAGE(S): 01-00-030-A,B

APPROVED BY: JAH DATE: 12-20-2010

SCALE: 1" = 500 PRIOR INSTRUMENT: 20080278517