
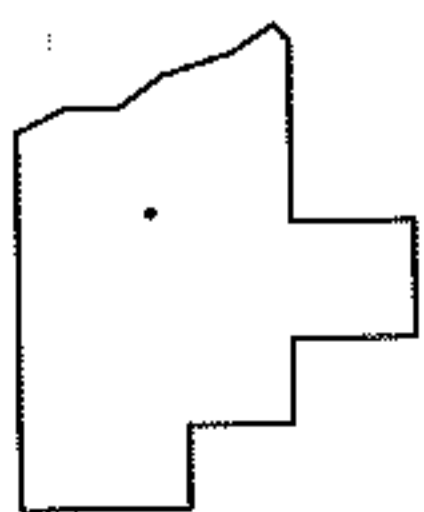


PARENT PARCEL: 02-02-003-103-015

14-02888-A

CHILD PARCEL:

STARTING POINT: INTERSECTION OF C/L OF S.R. 58 AND C/L OF COOPER FOSTER PARK RD.

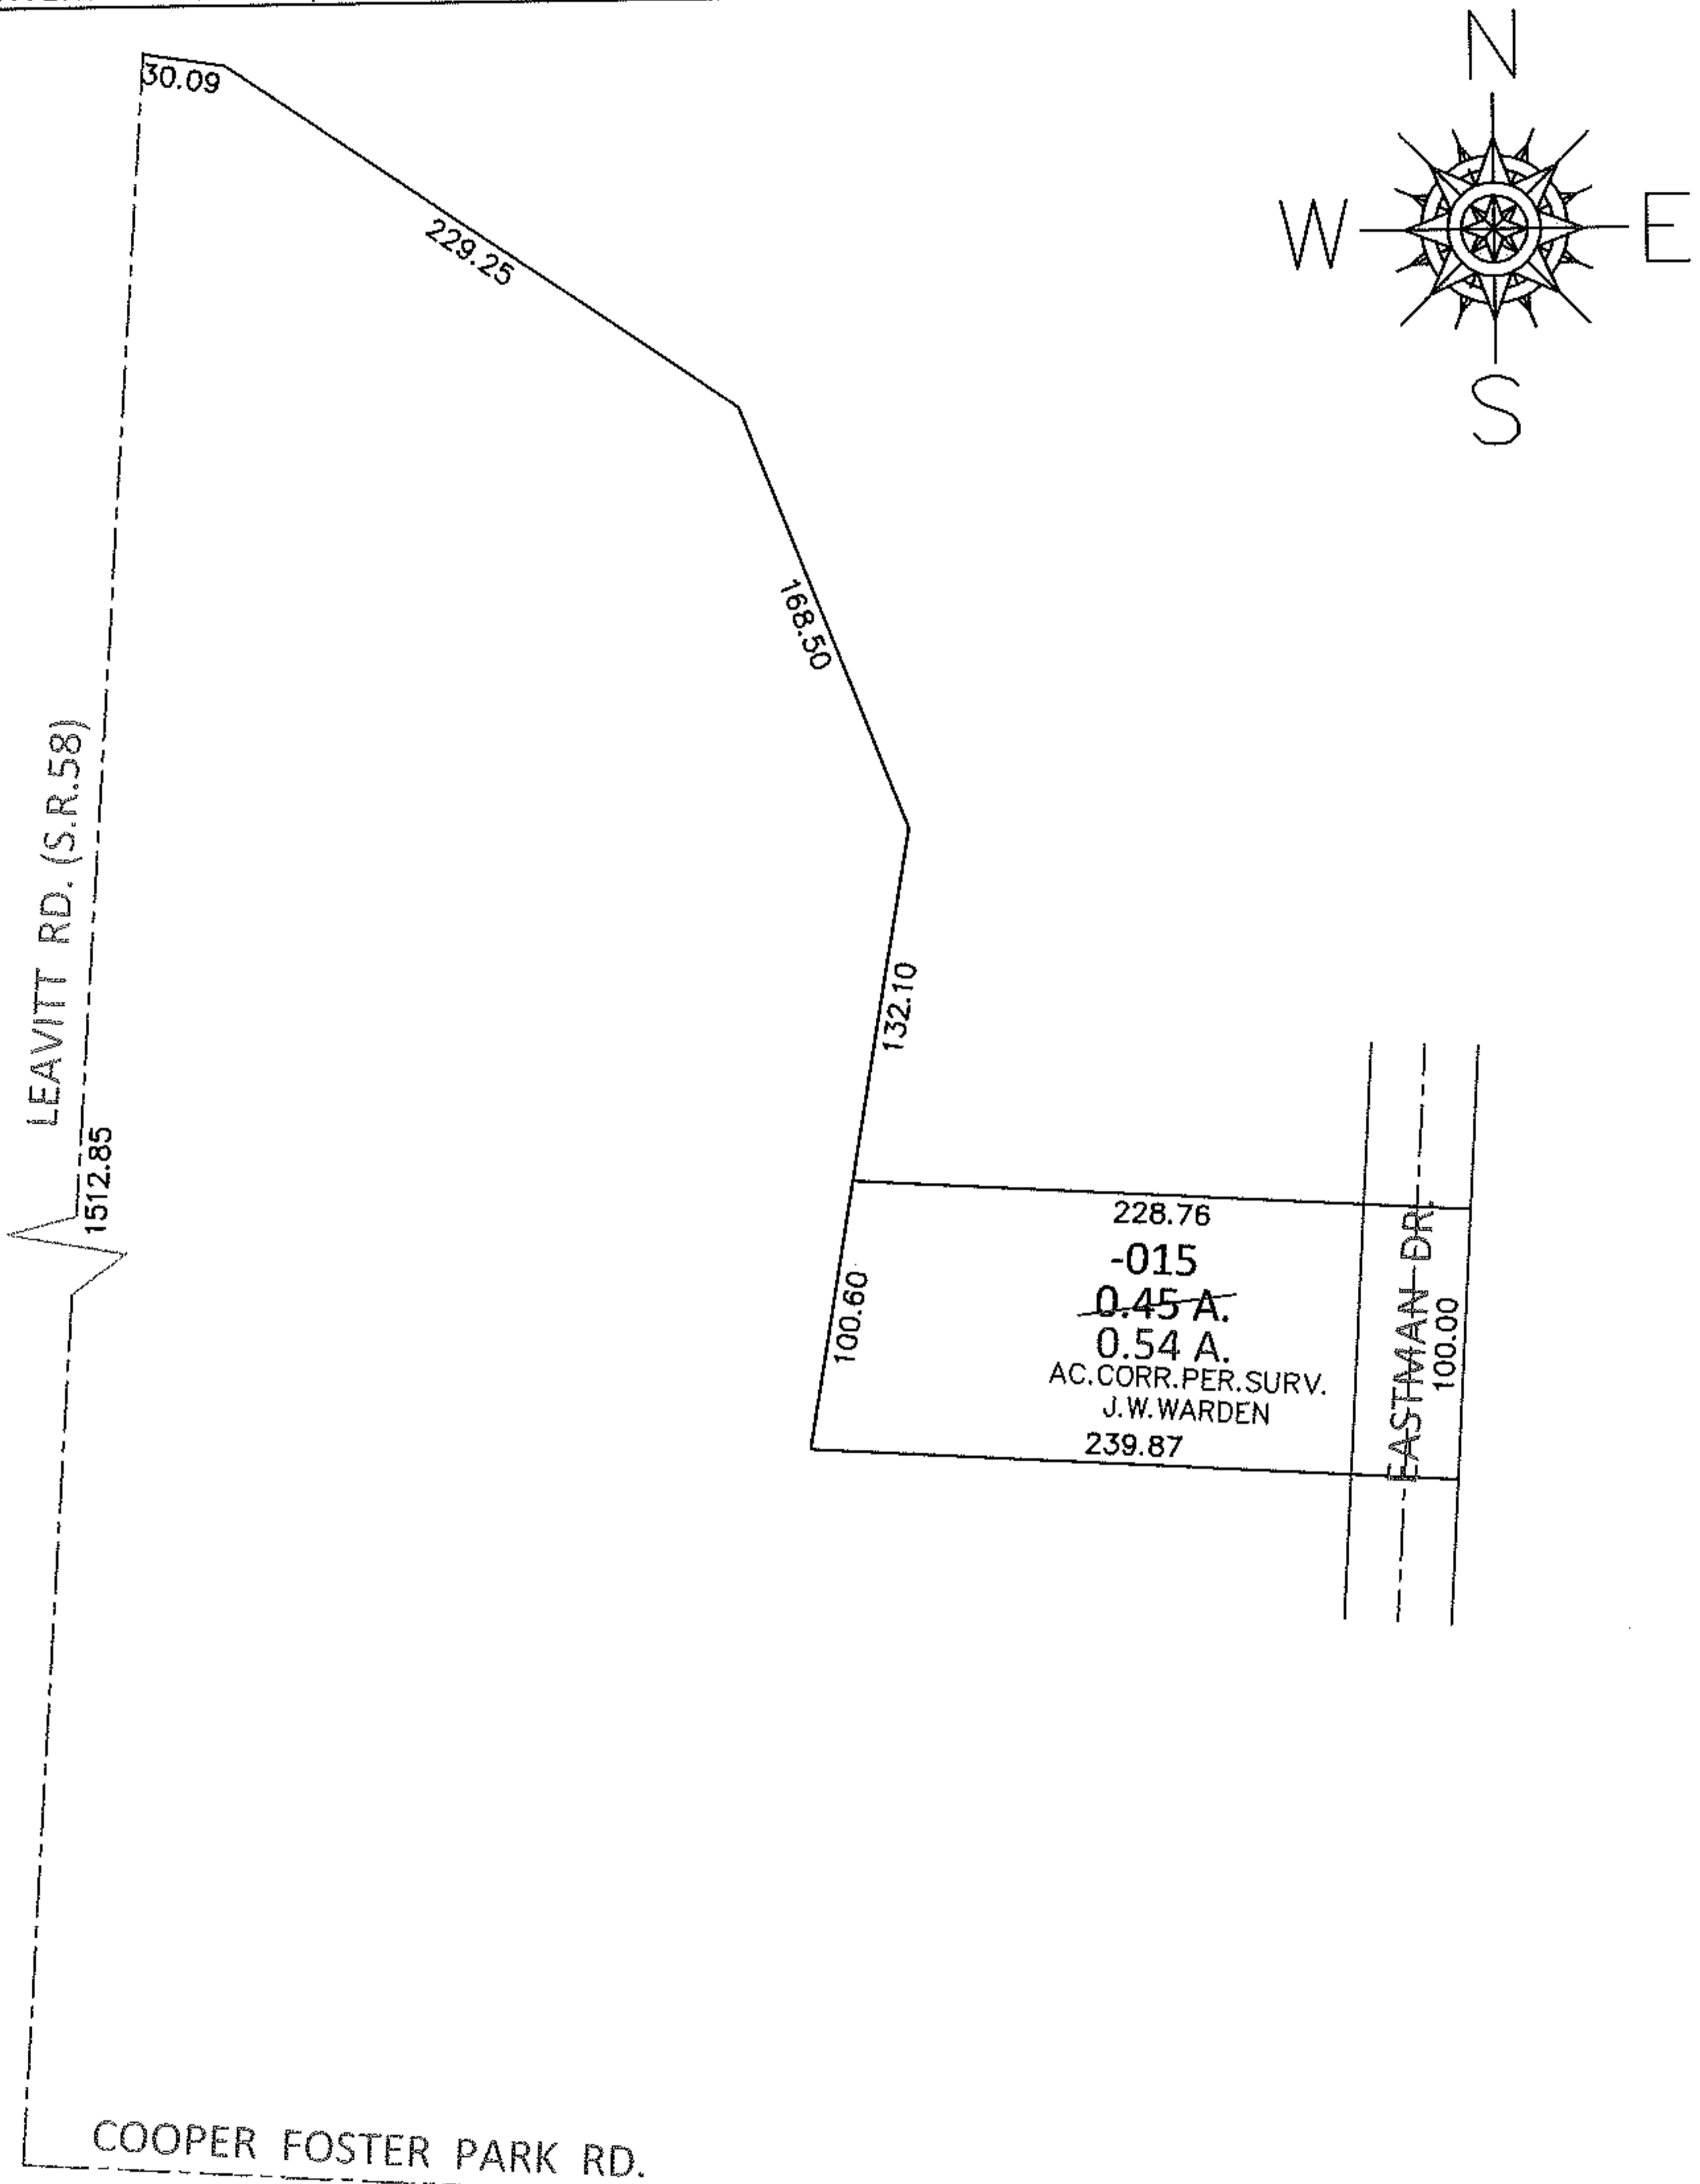

SPLITS/DEEDS PROCESSED

LORAIN COUNTY TAX MAP DEPARTMENT
226 MIDDLE AVE. ELYRIA, OHIO

SURVEYED BY: J.W. WARDEN

CLOSURE: .01:10,000

MAP PAGE(S): 2-02-003

APPROVED BY: RRM DATE: 2-7-14

SCALE: 1"= 100 PRIOR INST.: 20040016142