
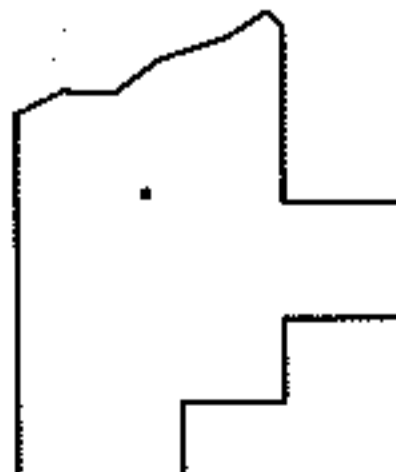
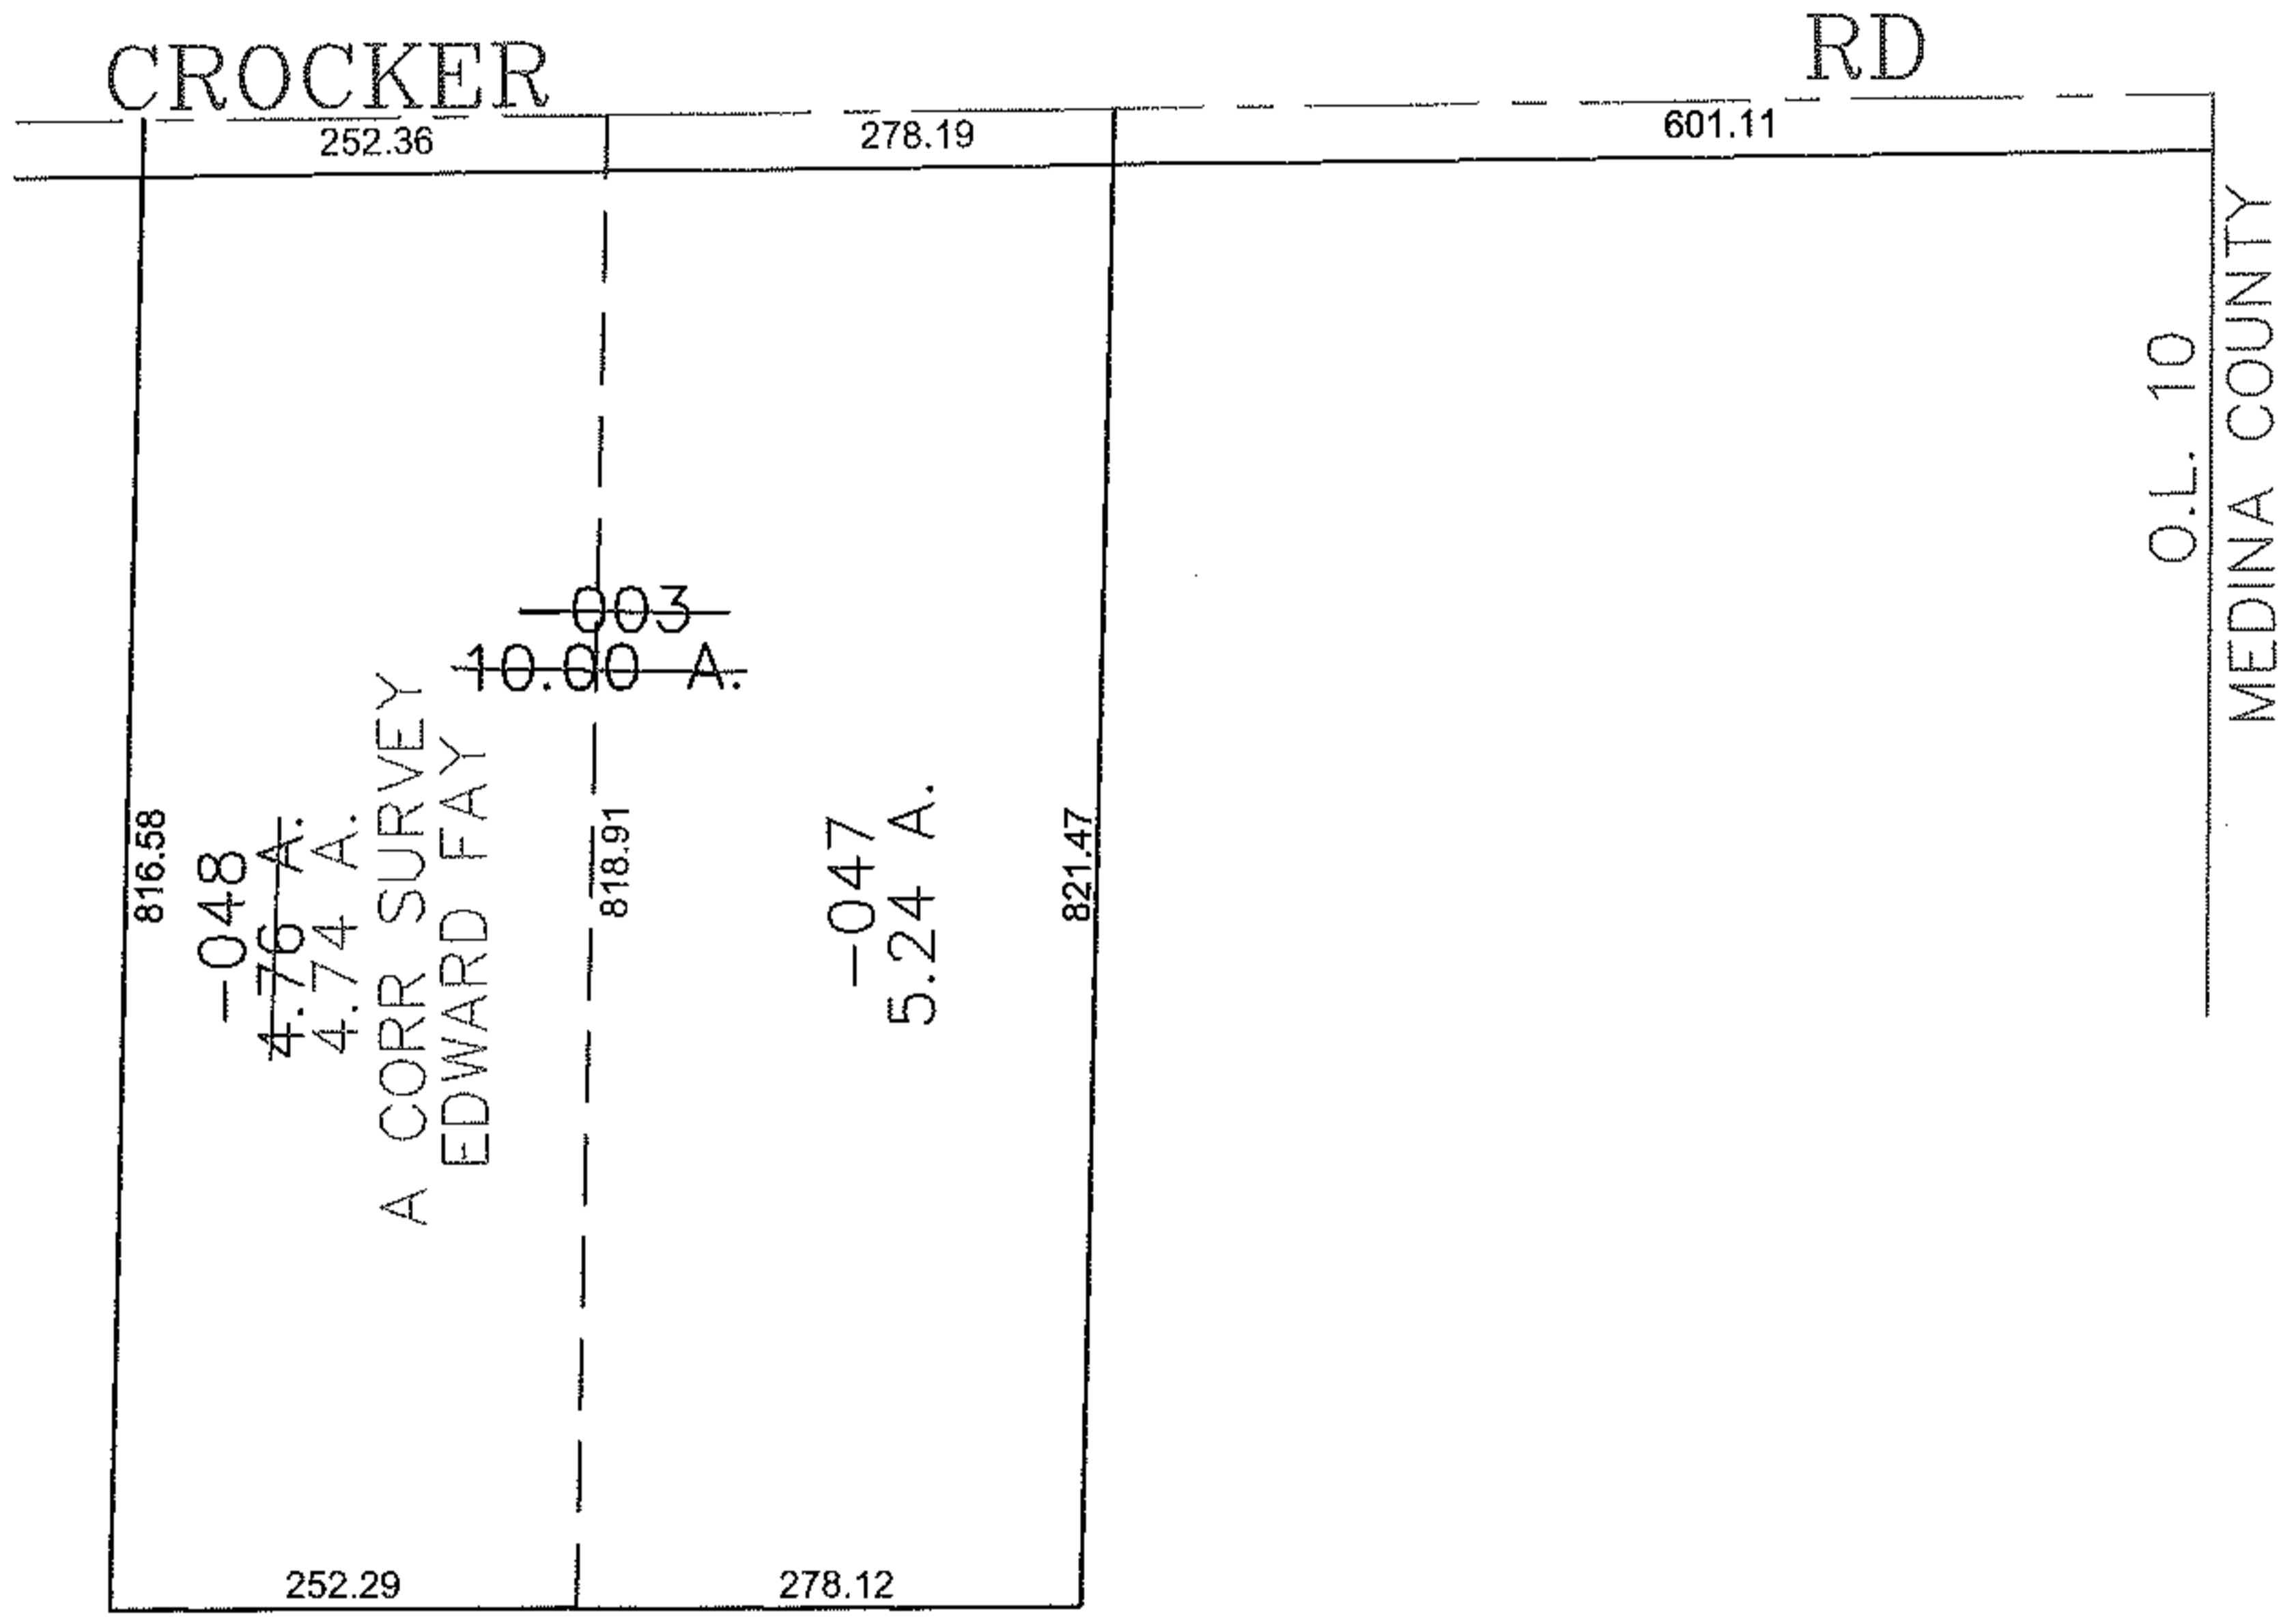


PARENT PARCEL: 16-00-010-000-003

CHILD PARCEL: 16-00-010-000-047, -048

STARTING POINT: CENTERLINE OF CROCKER RD & O.L. 10

10-02889

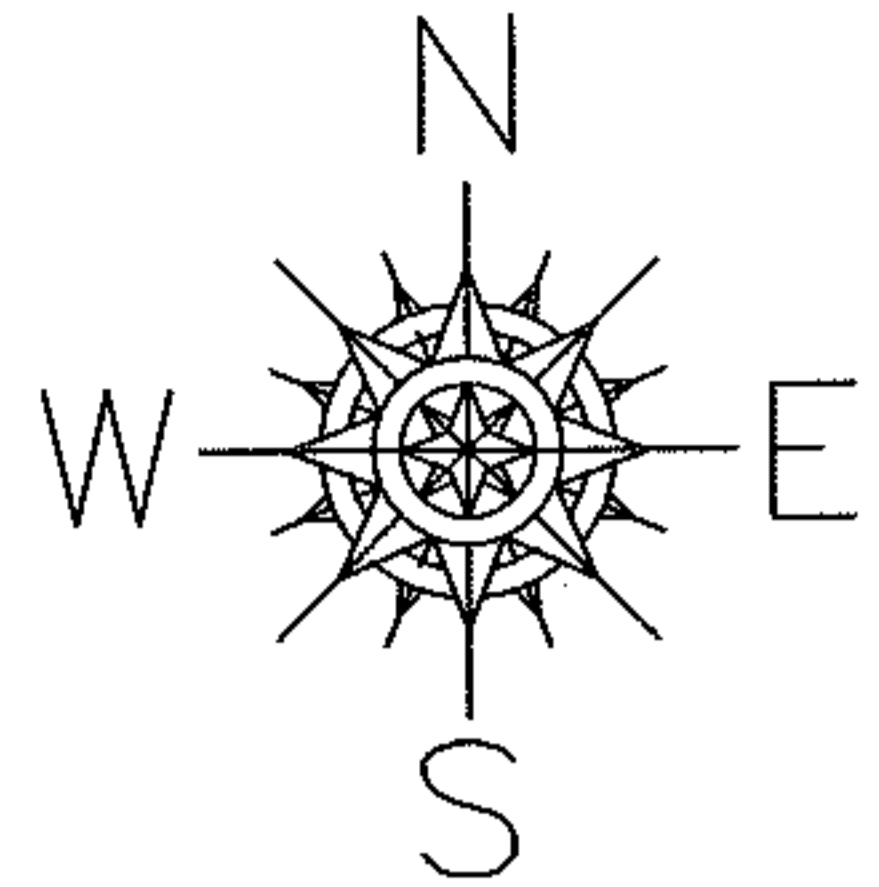

SPLITS/DEEDS PROCESSED
 LORAIN COUNTY TAX MAP DEPARTMENT
 226 MIDDLE AVE. ELYRIA, OHIO

SURVEYED BY: EDWARD FAY
 CLOSURE: 0.00 : 10.000
 MAP PAGE(S): 16-D
 APPROVED BY: JAH DATE: 1-3-2011
 SCALE: 1" = 200 PRIOR INSTRUMENT: 20070197676