
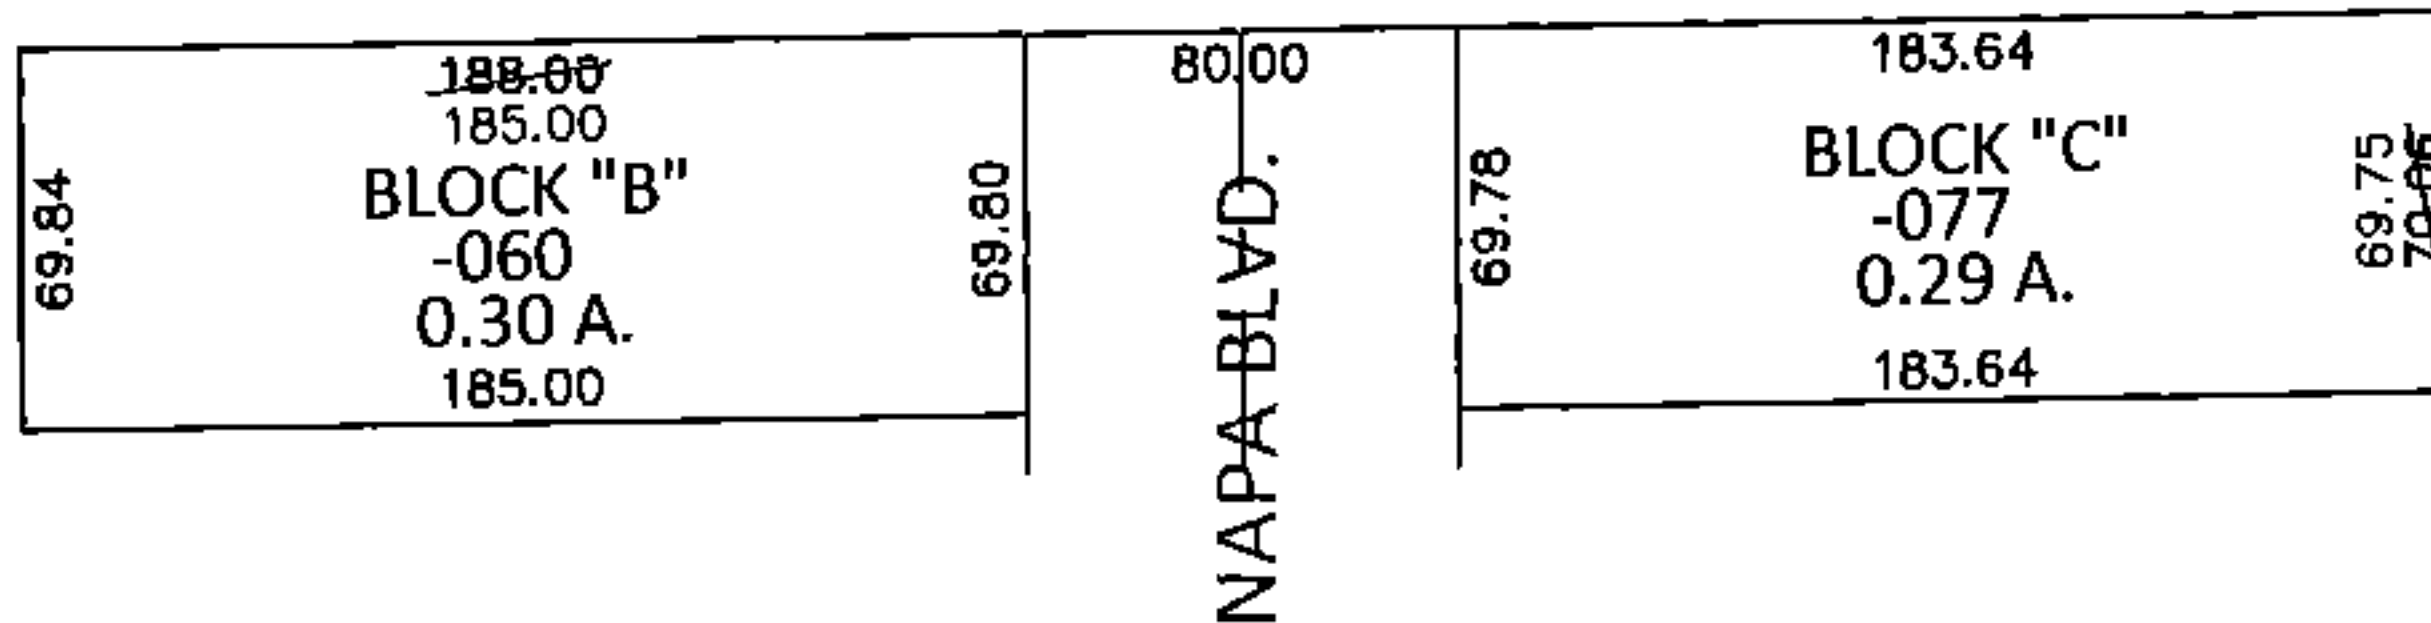


PARENT PARCEL: 04-00-026-108-077, 04-00-026-103-060

CHILD PARCEL: _____

STARTING POINT: _____

14-02891-C

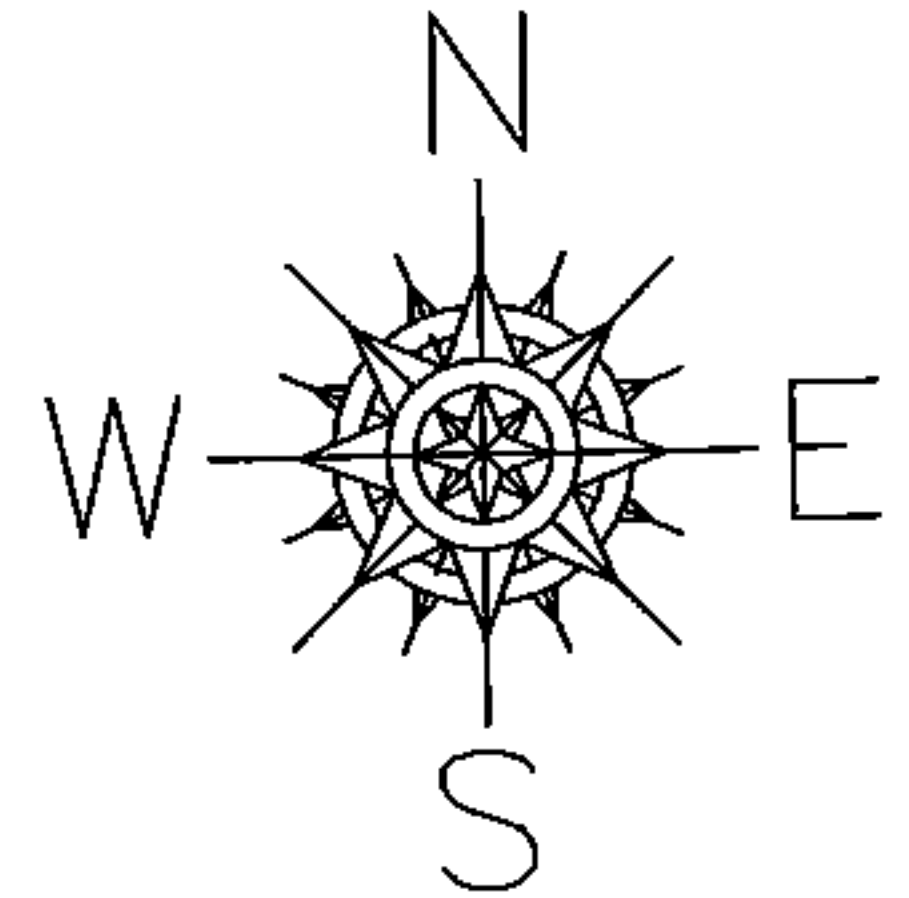

DIMENSION CORRECTION


04-00-026-108-077

04-00-026-103-060

CORRECTING NAPA SUBDIVISION NO.1

PLAT VOL.87 PG.74

PER CERTIFICATE OF CORRECTION

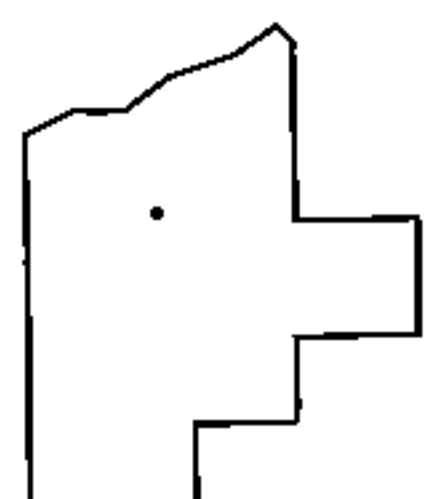

SPLITS/DEEDS PROCESSED

LORAIN COUNTY TAX MAP DEPARTMENT
226 MIDDLE AVE. ELYRIA, OHIO

SURVEYED BY: MICHAEL P. SPELLACY

CLOSURE: .01:10,000

MAP PAGE(S): 4-00-026-B

APPROVED BY: RRM DATE: 5-13-14

SCALE: 1"= 100 PRIOR INST.: PLAT 87/74