
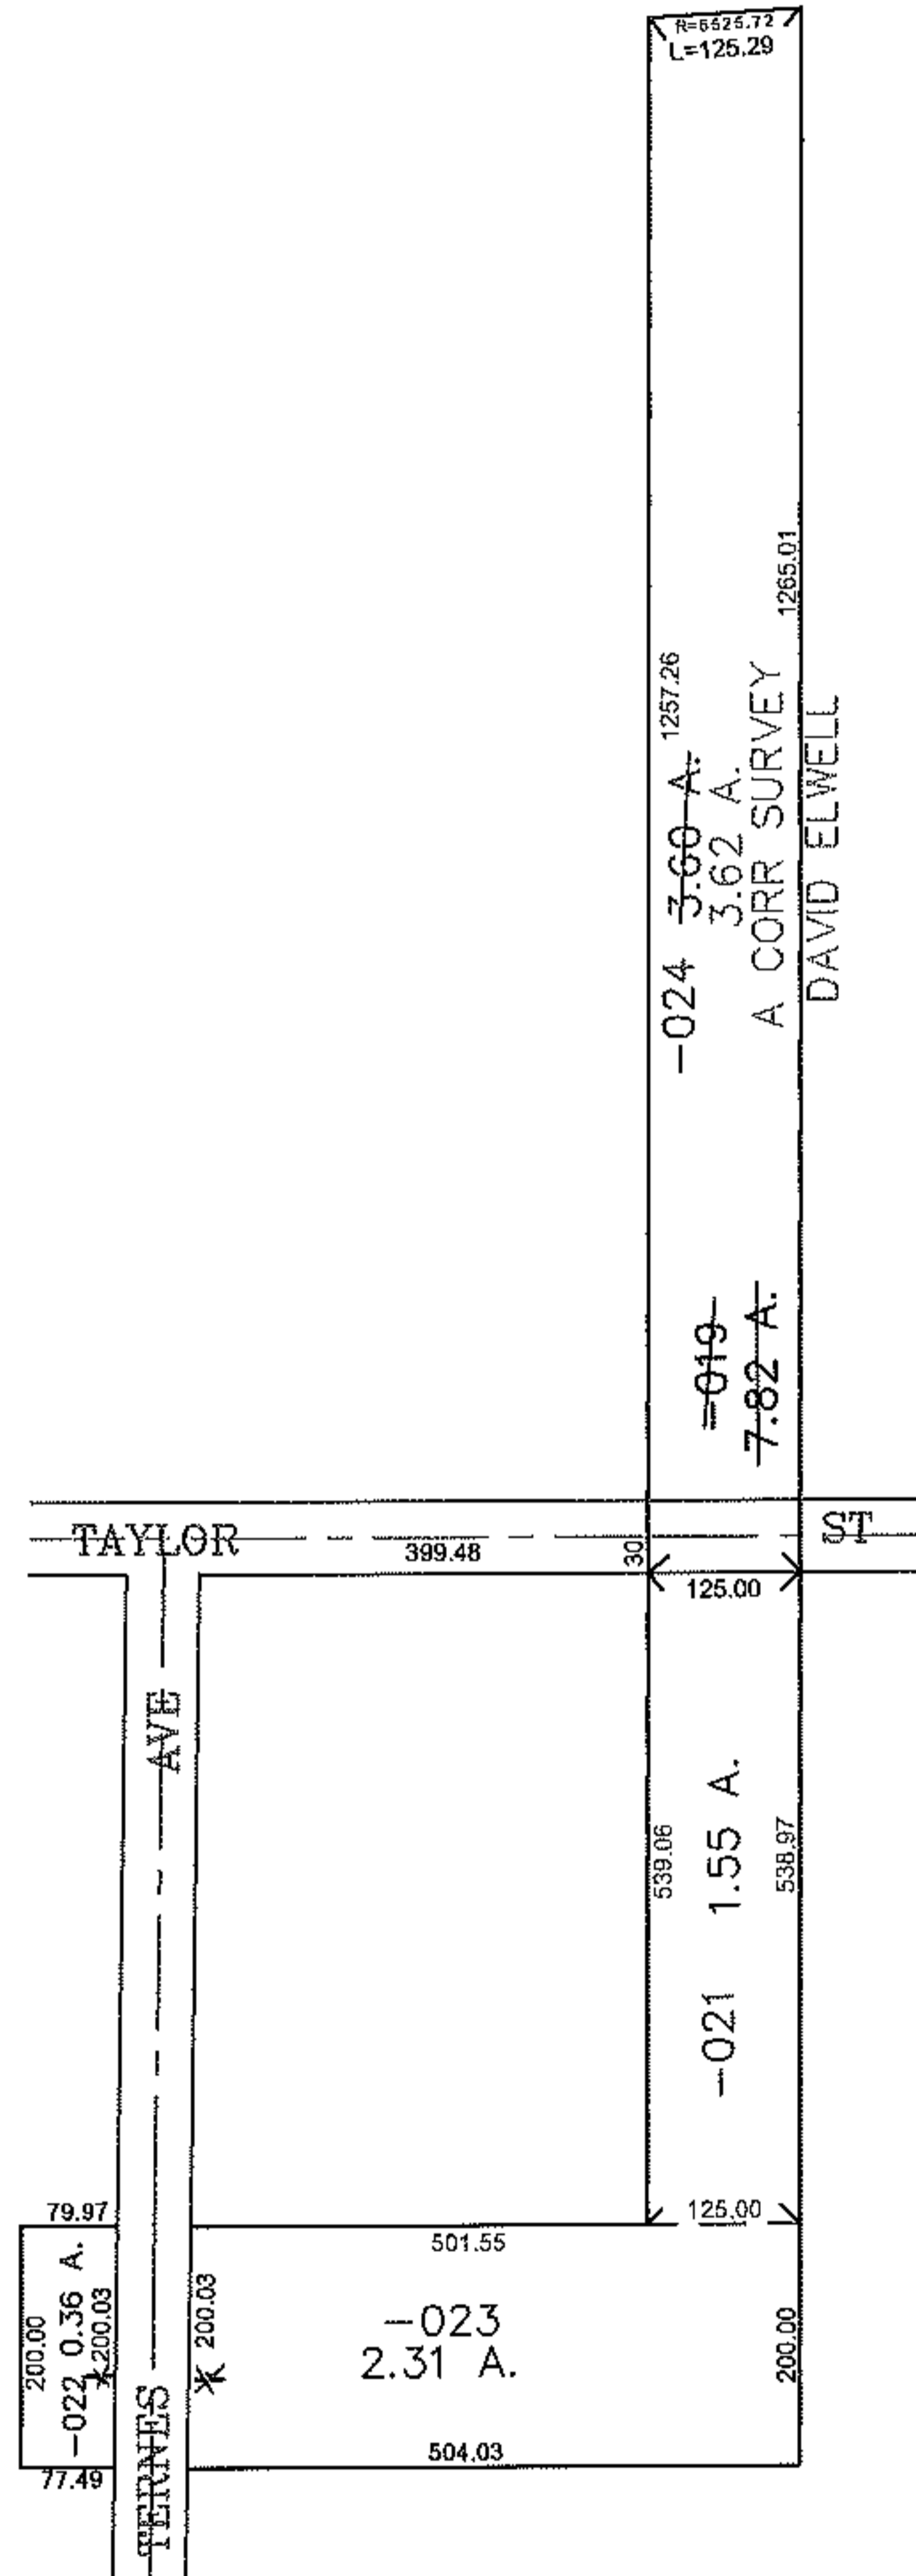


PARENT PARCEL: 06-25-008-000-019

CHILD PARCEL: 06-25-008-000-021 THRU -024

STARTING POINT: CENTERLINE OF TAYLOR ST & TERNES AVE

11-02892

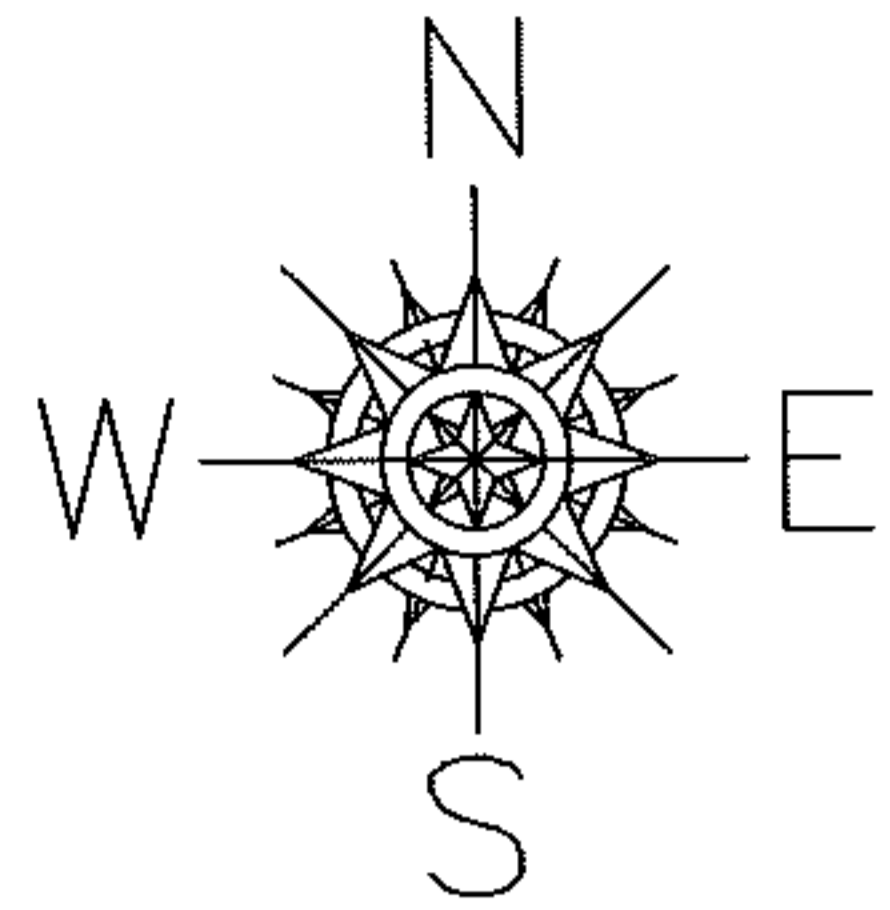

**SPLITS/DEEDS PROCESSED**

LORAIN COUNTY TAX MAP DEPARTMENT  
226 MIDDLE AVE. ELYRIA, OHIO

SURVEYED BY: DAVID ELWELL

CLOSURE: 0.00 : 10,000

MAP PAGE(S): 6-108

APPROVED BY: JAH DATE: 1-7-2011

SCALE: 1" = 300 PRIOR INSTRUMENT: DV 843/433