




RASTER

PARENT PARCEL: 09-00-084-105-068, -067

CHILD PARCEL: 09-00-084-105-098, -099

STARTING POINT: CENTERLINE OF GLENHURST DR & WOODHAVEN PL

11-02893

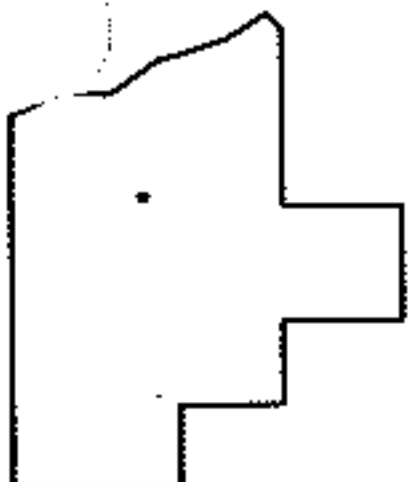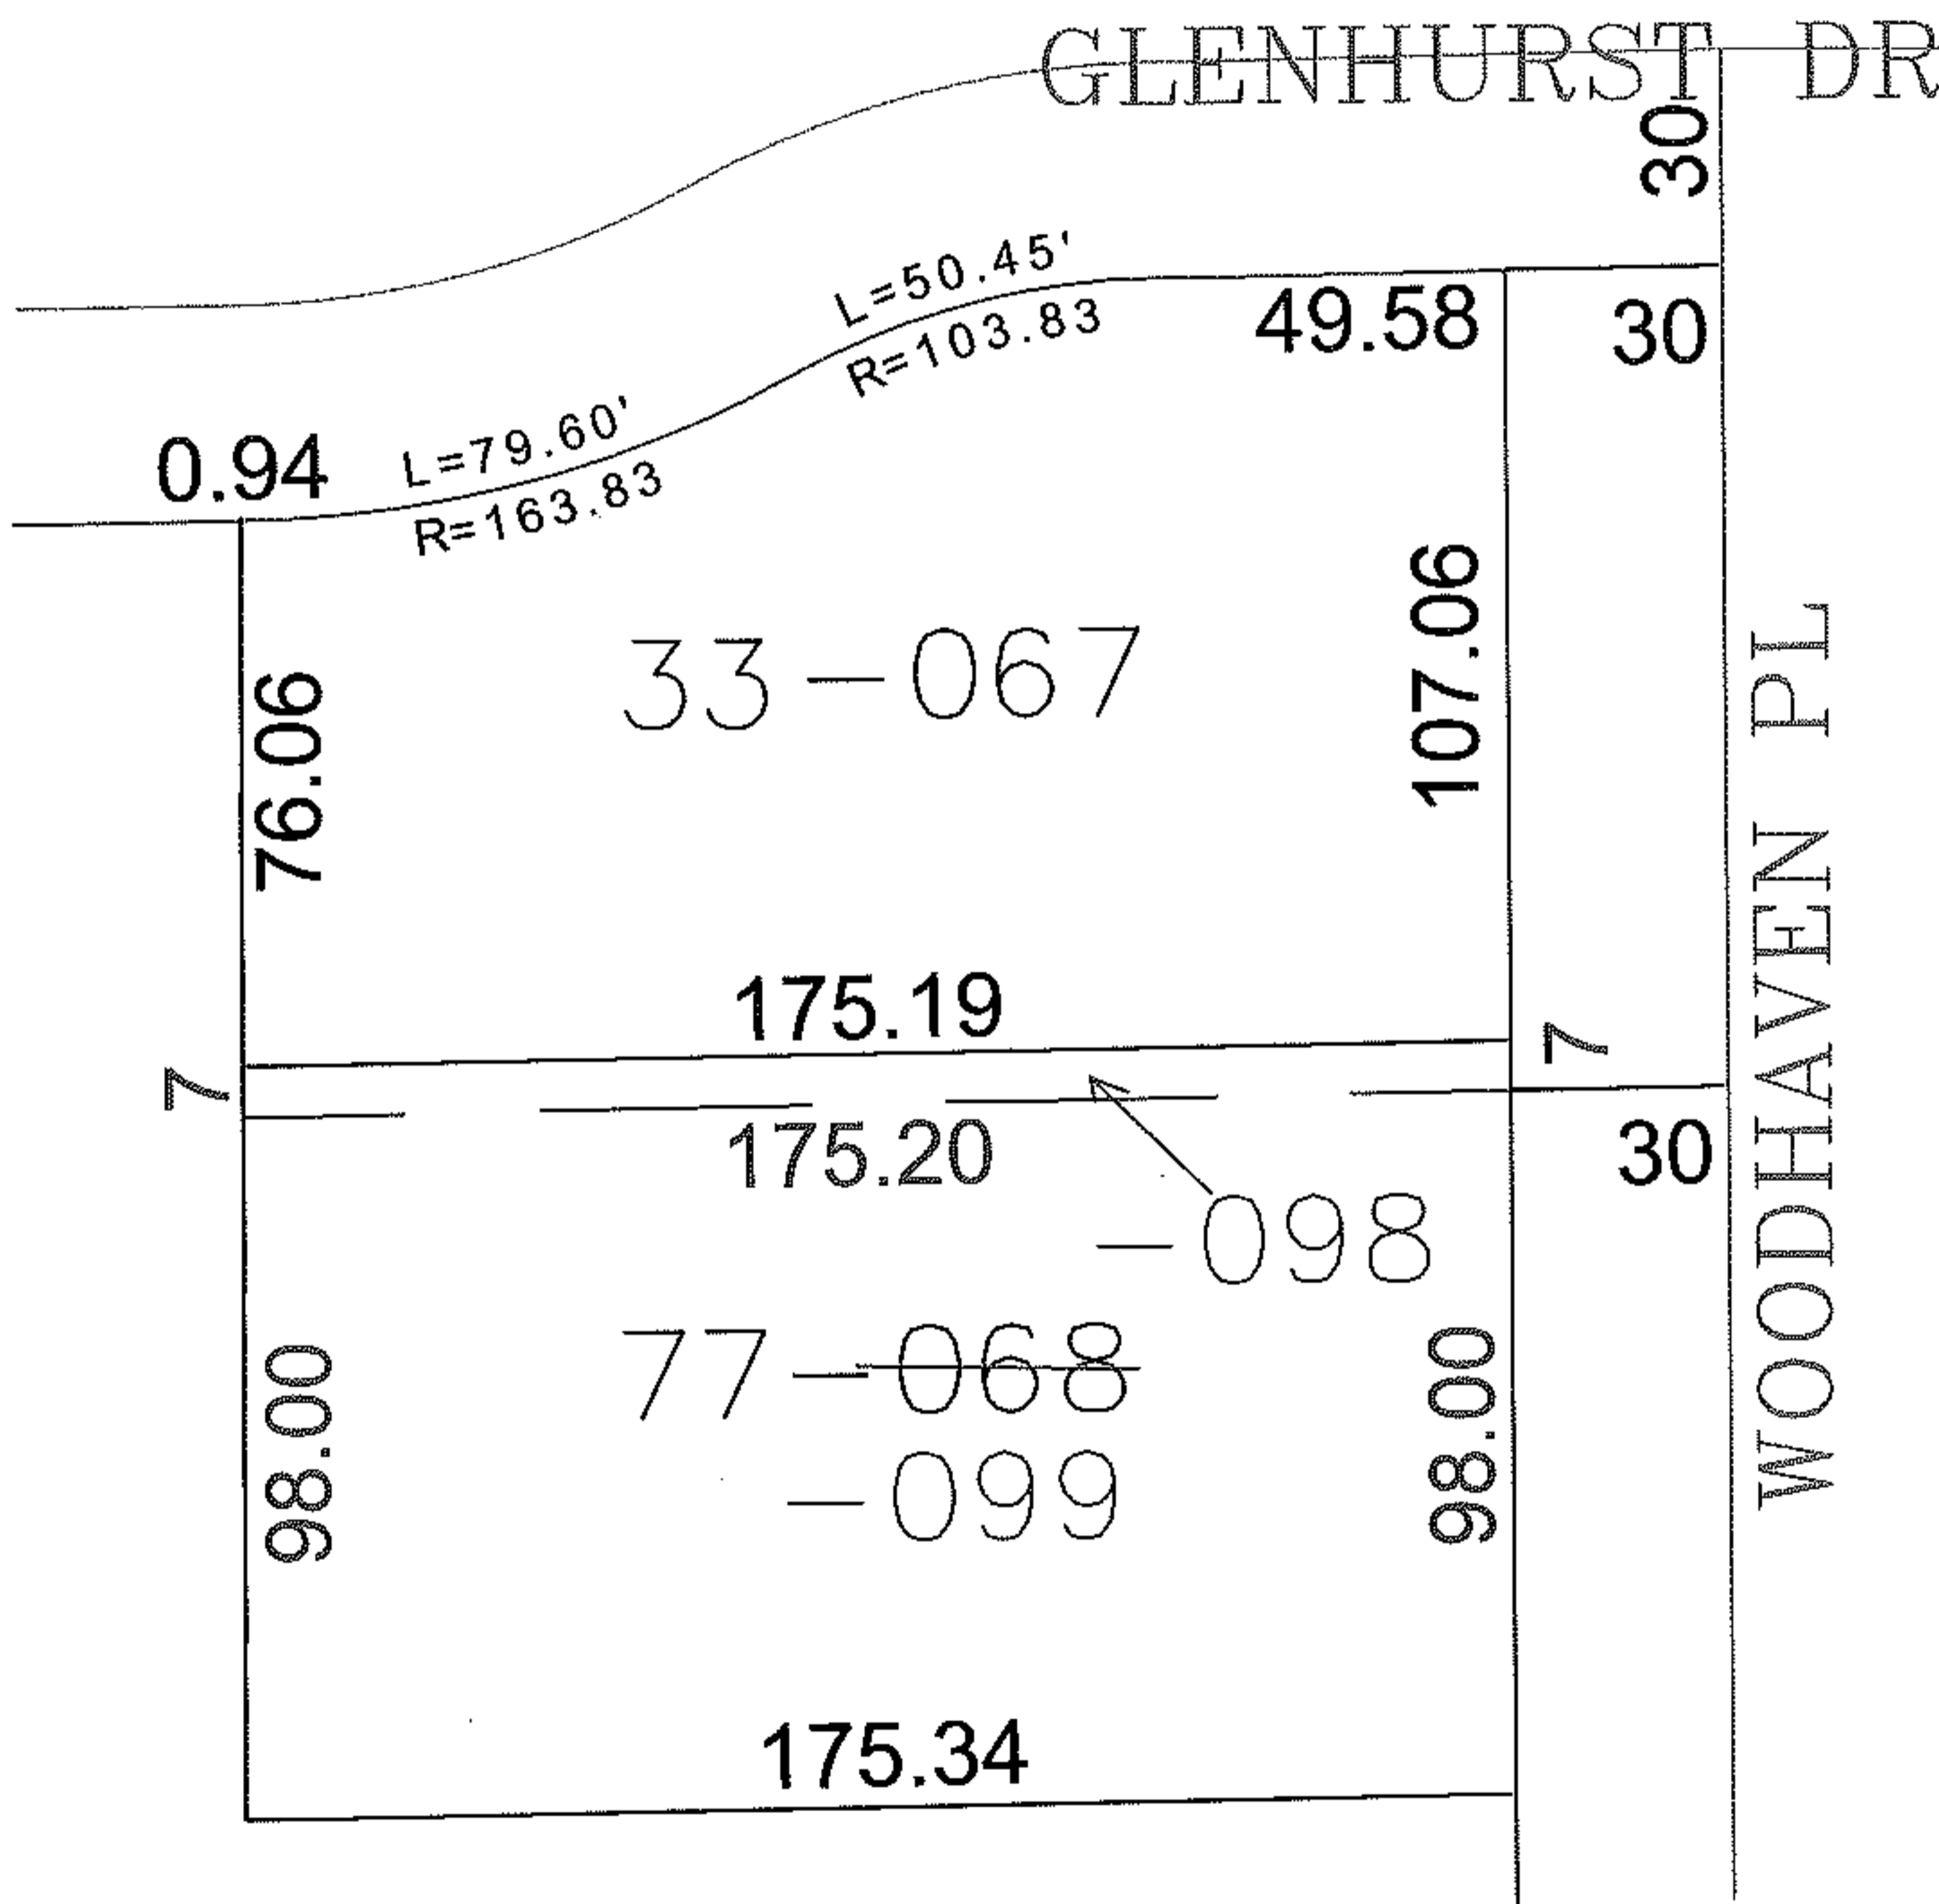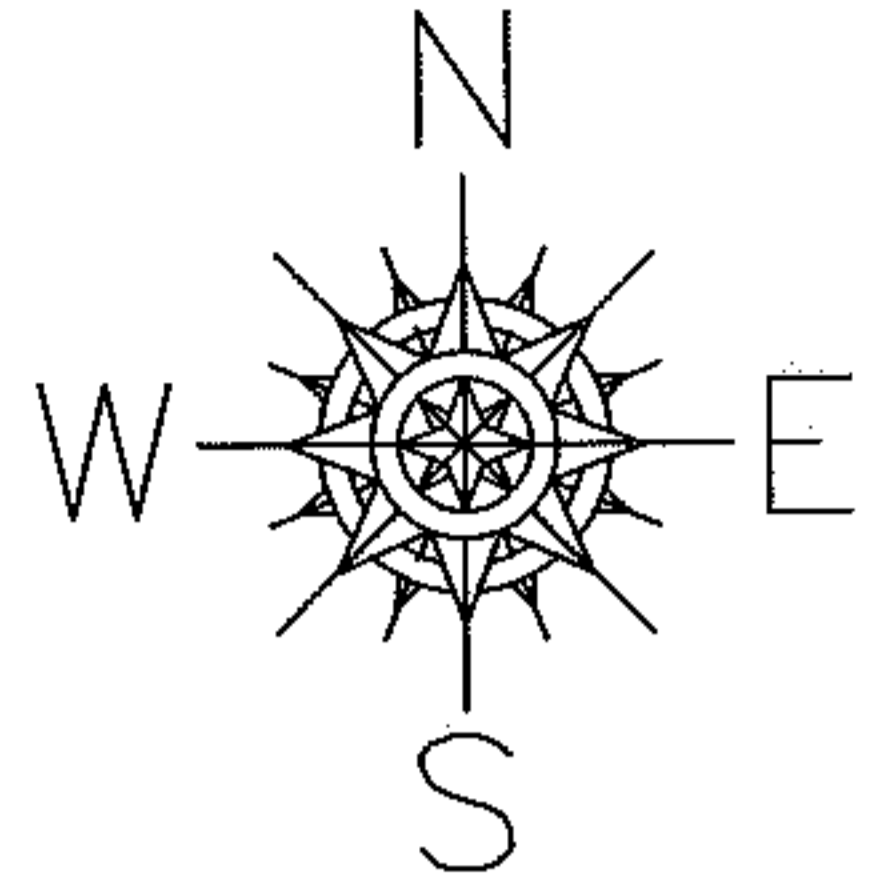

**SPLITS/DEEDS PROCESSED**

LORAIN COUNTY TAX MAP DEPARTMENT  
226 MIDDLE AVE. ELYRIA, OHIO

SURVEYED BY: THOMAS SIMON

CLOSURE: 0.00 : 10,000

MAP PAGE(S): 09-00-084-A

APPROVED BY: JAH DATE: 1-11-2011

SCALE: 1"= 50' PRIOR INST.: 20040009026