
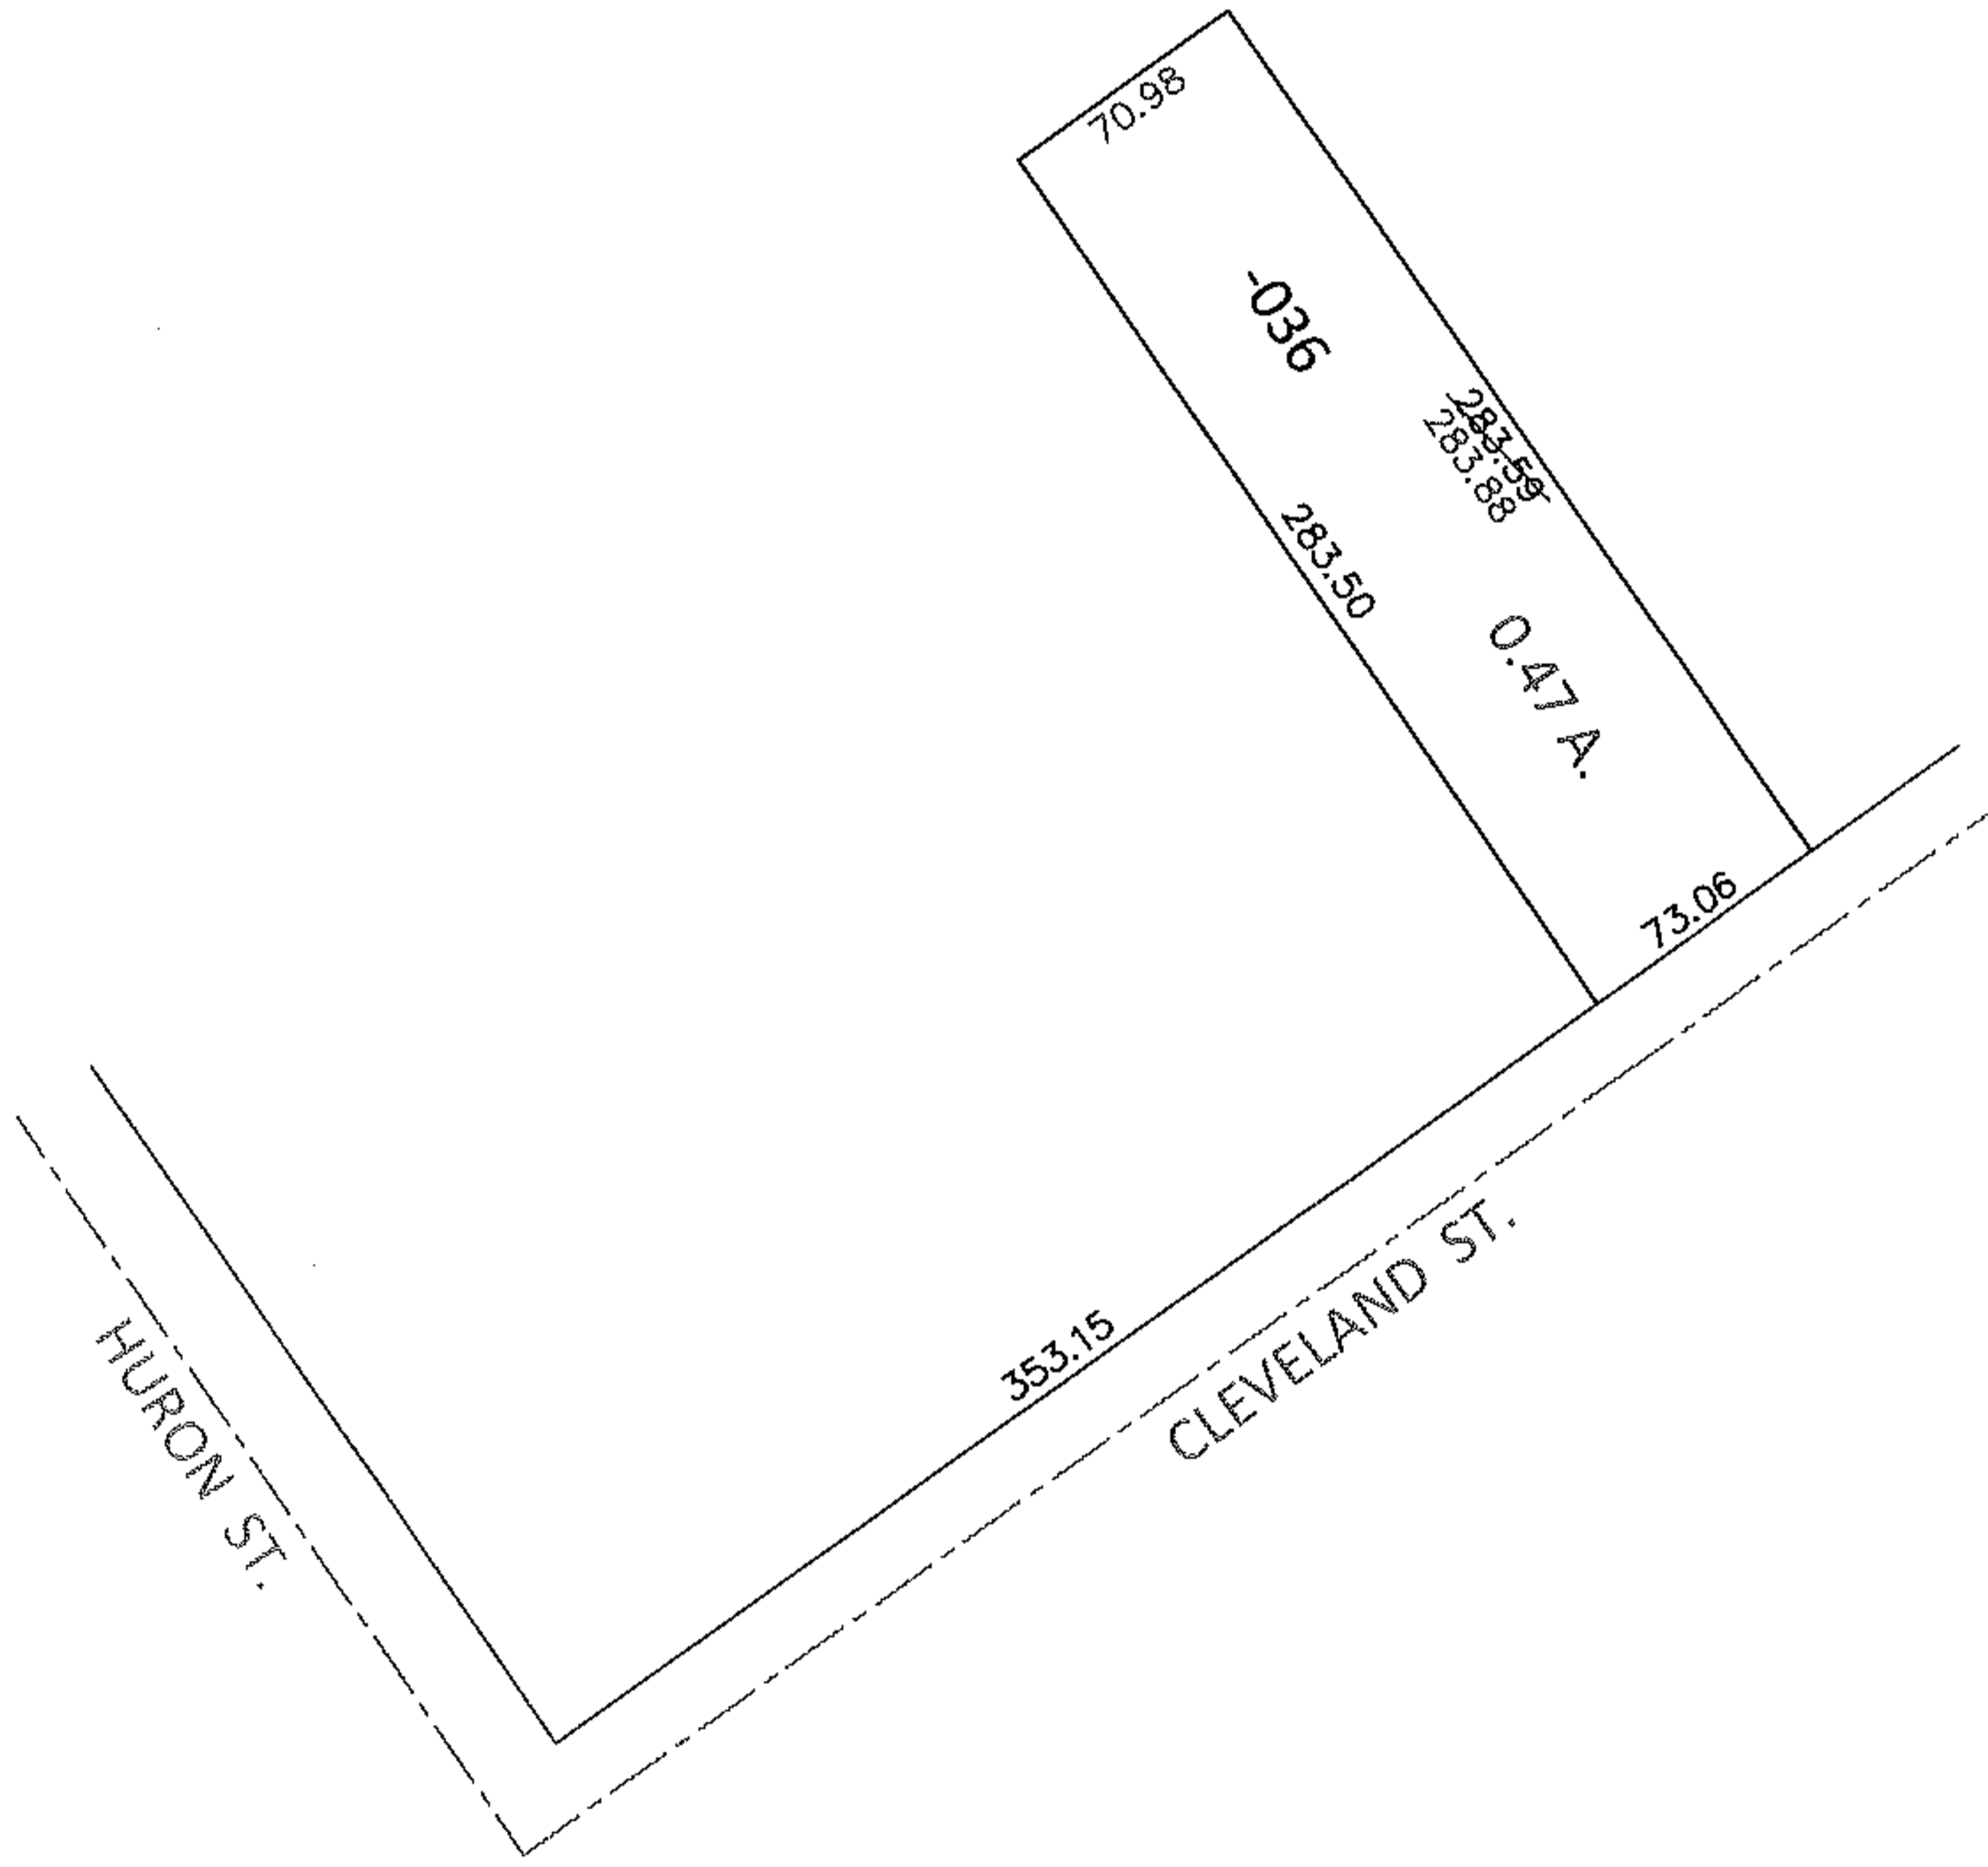


PARENT PARCEL: 11-00-081-102-036

CHILD PARCEL: _____

STARTING POINT: INTERSECTION OF NORTH LINE OF CLEVELAND ST. AND EAST LINE OF HURON ST.

14-02894-D

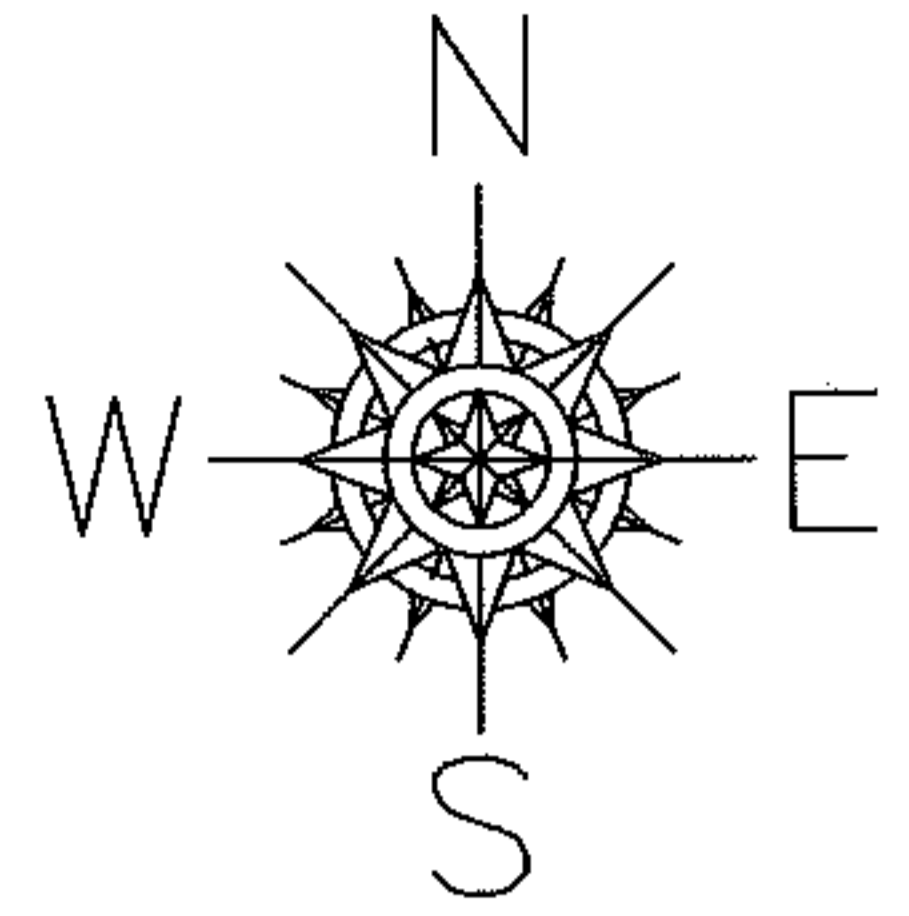


FRONTAGE AND DEPTH TO ACREAGE CORRECTION

11-00-081-102-036

0.47 A.

~~73.06 X 283.59~~

PER SURVEY BY D.HAYWOOD

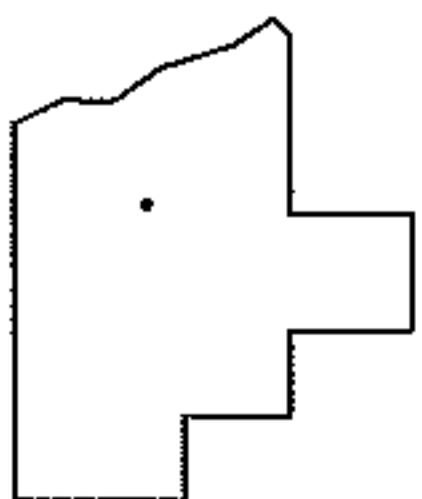

SPLITS/DEEDS PROCESSED

LORAIN COUNTY TAX MAP DEPARTMENT
226 MIDDLE AVE. ELYRIA, OHIO

SURVEYED BY: DALE R. HAYWOOD

CLOSURE: .01:10,000

MAP PAGE(S): 11-00-081

APPROVED BY: RRM DATE: 2-25-14

SCALE: 1"= 100 PRIOR INST.: 20130488247