
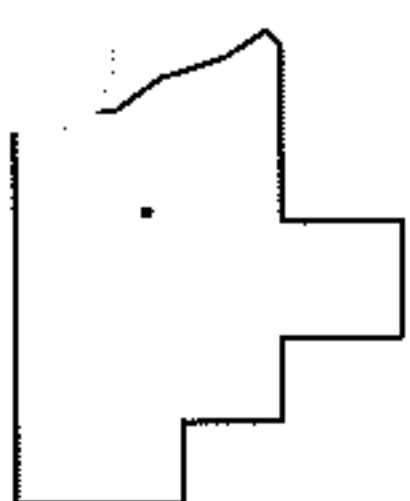
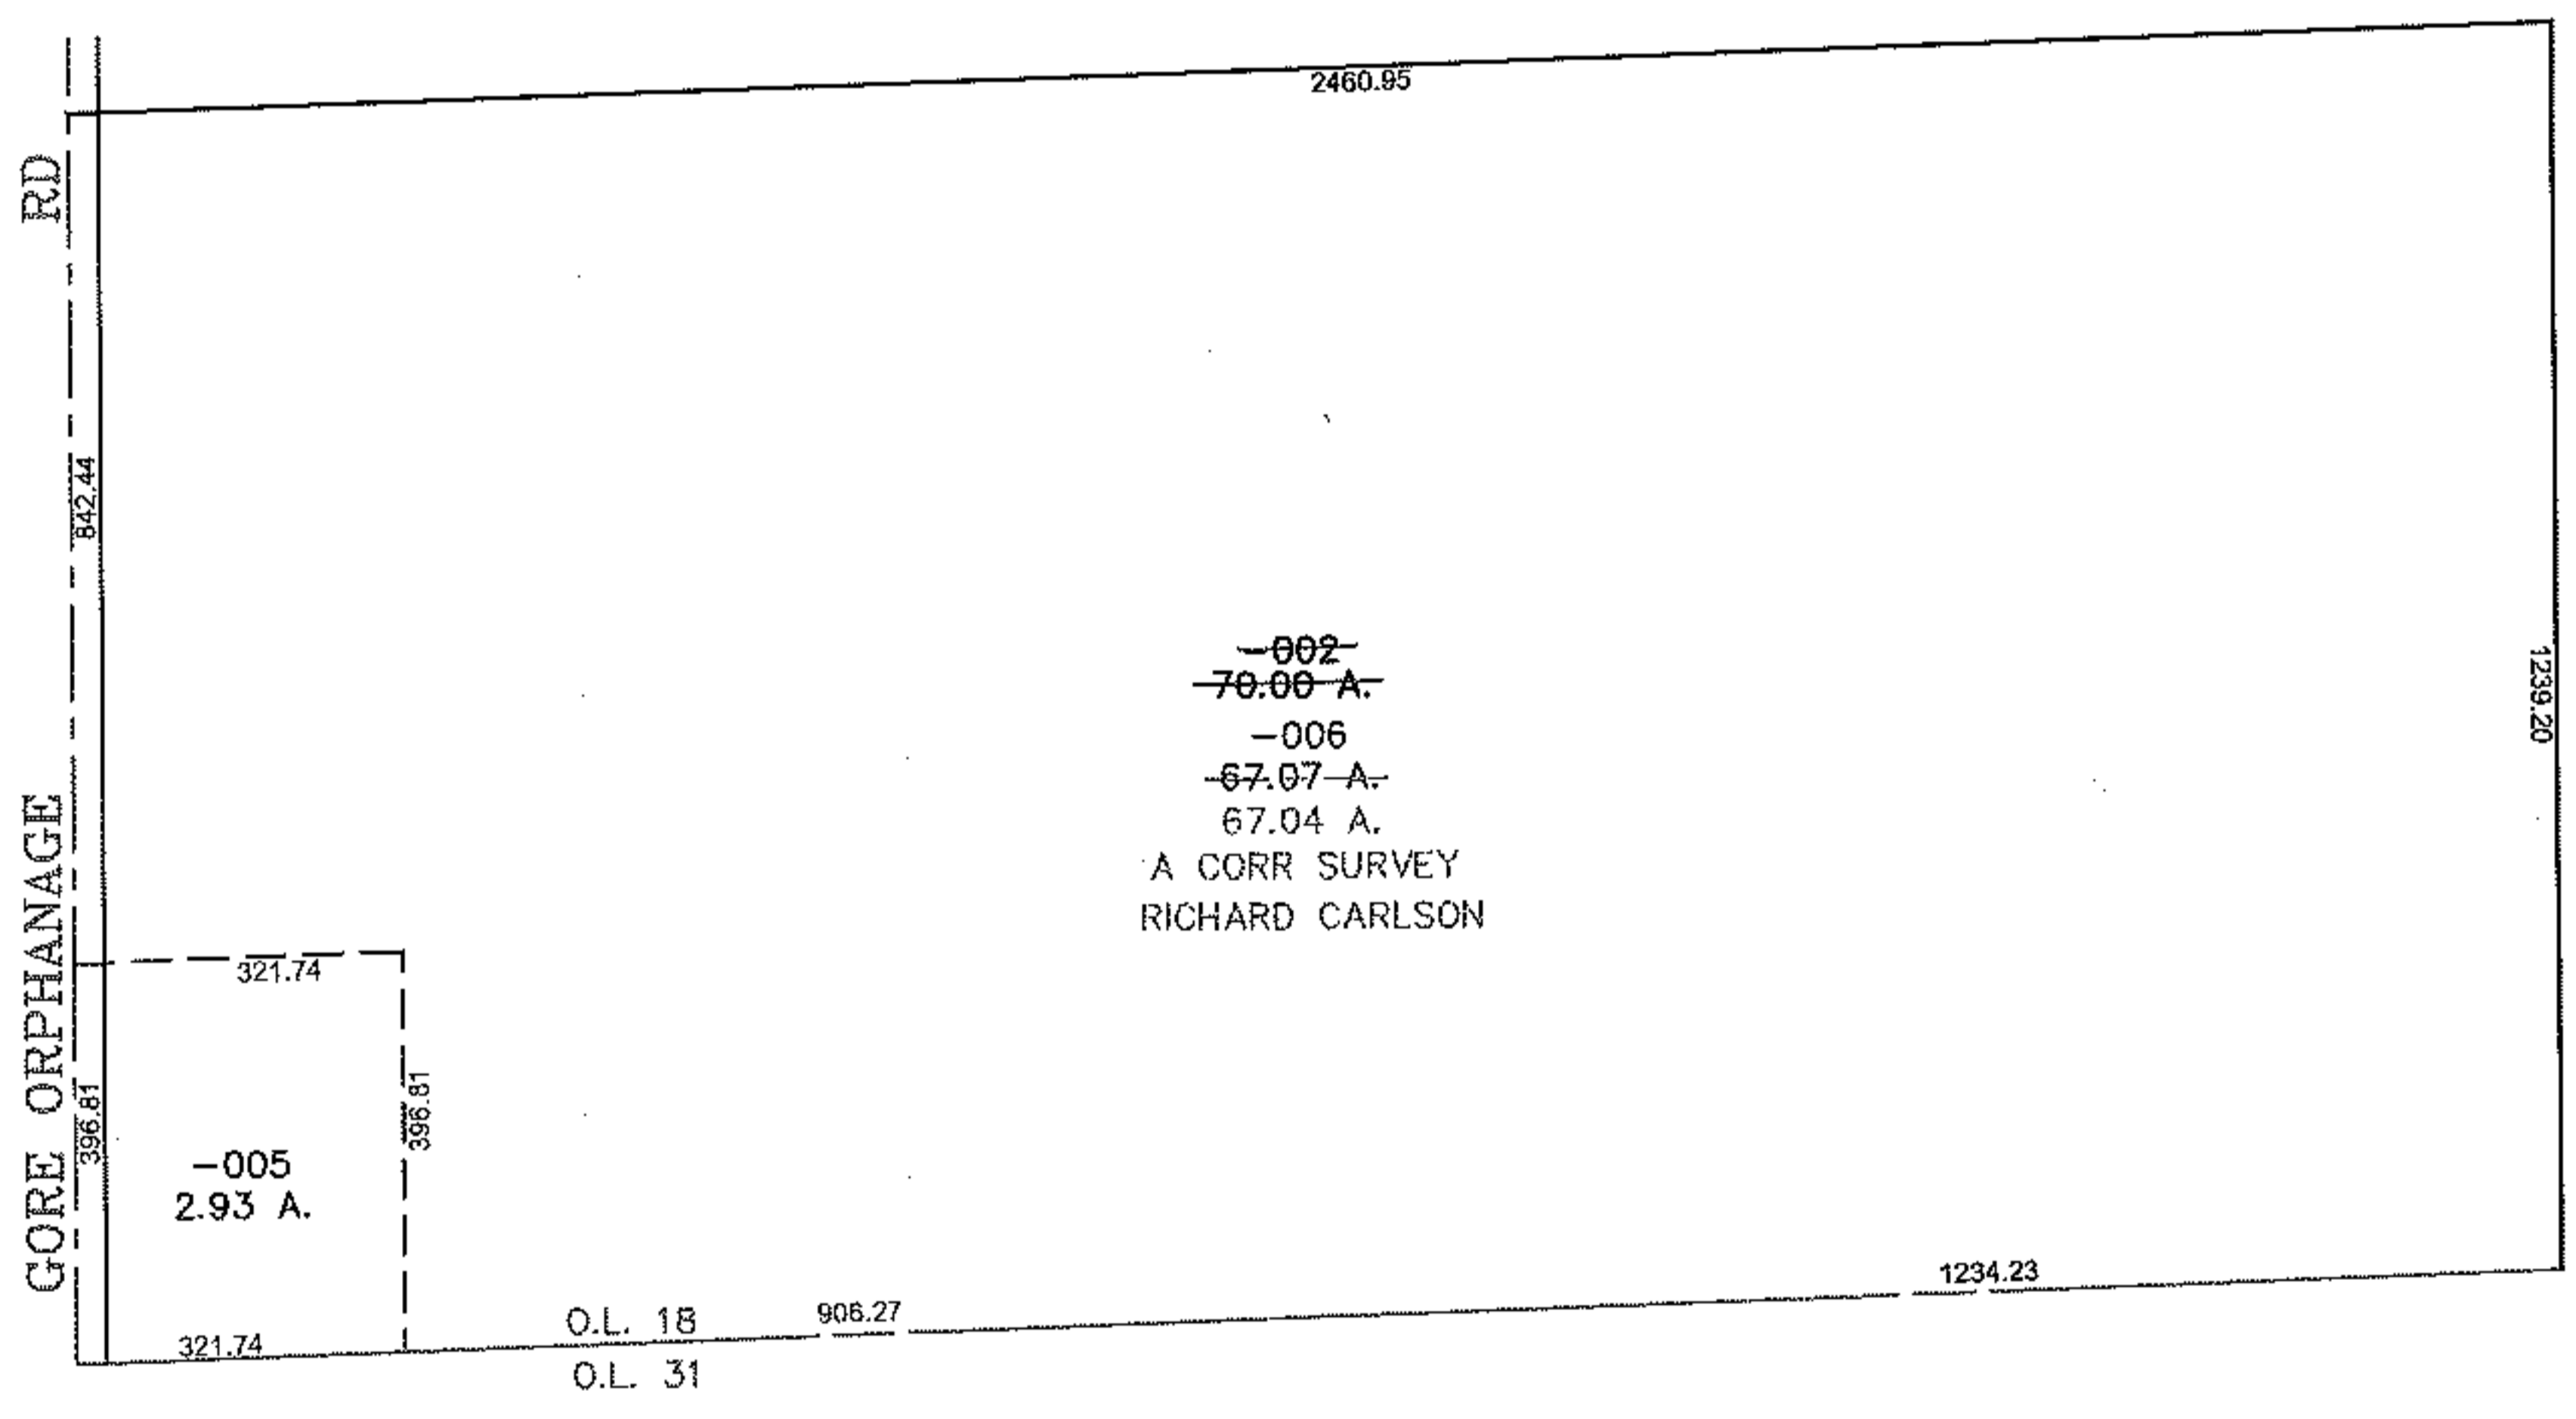


PARENT PARCEL: 13-10-018-000-002  
CHILD PARCEL: 13-10-018-000-005, -006  
STARTING POINT: CENTERLINE OF GORE ORPHANAGE RD & O.L. 18

11-02894

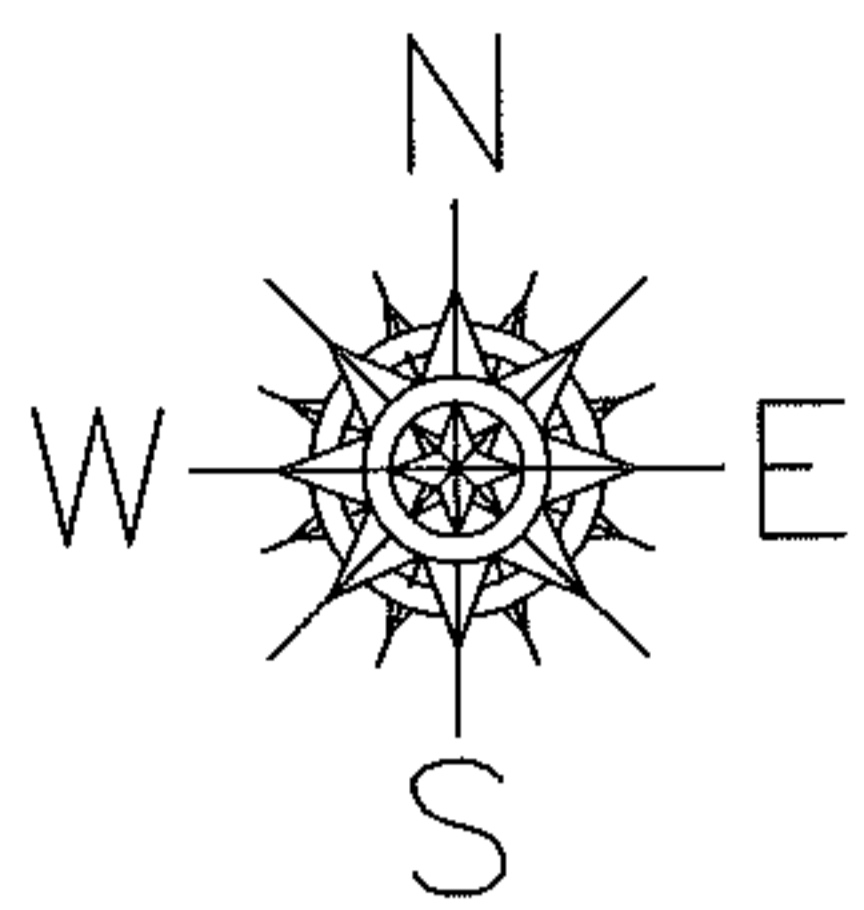

**SPLITS/DEEDS PROCESSED**  
LORAIN COUNTY TAX MAP DEPARTMENT  
226 MIDDLE AVE. ELYRIA, OHIO

SURVEYED BY: RICHARD CARLSON  
CLOSURE: 0.00 : 10,000  
MAP PAGE(S): 13-A  
APPROVED BY: JAH DATE: 1-25-2011  
SCALE: 1" = 400 PRIOR INST.: OR 1410/3